FRED & ARLENE REID

# IREDELL COUNTY HEALTH DEPARTMENT

THIS PERMIT VOIDS PREVIOUS ISSUED 3/29/95

STATESVILLE 704-878-5305 MOORESVILLE 704-664-5281

## IMPROVEMENT PERMIT / AUTHORIZATION TO CONSTRUCT / OPERATION PERMIT / EXISTING SYSTEM INSPECTION

PERMIT# 19687 07168 PIN# PART OF TAX MAP # 8R-A-1 DATE 1-26-98

OWNER OR CONTRACTOR KEJ MARKETING / RICK NORWOOD PHONE: Business RICK NORWOOD 313-0596 Home FAX 313-3198

ADDRESS P.O. BOX 1627, MATTHEWS, NC 28106

LOCATION I-40 W, TR SHARON SCHOOL ROAD, TL STEWART ROCK DR, TL RIVERWALK DRIVE, LOT ON LEFT AT CUL-DE-SAC

SUBDIVISION RIVERWALK BLOCK / SECTION I LOT 19 LOT AREA 0.6662 ACRE SITE CLASS. PS DESIGN FLOW 360 L.T.A.R. 0.25 GPD/FT²

Septic Tank: 1000 Gallons; STB 421 Date 1-14-98

Pump Tank: 1000 Gallons; PT 40 Date 1-1-98

Pump Make: Hydromatic Model SHEF50A1 Serial No. 5196 7087

Nitrification Field: No Fields 1 Square Feet EQ TO 1200 Linear Feet 240

No Lines SIX Trench Width 24" Max Trench Bottom Depth 36" ~~Gravel~~ Depth SAND 6"

☑ New System ☐ Repair System Type: I, II, (III) IV, V, VI

System Description: PPBPS PUMP-FED

Repair System Description: PPBPS PUMP-FED

Maintenance Agreement Required: ☐ Yes ☑ No

☑ House/Mod. Home No. Bedrooms 3

☐ Mobile Home No. Bathrooms ___

☐ Business No. Employees ___

☐ Other ___


☐ Slab ☐ Crawl Space ☒ Basement w/plumbing ☐ Basement wo/plumbing

Water Supply: ☑ Individual ☐ Public ☐ Community WELL


Comments:/Conditions: ① INSTALL 54 PPBPS PANELS IN SIX EQUAL LENGTH LINES ② KEEP SYSTEM 25' FROM BASEMENT DRAIN, 50' FROM WELL, 100' FROM WATER 838.0' CONTOUR, 50'+ FROM ③ SEE ATTACHED SHEETS FOR PUMP & PRESSURE MANIFOLD REQUIREMENTS.

Comments:/Conditions: 3-4-98 Checked lines not Piping, Tanks

INITIAL SITE SKETCH

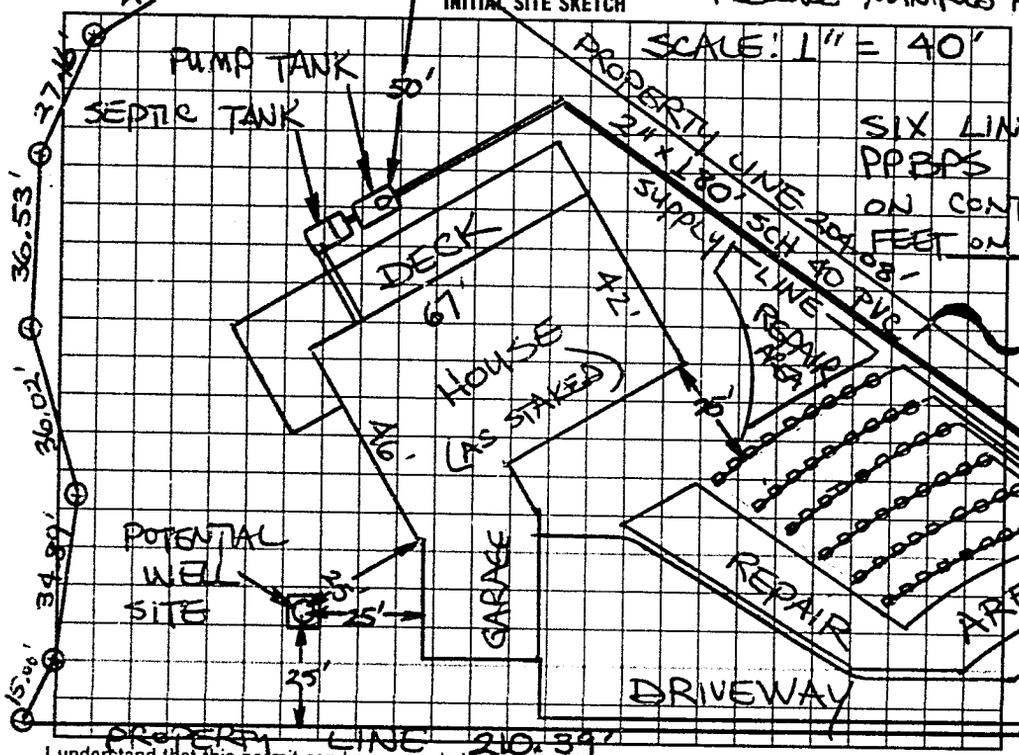


AS BUILT SKETCH

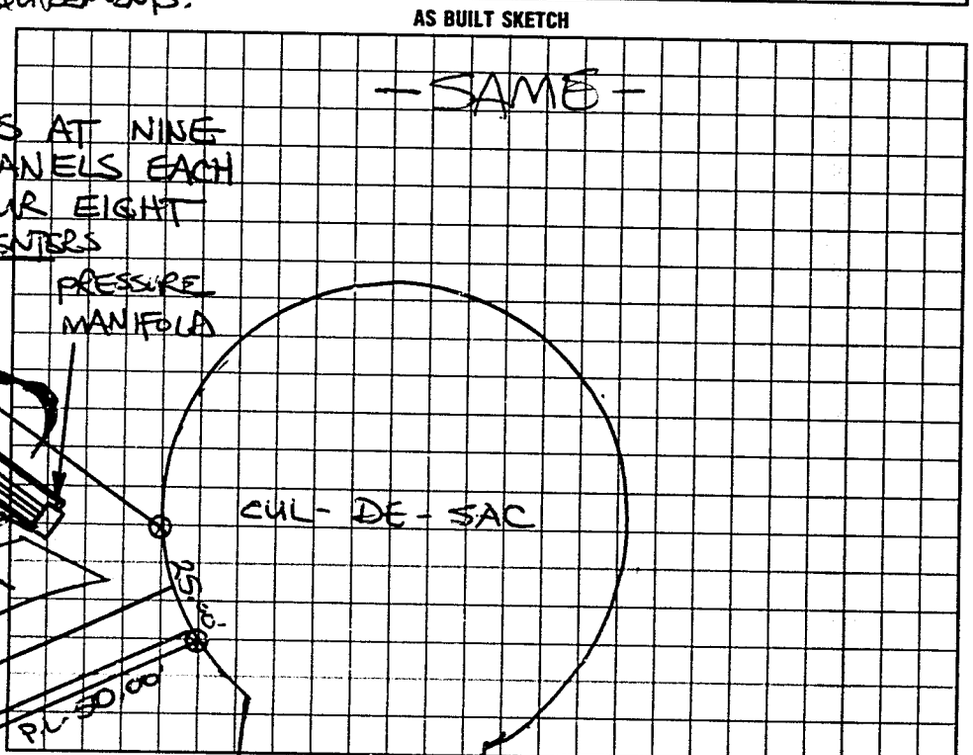


I understand that this permit can be suspended or revoked if any false information is supplied toward securing the permit/any unauthorized changes are made to the site/any unauthorized changes are made in the installation of the system. Improvement Permit with plat valid without expiration. Improvement Permit with site plan valid for sixty months. Authorization to Construct is valid for a period equal to that of Improvement Permit – not to exceed sixty months.

Signed: Richard J Norwood date ___

Improvement Permit by: STEVE HEDRICK date 1-26-98

Authorization to Construct by: STEVE HEDRICK date 1-26-98

Installed by: RICK NORWOOD CONST.

Operation Permit by: STEVE HEDRICK date 11-25-98

Existing System Inspection by ___ date ___

HEALTH DEPT. COPY WHITE | INSPECTING COPY (PINK) GREEN | OWNER COPY (PINK) YELLOW | INSPECTION COPY (PINK) PINK | OWNER COPY (PINK) GOLD