THIS PERMIT VOIDS PREVIOUS ISSUED 6-22-96

IREDELL COUNTY HEALTH DEPARTMENT

STATESVILLE 704-878-5305 MOORESVILLE 704-664-5281

IMPROVEMENT PERMIT / AUTHORIZATION TO CONSTRUCT / OPERATION PERMIT / EXISTING SYSTEM INSPECTION

DATE 7-31-01

PERMIT# 089094 PIN# 3774 62 4367 PHONE: Business (336) 758-5053 home (336) 760-1246

OWNER OR CONTRACTOR GARY L. SHOESMITH

ADDRESS 5188 CLEARVIEW DRIVE, WINSTON-SALEM, NC 27104

LOCATION I-40 W, TR SHARON SCH. RD, TL STEWART ROCK RD, TL FULBRIGHT RD, TR GARDNER POINT, TR RIVERCLIFF, LOT AT END ON

SUBDIVISION RIVERWALK BLOCK / SECTION IV LOT 34 LOT AREA 0.878 ACRE SITE CLASS PS DESIGN FLOW 360 L.T.A.R. 0.20 GPD/FT²

2X Septic Tank: 1000 GAL Gallons: STB _____ Date _____

Pump Tank: 1000 Gallons: PT _____ Date _____

Pump Make _____ Model _____ Serial No. _____

Nitrification Field: No Fields 1 Square Feet 69 per 1800 Linear Feet 300

No Lines SEVEN Trench Width 24" Max Trench Bottom Depth 36" Gravel Depth SAND 6"

☐ New System ☐ Repair System Type: I, II, III, IV, V, VI

System Description: LOW PRESSURE PFBPS

Repair System Description LOW PRESSURE PFBPS @0.2GPD/FT²

Maintenance Agreement Required: ☑ Yes ☐ No

☑ House/Mod. Home No. Bedrooms 3

☐ Mobile Home No. Bathrooms 3

☐ Business No. Employees _____

☐ Other _____


☐ Slab ☐ Crawl Space ☑ Basement w/plumbing ☐ Basement wo/plumbing

Water Supply: ☑ Individual ☐ Public ☐ Community WELL


Comments:/Conditions ① INSTALL 50% REDUCTION SYSTEM USING 70 PFBPS PANELS AS SHOWN ② SEE ATTACHED SHEETS FOR PUMP & PRESSURE MANIFOLD REQUIREMENTS ③ KEEP SYSTEM & REPAIR AREA MINIMUM 100' FROM WELL (.1956(6)(g)) ④ A CONTRACT SHALL BE EXECUTED WITH A MANAGEMENT ENTITY PRIOR TO ISSUANCE OF AN OPERATION PERMIT.

Comments:/Conditions:

INITIAL SITE SKETCH

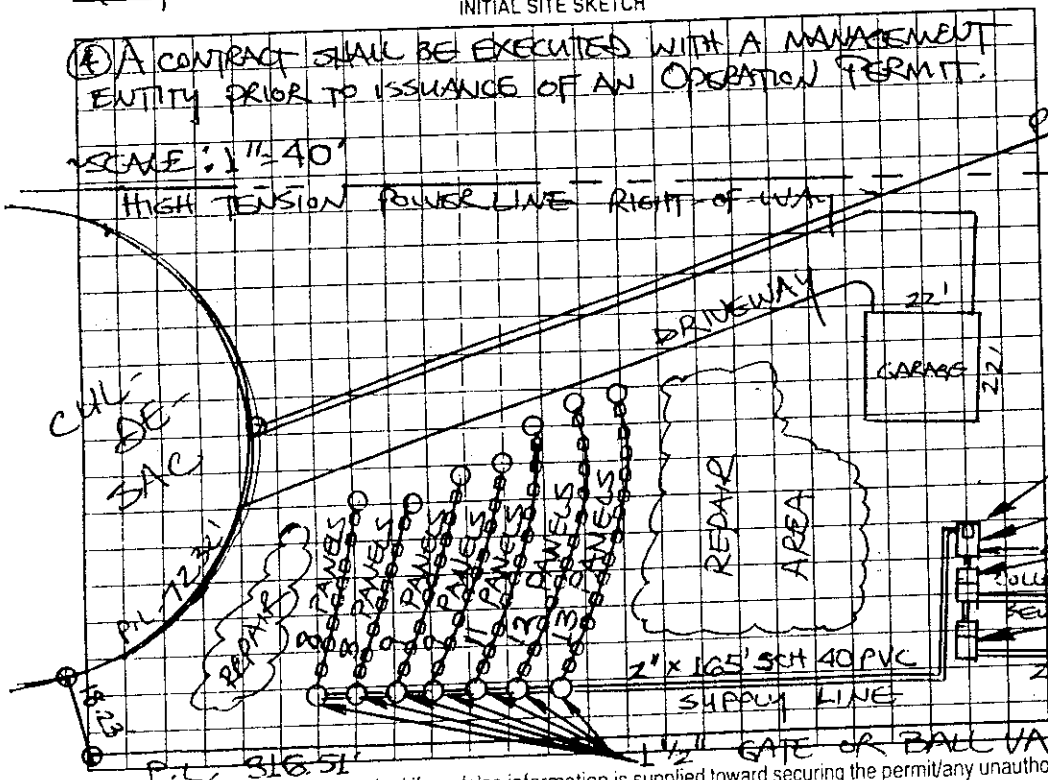

AS BUILT SKETCH

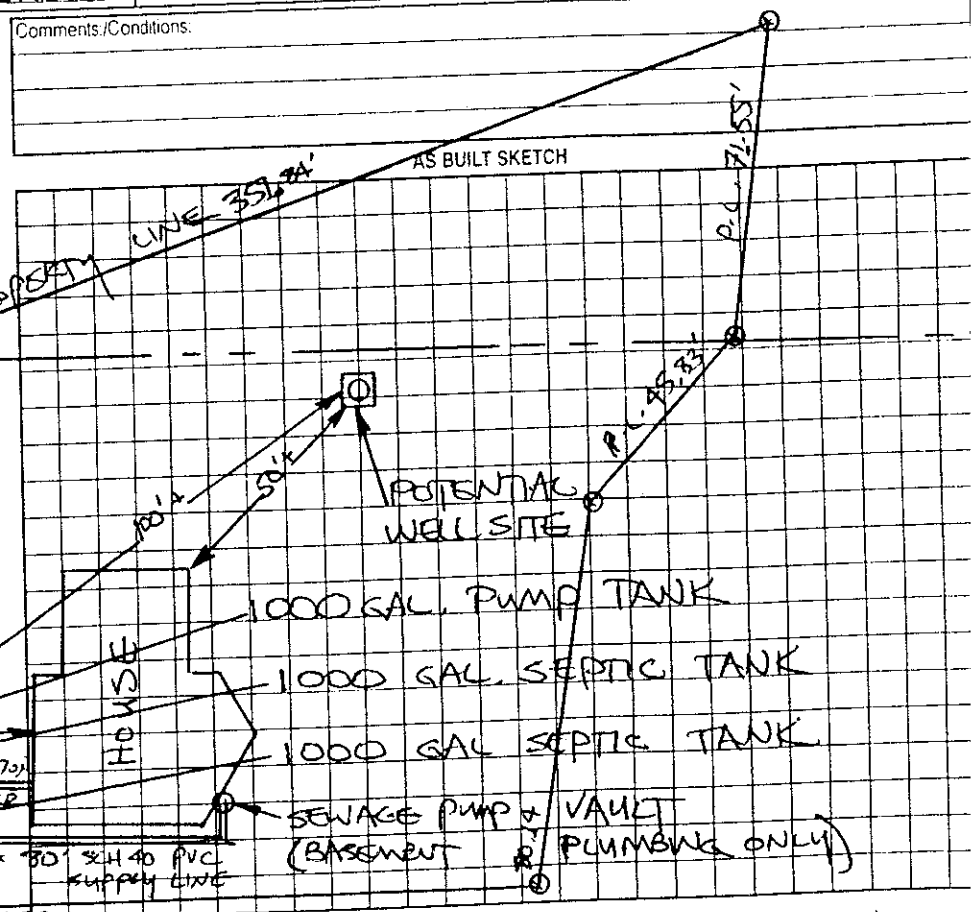

Permit can be suspended or revoked if any false information is supplied toward securing the permit/any unauthorized changes are made to the site/any unauthorized changes are made in the installation of the system. Improveme

Permit with plat valid without expiration. Improvement Permit with site plan valid for sixty months. Authorization to Construct is valid for a period equal to that of Improvement Permit – not to exceed sixty months.

Signed: _____ date 8-2-01

Improvement Permit by: STEVE HEDRICK date 7-31-01

Authorization to Construct by: STEVE HEDRICK date 7-31-01

Installed by: _____ date _____

Operation Permit by: _____ date _____

Existing System Inspection by: _____