3774-62-7191 John Counne

IREDELL COUNTY HEALTH DEPARTMENT

STATESVILLE 704-878-5305 MOORESVILLE 704-664-5281

IMPROVEMENT PERMIT / AUTHORIZATION TO CONSTRUCT / OPERATION PERMIT / EXISTING SYSTEM INSPECTION

PERMIT# 103784 PIN# 3774-62-7191 DATE 1/31/02

OWNER OR CONTRACTOR Wade Wilson PHONE: Business (828) 312-4798 Home —

ADDRESS 3965 Lake Shore Rd Denver N.C. 28037

LOCATION I40 W, (R) Sherrills Ford Rd, (L) Stewart Creek Rd, (L) Fairbrook (R) Overlook (R) Riverside, straight ahead at Stone Cliff

SUBDIVISION Riverwalk BLOCK / SECTION 7C LOT 31 LOT AREA 1.623 SITE CLASS. PS DESIGN FLOW 480' L.T.A.R. .25 gpd/ft²

Septic Tank: 1,000 Gallons; STB 1012 Date 12-31-01
Pump Tank: 1,000 Gallons; PT 17 Date 12-29-01
Pump Make: _____ Model _____ Serial No. _____
Nitrification Field: No Fields 1 Square Feet 1920 to _____ Linear Feet 320
No Lines 8 Trench Width 3' Max Trench Bottom Depth 36" Gravel Depth Sand - 6"


☒ New System ☐ Repair System Type: I, II, III, IV, V, VI
System Description: LP PPBPS
Repair System Description: LP PPBPS
Maintenance Agreement Required: ☒ Yes ☐ No

☒ House/Mod. Home No. Bedrooms 4
☐ Mobile Home No. Bathrooms 3
☐ Business No. Employees _____
☐ Other _____
☐ Slab ☐ Crawl Space ☒ Basement w/plumbing ☐ Basement wo/plumbing

Water Supply: ☒ Individual ☐ Public ☐ Community

Comments/Conditions: (1) Install 320' LP PPBPS with Control Control Value Box (2) If Supply line cross driveway use ductile iron or equivalent or install 30" below ground grade, (3) Install 73 panel with 53 lins of Sand (4) Signed Maintenance Contract must be

INITIAL SITE SKETCH

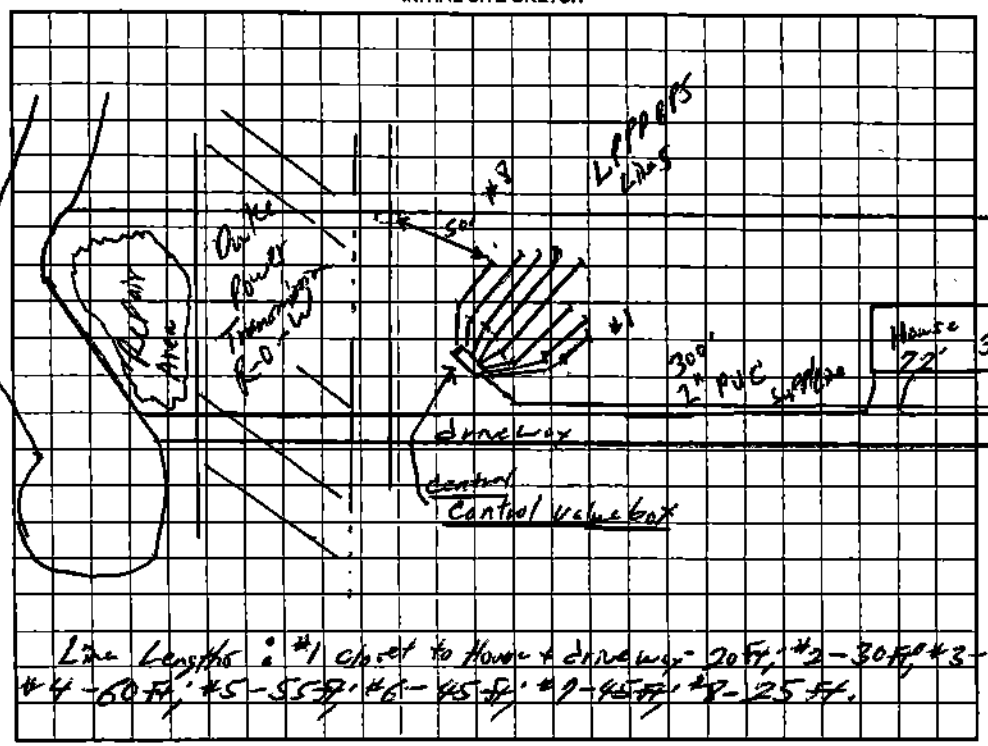


Line Lengths: #1 closest to House + driveway - 20 Ft; #2 - 30 Ft; #3 - 40 Ft; #4 - 60 Ft; #5 - 55 Ft; #6 - 45 Ft; #7 - 45 Ft; #8 - 25 Ft.

Comments/Conditions: Submitted before issuance O.P. (5) Install well 100 Ft From Septic System (6) Use 3/16 in Hole in pipe discharge (7) Keep System 15' From Top of Embankment (8) Maintain proper setbacks

- ST + PT Inspected 2/15

AS BUILT SKETCH

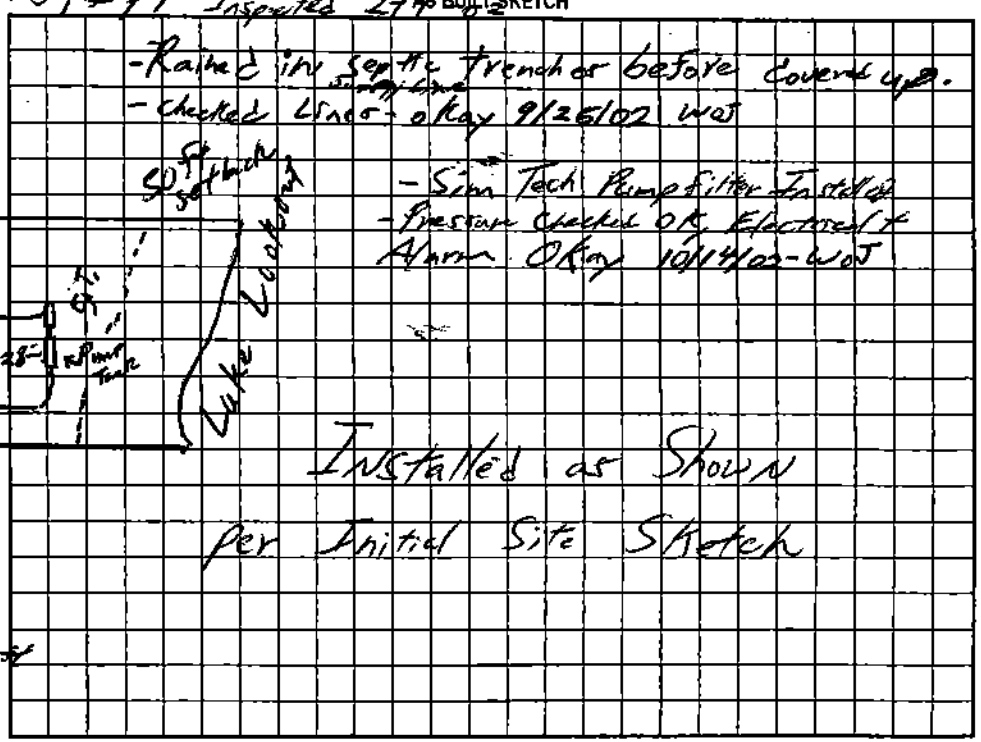

Permit can be suspended or revoked if any false information is supplied toward securing the permit/any unauthorized changes are made to the site/any unauthorized changes are made in the installation of the system. Improvement Permit with plat valid without expiration. Improvement Permit with site plan valid for sixty months. Authorization to Construct is valid for a period equal to that of Improvement Permit – not to exceed sixty months.

Signed: Wade Wilson date 1/31/02
Improvement Permit by: William O. Johnson date 1/31/02
Authorization to Construct by: William O. Johnson date 1/31/02

Installed by: Clear Master
Operation Permit by: William O. Johnson date 10/15/02
Existing System Inspection by: _____ date _____