068848 #150 100 Donld

IREDELL COUNTY HEALTH DEPARTMENT

STATESVILLE 704-878-5305 MOORESVILLE 704-664-5281

IMPROVEMENT PERMIT / CERTIFICATE OF COMPLETION / OPERATION PERMIT / EXISTING SYSTEM INSPECTION

PROPERTY DESCRIPTION NO. 21574 / 20447 DATE 8-10-96 TAX MAP NO. 8Q-A-23 / 8R-2-C-12 Watershed: ☐ Yes ☑ No

OWNER OR CONTRACTOR TERRY WAUGH PHONE: Business 323-2849 Home 585-6472

ADDRESS RT. 1, BOX 58, STONY POINT, NC 28678

LOCATION I-40 W, TR SHARON SCH RD, TL STEWART ROCK, TL FULBRIGHT, TR BEACON RIDGE, AT END ¾ ON LEFT

SUBDIVISION RIVERWALK BLOCK / SECTION III LOT 12 LOT AREA ~1.7 ACRE SITE CLASS. PS DESIGN FLOW 360 L.T.A.R. 0.30 GPD/FT²

Septic Tank: 1000 Gallons; STB 1012 Date 2-20-96
Pump Tank: 1000 Gallons; PT Date 11-24-97
Pump Make: Goulds Model PWJE0712 Serial No. M97483305
Nitrification Field: No Fields 1 Square Feet 60 To 1200 Linear Feet 300+
No Lines 4 Trench Width 36" Max Trench Bottom Depth 24 - 36" Gravel Depth N/A

☑ New System ☐ Repair System Type: I, II, III, IV, V, VI
System Description: CHAMBERED, PUMP-FED
Repair System Description: CHAMBERED, PUMP-FED
Maintenance Agreement Required: ☐ Yes ☑ No


☑ House/Mod. Home No. Bedrooms 3
☐ Mobile Home No. Bathrooms 2
☐ Business No. Employees
☐ Other
☐ Slab ☐ Crawl Space ☑ Basement w/plumbing ☐ Basement wo/plumbing

Water Supply: ☑ Individual ☐ Community ☐ Public WELL


Comments: ① INSTALL 52 CHAMBERS IN FOUR EQUAL LENGTH LINES ON CONTOUR AS SHOWN ② KEEP SYSTEM MINIMUM 100' FROM WELL, 50' FROM LAKE, 10' FROM PROPERTY LINE ③ SEE ATTACHED SHEETS FOR PUMP AND PRESSURE MANIFOLD REQUIREMENTS.

Comments: 4-24-98 - Check Tank, Lines, set pressure

INITIAL SITE SKETCH

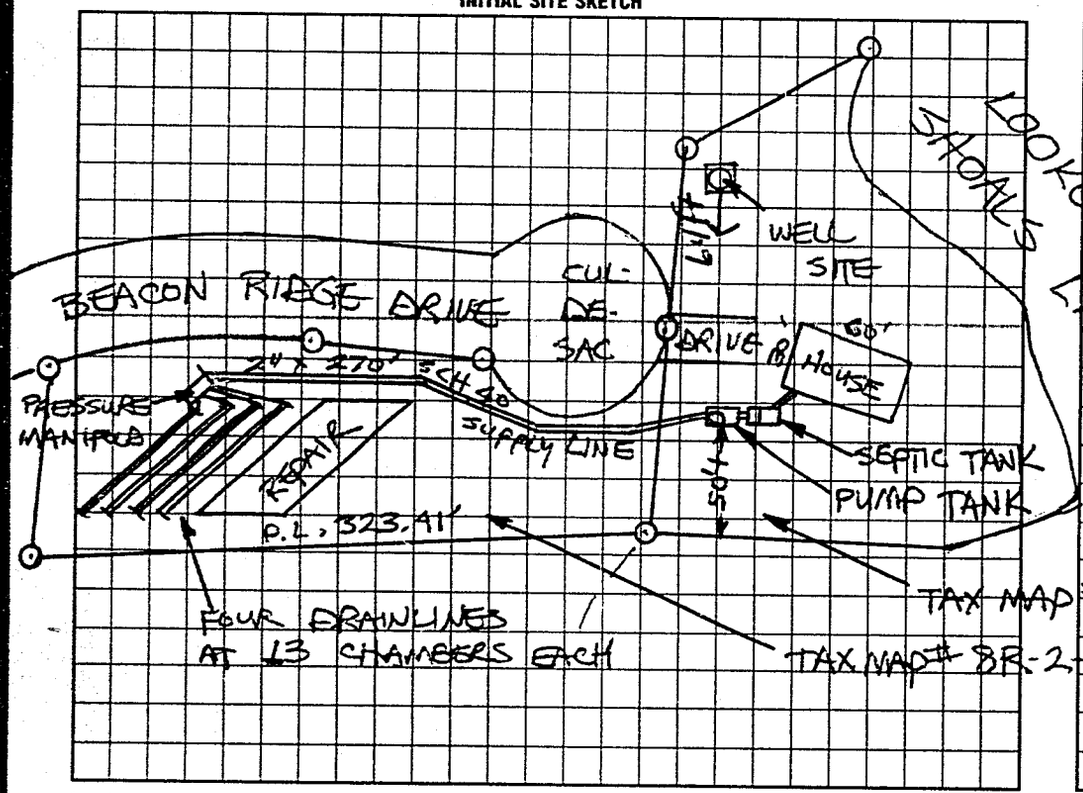

AS BUILT SKETCH

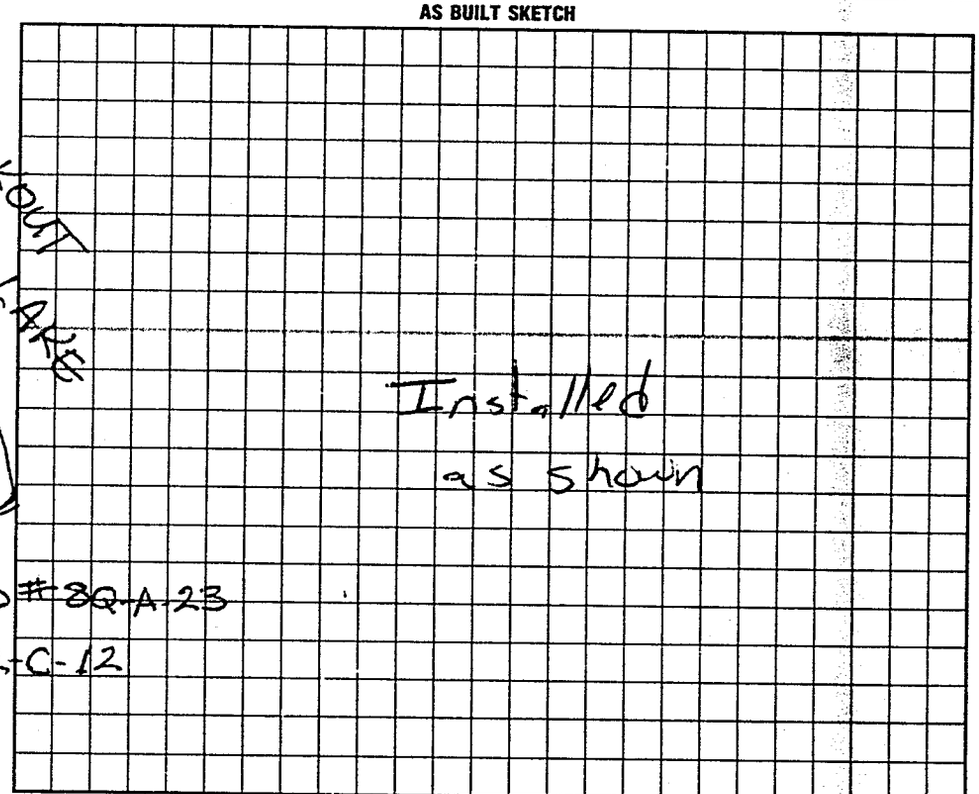

I understand that this permit can be suspended or revoked if any false information is supplied toward securing the permit/any unauthorized changes are made to the site/any unauthorized changes are made in the installation of the system. AUTH. TO CONST. IS VALID FOR FIVE (5) YEARS FROM DATE OF ISSUANCE. IMPROVEMENT PERMIT WITH SITE PLAN IS VALID FIVE YEARS.

Signed: Terry Waugh Installed by: Donald Lackey

Improvement Permit by: STEVE HEDRICK date 8-10-96 Certificate of Completion by: date

AUTH. TO CONST. ~~Existing System Inspection~~ by: STEVE HEDRICK date 8-10-96 Operation Permit by: Mark C Outz RS date 8-4-98

HEALTH DEPT. COPY: WHITE INSPECTION COPY (FINAL): GREEN OWNER COPY (FINAL): YELLOW INSPECTION COPY (INITIAL): PINK OWNER COPY (INITIAL): GOLD