This permit Replaces permit dated 11/30/01

IREDELL COUNTY HEALTH DEPARTMENT

STATESVILLE 704-878-5305 MOORESVILLE 704-664-5281

IMPROVEMENT PERMIT / AUTHORIZATION TO CONSTRUCT / OPERATION PERMIT / EXISTING SYSTEM INSPECTION

DATE 12/13/02

PERMIT# 102677 PIN# 3774-63-7627

OWNER OR CONTRACTOR Douglas Sherman PHONE: Business _____ Home (828) 697-0604

ADDRESS 613 Stacy Moutain Road Henderson, N.C. 28791

LOCATION I-40 W (R) Storm School Road, (L) Stewart Ricky (L) Fulbright (R) Riverliff (R) Overlook at end.

SUBDIVISION Riverbluff BLOCK / SECTION III LOT 10 LOT AREA 1.64 SITE CLASS PS DESIGN FLOW 360 L.T.A.R. .30 gpd/ft²

Septic Tank: 1,000 Gallons: STB 1007 Date 10-14-02

Pump Tank: _____ Gallons: PT _____ Date _____

Pump Make: _____ Model _____ Serial No _____

Nitrification Field: No Fields 1 Square Feet 4,200 Linear Feet 300

No Lines 3 Trench Width 36" Max Trench Bottom Depth 30" Gravel Depth N/A

[X] New System [ ] Repair System Type: I, II, (III), IV, V, VI

System Description: Gravity, 25% Reduction

Repair System Description: Gravity, 25% Reduction

Maintenance Agreement Required: [ ] Yes [X] No

[X] House/Mod. Home [ ] Mobile Home [ ] Business [ ] Other

No. Bedrooms 3 No. Bathrooms 2 No Employees _____


[ ] Slab [X] Crawl Space [ ] Basement w/plumbing [ ] Basement wo/plumbing

Water Supply: [X] Individual [ ] Public [ ] Community


Comments/Conditions: (1) Install lines on Contour, no deeper than 30" (2) Keep well 100ft from system (3) Maintain Proper Setbacks

Comments/Conditions: - Installed poly lok filter - Installed 300ft of E-2 Lay product

INITIAL SITE SKETCH (Not to Scale)

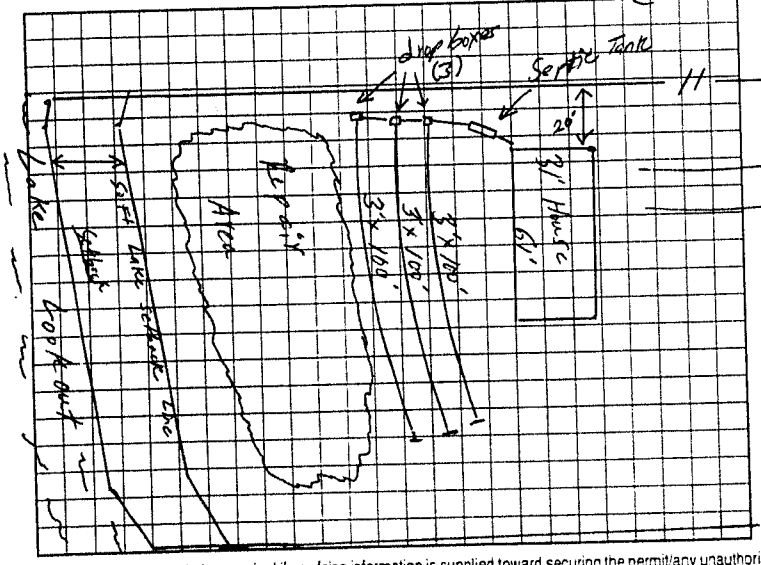

AS BUILT SKETCH

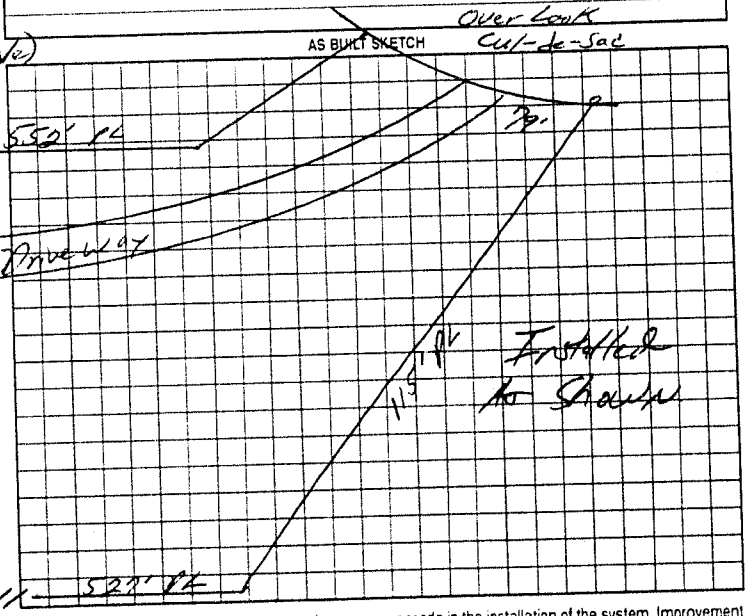

Permit can be suspended or revoked if any false information is supplied toward securing the permit/any unauthorized changes are made to the site/any unauthorized changes are made in the installation of the system. Improvement Permit with plat valid without expiration. Improvement Permit with site plan valid for sixty months. Authorization to Construct is valid for a period equal to that of Improvement Permit - not to exceed sixty months.

Signed: Doug Sherman date 12/11/02 Installed by: Doug Sherman

Improvement Permit by: William O. Johnson date 12/13/02 Operation Permit by: William O. Johnson date 12/16/02

Authorization to Construct by: William O. Johnson date 12/13/02 Existing System Inspection by: _____ date _____

HEALTH DEPT. COPY: WHITE OWNER COPY (FINAL): YELLOW OWNER COPY (INITIAL): PINK