IREDELL COUNTY HEALTH DEPARTMENT

Statesville Office (704) 878-5305 Mooresville Office (704) 660-3625 PERMIT # 179757

IMPROVEMENT PERMIT / AUTHORIZATION TO CONSTRUCT / OPERATION PERMIT / EXISTING SYSTEM

PIN # 3774638780

APPLICANT: Charles Fritz APPLICANT ADDRESS: 251 N. Hwy 16 Apt. 24 Denver, NC 28037

SITE ADDRESS: 278 Rivercliff Dr. PHONE: ALT. PHONE:

SITE DIRECTIONS: 40W, (N) on Sharon School Rd. (L) on Stewart Rock Rd. (L) on Fulbright (R) on Gardner Point (R) on Rivercliff Lot on (R)

SUBDIVISION: Riverwalk SECTION: 3 LOT # 25 LOT AREA: 1.07 Acre DESIGN FLOW: ~~440 gpd~~ 480 gpd L.T.A.R.: .3

Septic Tank	1000 (gal)	STB	IM 2071-1060	Date							
Pump Tank	(gal)	PT		Date							
Pump Make		Model		Serial #							
# Nitrification Fields	1	# Lines	3	Linear Ft:	460						
Trench Width	36"	Max. Trench Bottom Depth	36"	Gravel Depth	n/a						

[X] New System [ ] Repair [ ] Expansion System Type: I II (III) IV V VI

System Description: 25% Reduction Gravity

Repair System Description: 50% Reduction LP

Maintenance Agreement Required: [ ] YES [X] NO

[X] GRAVITY [ ] PRESSURE

[X] Residence No. Bedrooms 4

[ ] Business No. Persons

[ ] Other No. Employees


[ ] Slab [ ] Crawl Space

[X] Basement w/plumbing [ ] Basement w/o plumbing


Water Supply: [X] Private [ ] Public [ ] Community

Comments / Conditions:

INITIAL SITE SKETCH

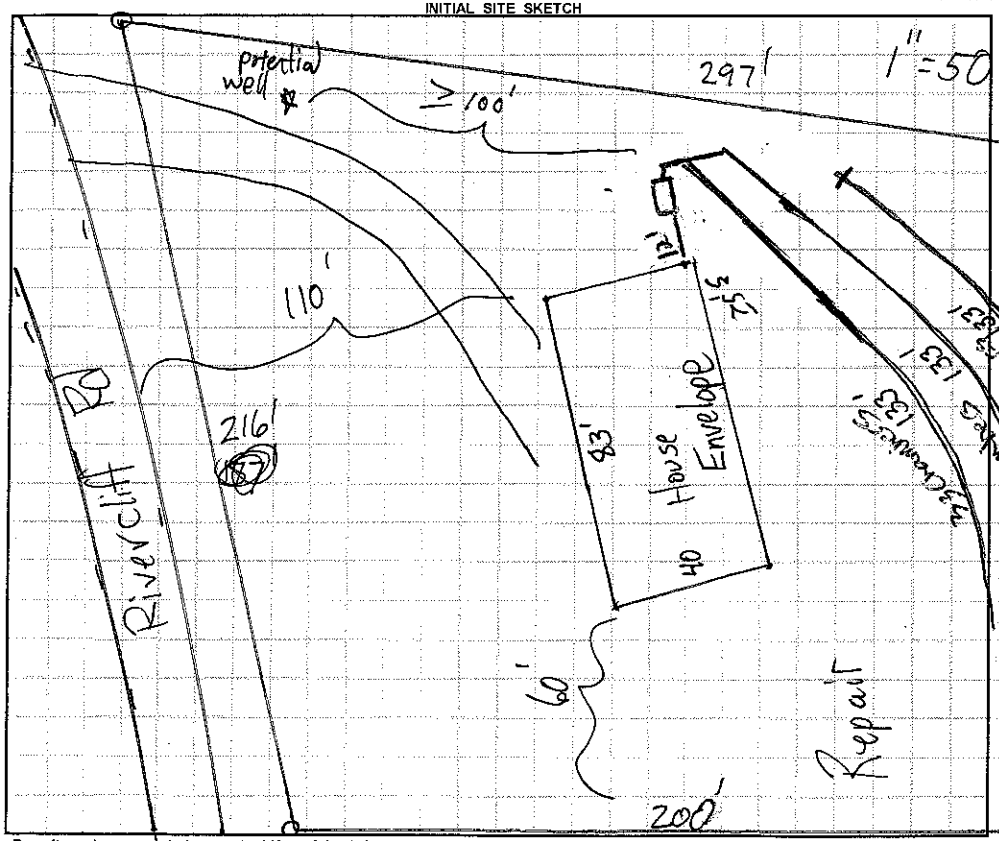

AS BUILT SKETCH

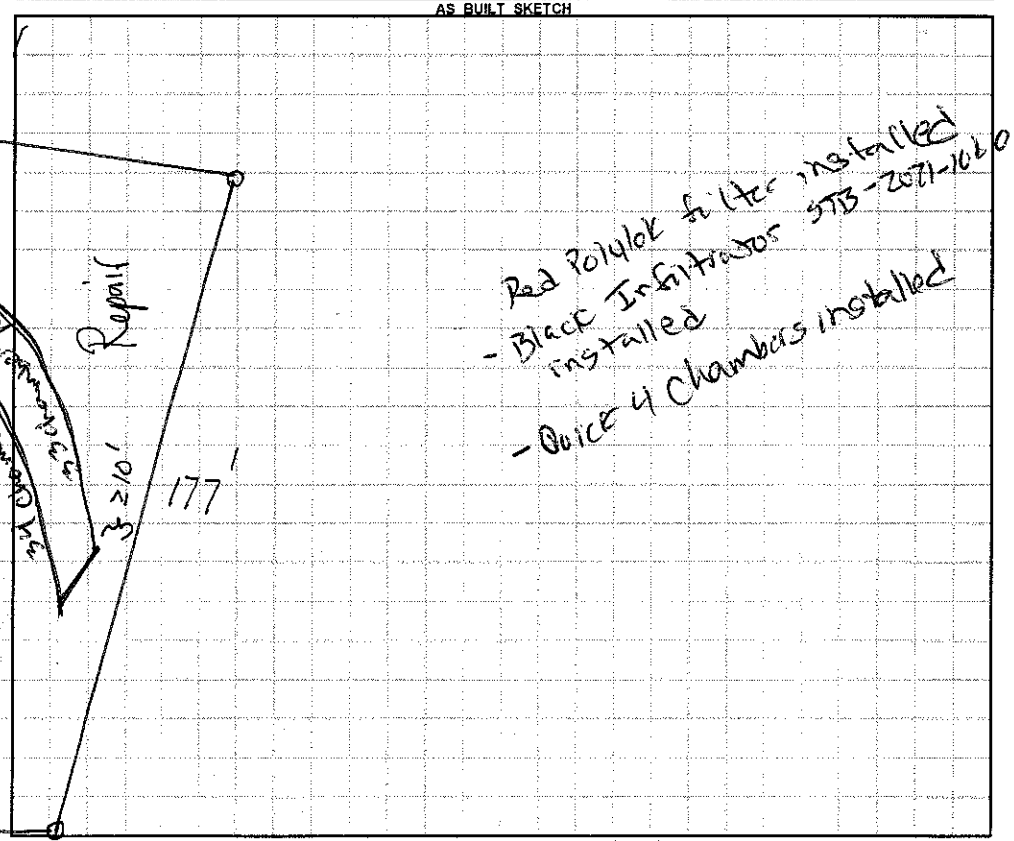

Permit can be suspended or revoked if any false information is supplied toward securing the permit / any unauthorized changes are made to the site / any unauthorized changes are made in the installation of the system. **CONTACT A LOCATOR SERVICE PRIOR TO ANY EXCAVATION**

[ ] **IMPROVEMENT PERMIT** *with plat valid without expiration.* [X] **IMPROVEMENT PERMIT** *with site plan valid for 60 mos.* [X] **AUTHORIZATION TO CONSTRUCT** *valid for period equal to IMPROVEMENT PERMIT--not to exceed 60 mo.*

Owner / Applicant Signature: Charles W Fritz II 12/31/13 Date: 8/6/13 Installed by: Roddi Long Grading

IMPROVEMENT PERMIT by: [signature] Date: 7-31-13 OPERATION PERMIT by: [signature] Date: 3-30-16

AUTHORIZATION TO CONSTRUCT by: [signature] Date: 12-31-13 Existing System Inspected by: Date:

Health Dept. Copy - WHITE Applicant (Final Approval) - YELLOW Applicant (Conditional Approval) - PINK