CHARLES F. BOCK 72035 THIS PERMIT VOIDS PREVIOUS ISSUED 3/27/95

IREDELL COUNTY HEALTH DEPARTMENT

STATESVILLE 704-878-5305 MOORESVILLE 704-664-5281

IMPROVEMENT PERMIT / CERTIFICATE OF COMPLETION / OPERATION PERMIT / EXISTING SYSTEM INSPECTION

PROPERTY DESCRIPTION NO. 19675 DATE 8-9-96 TAX MAP NO. PART of 8R-A-1 Watershed: ☐ Yes ☒ No

OWNER OR CONTRACTOR KES MARKETING, (CHARLES F. BOCK) PHONE: Business _____ Home (704) 464-2076

ADDRESS 610 2ND AVE PL. NE, CONOVER, NC 28613

LOCATION I-40W, TR SHARON SCH. RD, TL STEWART ROCK, TL RIVERWALK RD, 7TH LOT ON RIGHT FROM CUL-DE-SAC

SUBDIVISION RIVERWALK BLOCK / SECTION I LOT 7 LOT AREA 1.0422 ACRE SITE CLASS. P5 DESIGN FLOW 360 L.T.A.R. 0.30 GPD/FT²

Septic Tank: 1000 Gallons; STB 1012 Date 8-9-98
Pump Tank: _____ Gallons; PT _____ Date _____
Pump Make: _____ Model _____ Serial No. _____
Nitrification Field: No Fields 1 Square Feet EQ TO 1200 Linear Feet 300+
No Lines 4 Trench Width 36" Max Trench Bottom Depth 24-36 Gravel Depth N/A

☐ New System ☐ Repair System Type: I, II, III, IV, V, VI
System Description: CHAMBERED, GRAVITY
Repair System Description: PPBPS, PUMP FED
Maintenance Agreement Required: ☐ Yes ☒ No

☒ House/Mod. Home ☐ Mobile Home ☐ Business ☐ Other
No. Bedrooms 2 No. Bathrooms 2 No. Employees ____


☐ Slab ☐ Crawl Space ☒ Basement w/plumbing ☐ Basement wo/plumbing

Water Supply: ☒ Individual ☐ Community ☐ Public WELL


Comments: ① INSTALL 52 CHAMBERS IN FOUR EQUAL LENGTH LINES AS SHOWN ② STEPDOWN FROM UPPER LINES TO LOWER THROUGH CHAMBER TOP ③ KEEP SYSTEM MINIMUM 50' FROM LAKE, 10' FROM PROPERTY LINE, 100' FROM WELL

Comments: SYSTEM INSTALLED AS SHOWN

INITIAL SITE SKETCH

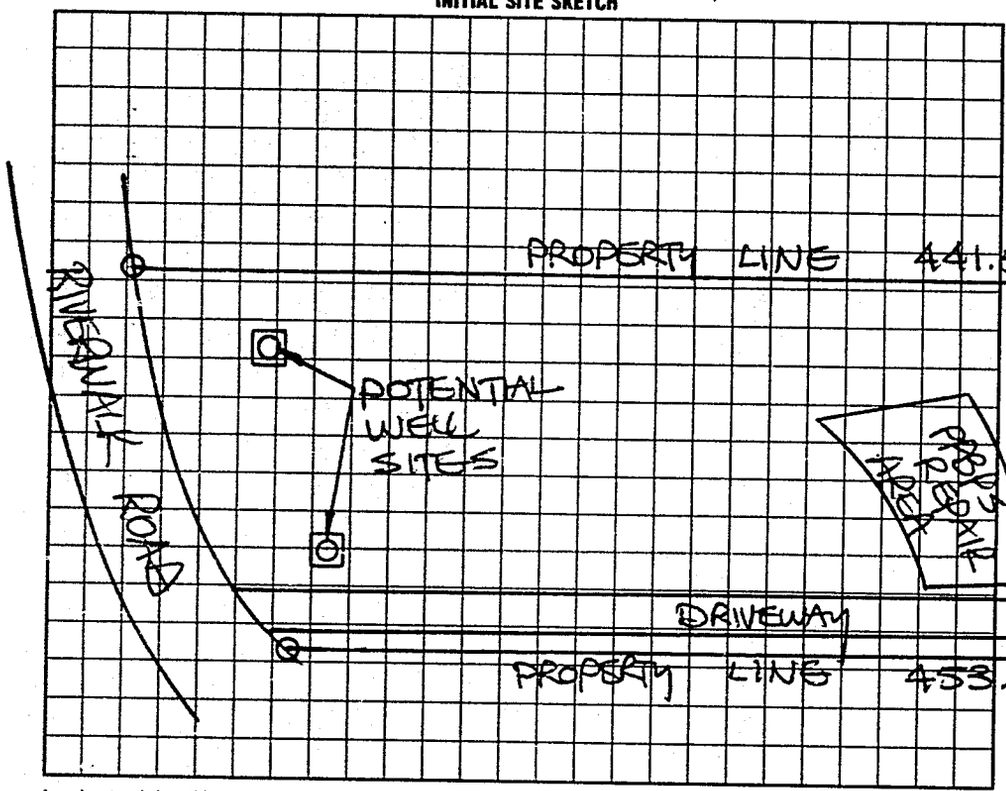

AS BUILT SKETCH

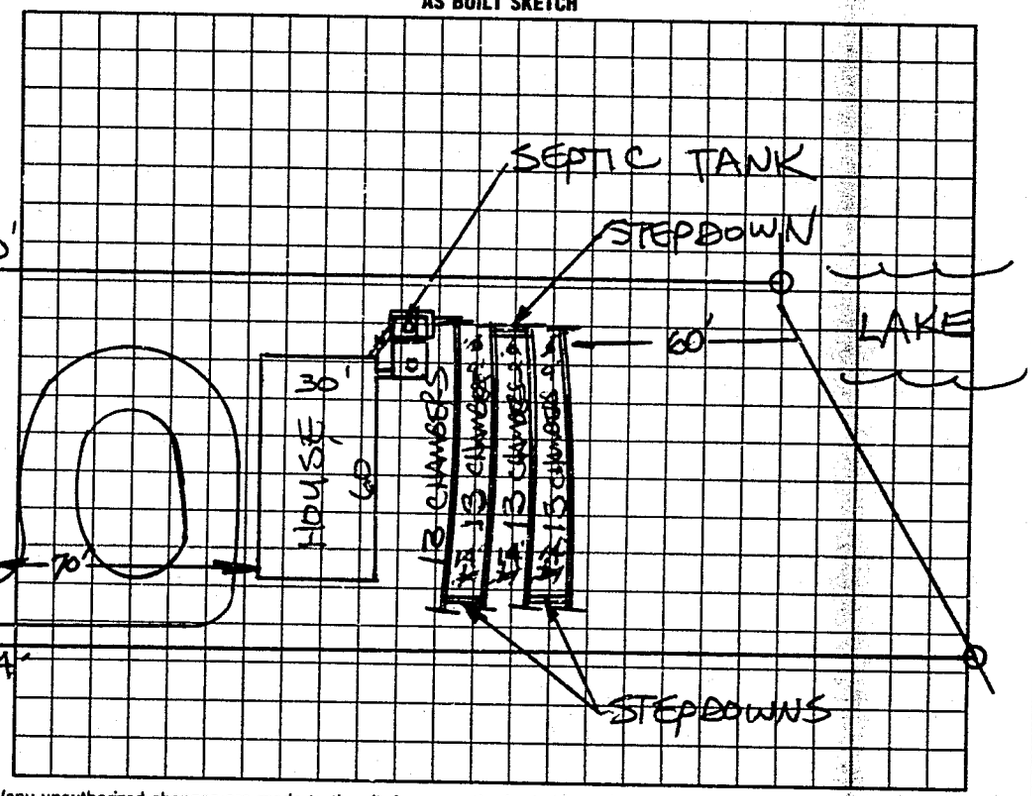

I understand that this permit can be suspended or revoked if any false information is supplied toward securing the permit/any unauthorized changes are made to the site/any unauthorized changes are made in the installation of the system.

AUTH. TO CONST. IS VALID FOR FIVE (5) YEARS FROM DATE OF ISSUANCE. IMPROVEMENT PERMIT IS VALID FOR FIVE YEARS W/SITE PLAN.

Signed: _____

Improvement Permit by: STEVE HEDRICK date 8-9-96

AUTH. TO CONST. Existing System Inspection by STEVE HEDRICK date 8-9-96

Installed by: SHELL'S DITCHING & DRAIN (GLEN SHELL)

~~Certificate of Completion by:~~ _____ date _____

Operation Permit by STEVE HEDRICK date 10-7-98

HEALTH DEPT. COPY: WHITE INSPECTION COPY (FINAL): GREEN OWNER COPY (FINAL): YELLOW INSPECTION COPY (INITIAL): PINK OWNER COPY (INITIAL): GOLD