079954

IREDELL COUNTY HEALTH DEPARTMENT

THIS PERMIT VOIDS PREVIOUS ISSUED 3/29/95

STATESVILLE 704-878-5305 MOORESVILLE 704-664-5281

IMPROVEMENT PERMIT / AUTHORIZATION TO CONSTRUCT / OPERATION PERMIT / EXISTING SYSTEM INSPECTION

PERMIT# 19690 PIN# 3774 64 2244 DATE 9-30-99

OWNER OR CONTRACTOR BARRY & SARAH RUGGS PHONE: Business Home (704) 788-7775

ADDRESS

LOCATION I-40 W, TR SHARON SCH. RD, TL STEWART ROCK DR, TL RIVERWALK RD, 3RD LOT ON LEFT BEFORE CUL-DE-SAC

SUBDIVISION RIVERWALK BLOCK / SECTION I LOT 22 LOT AREA 0.6401 ACRE SITE CLASS PS DESIGN FLOW 480 L.T.A.R. 0.33 GPD/FT²

Septic Tank: 1000 Gallons; STB 168 Date 9-7-99
Pump Tank: 1000 Gallons; PT 149 Date 9-6-99
Pump Make: Hydr-Static Model Serial No.
Nitrification Field: No Fields 1 Square Feet EQ. TO 1440 Linear Feet 360
No Lines SIX Trench Width 36" Max Trench Bottom Depth 36" ~~Gravel~~ Depth SAND 6"

☑ New System ☐ Repair System Type: I, II, III, IV, V, VI
System Description: 25% REDUCTION, PUMP
Repair System Description: 50% REDUCTION, LPP
Maintenance Agreement Required: ☐ Yes ☑ No


☑ House/Mod. Home No. Bedrooms 4
☐ Mobile Home No. Bathrooms 3
☐ Business No. Employees
☐ Other
☐ Slab ☐ Crawl Space ☑ Basement w/plumbing ☐ Basement wo/plumbing

Water Supply: ☑ Individual ☐ Public ☐ Community WELL


Comments/Conditions ① INSTALL SIXTY (60) CHAMBERS OR THIRTY-SIX (36) HDS SECTIONS IN SIX (6) EQUAL LENGTH LINES ON CONTOUR
② KEEP SYSTEM MAXIMUM FEASIBLE DISTANCE (60') FROM WELL.
③ SEE ATTACHED SHEETS FOR PUMP & PRESSURE MANIFOLD REQUIREMENTS.

Comments/Conditions: TANK & LINES INSPECTED OK 10.25.99
A/SAM & PRESSURE CHECKED 10-28-99

INITIAL SITE SKETCH

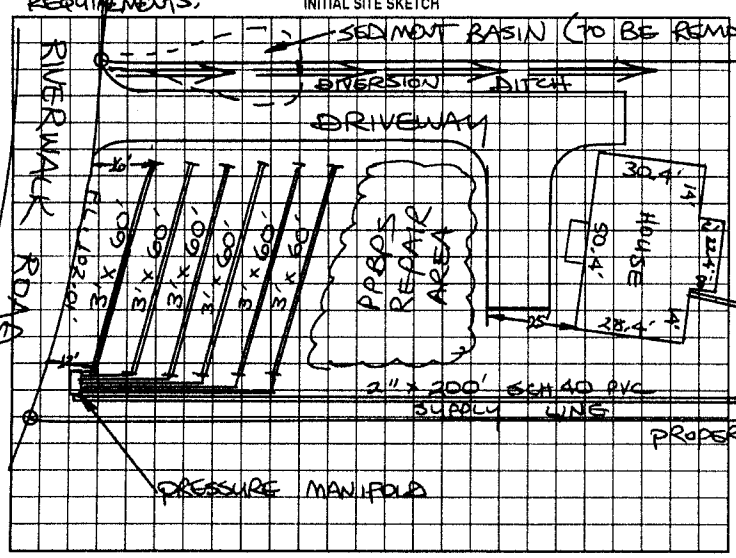

AS BUILT SKETCH

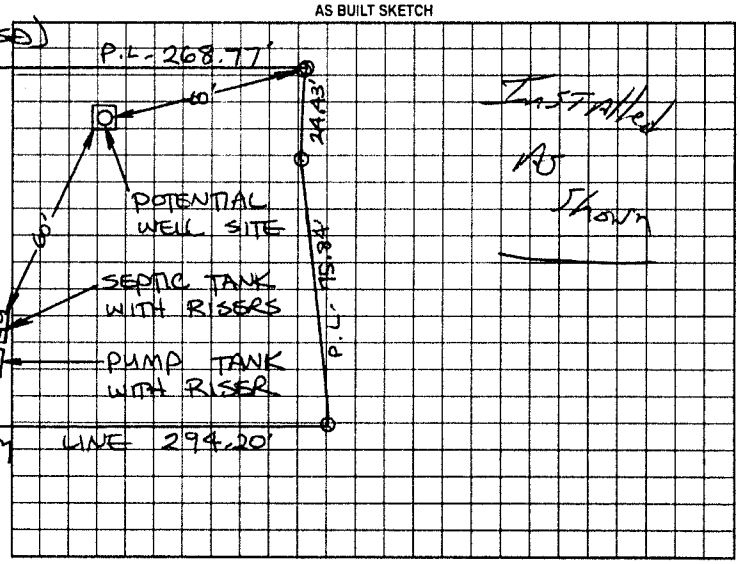

Permit can be suspended or revoked if any false information is supplied toward securing the permit/any unauthorized changes are made to the site/any unauthorized changes are made in the installation of the system. Improvement Permit with plat valid without expiration. Improvement Permit with site plan valid for sixty months. Authorization to Construct is valid for a period equal to that of Improvement Permit -- not to exceed sixty months.

Signed: S Ruggs date 10/1/99 Installed by: Shane Sanford

Improvement Permit by: STEVE HEDRICK date 9-30-99 Operation Permit by: JC Potter date OCT 28 99

Authorization to Construct by: STEVE HEDRICK date 9-30-99 Existing System Inspection by: date

HEALTH DEPT COPY: WHITE OWNER COPY (FINAL) YELLOW OWNER COPY (INITIAL) PINK