IREDELL COUNTY HEALTH DEPARTMENT

THIS PERMIT REPLACES EXPIRED PERMIT #068206

STATESVILLE 704-878-5305 MOORESVILLE 704-664-5281

IMPROVEMENT PERMIT / AUTHORIZATION TO CONSTRUCT / OPERATION PERMIT / EXISTING SYSTEM INSPECTION

PERMIT# 125372 PIN# 3774-66-8471 DATE 2-2-05

OWNER OR CONTRACTOR WAYNE HOMES MID ATLANTIC, LLC PHONE: Business 336-782-9282 Home 704-872-8989

ADDRESS 130 VICTORY LANE, STATESVILLE NC 28625

LOCATION I-40 W TR SHARON SCHOOL ROAD, TL STEWART ROCK ROAD, 2ND LOT ON LEFT BEFORE RIVERWALK DRIVE

SUBDIVISION RIVERWALK BLOCK / SECTION I LOT 33 LOT AREA 5.455 ACRES SITE CLASS. PS DESIGN FLOW 480 L.T.A.R. 0.30 GPD/FT²

Septic Tank: 1000 Gallons; STB 1012 Date 9-20-04

Pump Tank: _____ Gallons; PT _____ Date _____

Pump Make: _____ Model _____ Serial No. _____

Nitrification Field: No. Fields 1 Square Feet 1600 Linear Feet ~~500~~ 400

No Lines ~~6~~ 5 Trench Width 36" Max Trench Bottom Depth 30" Gravel Depth 12"

☒ New System ☐ Repair System Type: I (II) III, IV, V, VI

System Description: CONVENTIONAL, GRAVITY

Repair System Description: CONVENTIONAL, GRAVITY

Maintenance Agreement Required: ☐ Yes ☐ No

☒ House/Mod. Home No. Bedrooms 4

☐ Mobile Home No. Bathrooms ____

☐ Business No. Employees ____


☐ Other ____

☐ Slab ☑ Crawl Space ☐ Basement w/plumbing ☐ Basement wo/plumbing

Water Supply: ☒ Individual ☐ Public ☐ Community WELL


Comments:/Conditions: INSTALL LINES ON CONTOUR NO DEEPER THAN 32", KEEP SYSTEM MINIMUM 100 FEET FROM WELL, 15' FROM POOL.

INITIAL SITE SKETCH

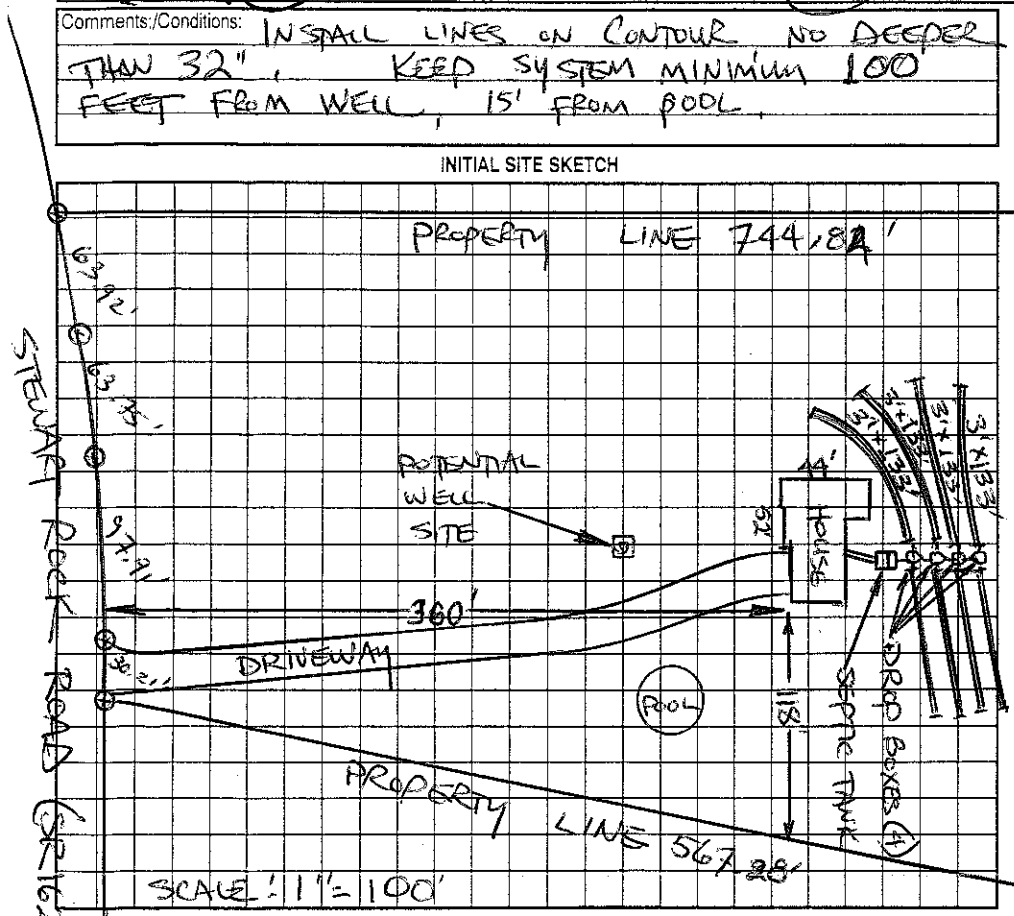

Comments:/Conditions: ① SEPTIC TANK WITH MARKER INSTALLED USING "TUFFTE" FILTER ② 100 "QUICK-4 INFILTRATOR" CHAMBERS INSTALLED AS "ACCEPTED" SYSTEM *

AS BUILT SKETCH

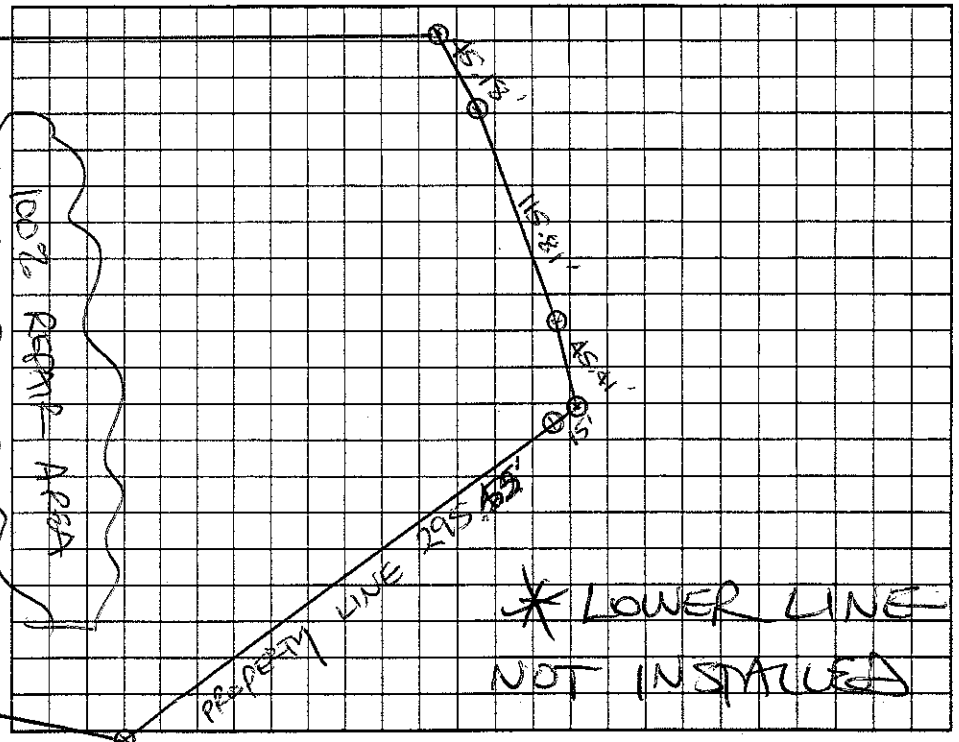

Permit can be suspended or revoked if any false information is supplied toward securing the permit/any unauthorized changes are made to the site/any unauthorized changes are made in the installation of the system. Improvement Permit with plat valid without expiration. Improvement Permit with site plan valid for sixty months. Authorization to Construct is valid for a period equal to that of Improvement Permit – not to exceed sixty months.

Signed: _____ date 2-2-05 Installed by: A-1 BACKHOE

Improvement Permit by: STEVE HENDRICK date 2-2-05 Operation Permit by: STEVE HENDRICK date 4-26-05

Authorization to Construct by: STEVE HENDRICK date 2-2-05 Existing System Inspection by: _____ date _____

HEALTH DEPT. COPY: WHITE OWNER COPY (FINAL): YELLOW OWNER COPY (INITIAL): PINK