This Permit Void's Previous Issued permit on 9-24-97.

IREDELL COUNTY HEALTH DEPARTMENT

STATESVILLE 704-878-5305 ✓ MOORESVILLE 704-664-5281

IMPROVEMENT PERMIT / AUTHORIZATION TO CONSTRUCT / OPERATION PERMIT / EXISTING SYSTEM INSPECTION

PERMIT# 06820 PIN# _____ DATE Sept 24 1997

OWNER OR CONTRACTOR Dale L. Hawks PHONE: Business — Home (704) 924-7564

ADDRESS 833 Bristol Dr. Statesville, N.C. 28677

LOCATION I-40, Sharon School Rd North, (L) Locust Rock Rd, on (R) across from Olive Rd.

SUBDIVISION River Walk BLOCK / SECTION I LOT 38 LOT AREA 2.33Ac SITE CLASS PS DESIGN FLOW 360 L.T.A.R. .3

Septic Tank: 1,000 Gallons. STB 10 12 Date 7-24-01
Pump Tank: _____ Gallons. PT _____ Date _____
Pump Make: _____ Model _____ Serial No. _____
Nitrification Field: No Fields 1 Square Feet 1200 Linear Feet 400
No Lines 4 @ 100' Trench Width 36" Max Trench Bottom Depth 24" Gravel Depth 12"

X New System ☐ Repair System Type: I (II) III. IV. V. VI
System Description: Gravity Conventional
Repair System Description: Gravity, Conventional
Maintenance Agreement Required: ☐ Yes ☐ No


X House/Mod. Home No. Bedrooms 3
☐ Mobile Home No. Bathrooms 2
☐ Business No. Employees ____
☐ Other _____
☐ Slab ✓ Crawl Space ☐ Basement w/plumbing ☐ Basement wo/plumbing

Water Supply: X Individual ☐ Public ☐ Community

Comments/Conditions: ① Install lines on contour ② Keep well 100Ft From Septic System

Comments/Conditions - Septic Tank Marker Installed
- Poly Lok Filter Installed
- Lines 90, 90 100 Ft, 120 Ft Lines only
3 Drop boxes installed.

INITIAL SITE SKETCH 1" = 100'

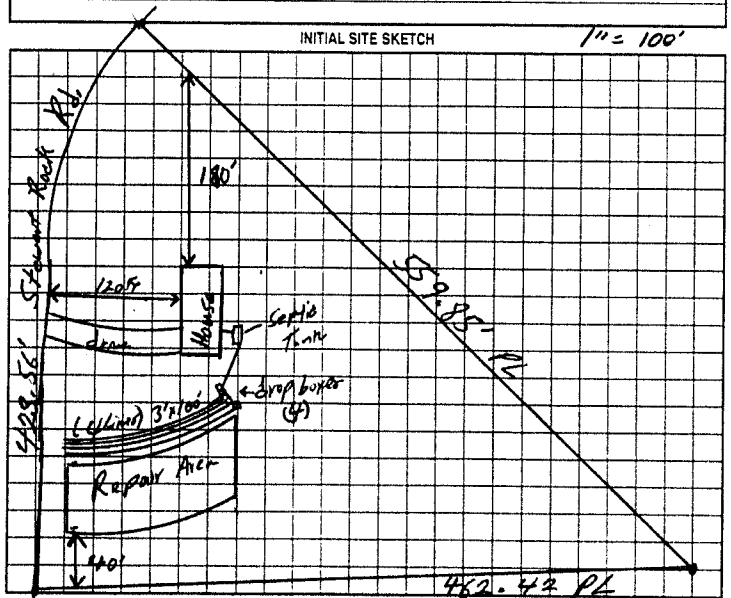

AS BUILT SKETCH

Installed as Shown

Permit can be suspended or revoked if any false information is supplied toward securing the permit/any unauthorized changes are made to the site/any unauthorized changes are made in the installation of the system. Improvement Permit with plat valid without expiration. Improvement Permit with site plan valid for sixty months. Authorization to Construct is valid for a period equal to that of Improvement Permit – not to exceed sixty months.

Signed: Dale L Hawks date 4-25-01

Improvement Permit by: William O. Johnson REHS date 3/30/01

Authorization to Construct by: William O. Johnson REHS date 3/22/01

This Permit Expires 9-24-02. 60 Months From original date of issue.

Installed by: A-1 Backhoe

Operation Permit by: William O. Johnson date 10/17/01

Existing System Inspection by: _____ date _____

HEALTH DEPT. COPY (WHITE) OWNER COPY (FINAL) YELLOW OWNER COPY (INITIAL) PINK