pd Type III fee

IREDELL COUNTY HEALTH DEPARTMENT

STATESVILLE 704-878-5305 MOORESVILLE 704-664-5281

IMPROVEMENT PERMIT / CERTIFICATE OF COMPLETION / OPERATION PERMIT / EXISTING SYSTEM INSPECTION

PROPERTY DESCRIPTION NO. 24222 075890 DATE 7-11-96 TAX MAP NO. 8R-2-D-28 Watershed ☐ Yes ☒ No

OWNER OR CONTRACTOR KEJ MARKETING CO, INC, PHONE: Business 847-6006 Home

ADDRESS P.O. BOX 1627, MATTHEWS NC 28106

LOCATION I-40 W, TR SHARON SCH, TL COUNTY LINE, TL FULBRIGHT, TR OVERLOOK, TR RIVER CLIFF, TL STONECLIFF, LOT on (R)

SUBDIVISION RIVERWALK BLOCK / SECTION II LOT 28 LOT AREA 1.040 AC SITE CLASS. PS DESIGN FLOW 360 L.T.A.R. 0.30 GPD/FT²

Septic Tank: 1000 Gallons; STB 1017 Date 6-30-

Pump Tank: Gallons; PT Date

Pump Make: Model Serial No.

Nitrification Field: No Fields 1 Square Feet EQ TO 1200 Linear Feet 300+

No Lines 4 Trench Width 36" Max Trench Bottom Depth 18-36" Gravel Depth N/A

☒ New System ☐ Repair System Type: I, II, (III), IV, V, VI

System Description: CHAMBERS, GRAVITY FED

Repair System Description: PRPS, GRAVITY

Maintenance Agreement Required: ☐ Yes ☒ No

☒ House/Mod. Home ☐ Mobile Home ☐ Business ☐ Other

No. Bedrooms 3 No. Bathrooms 2 No. Employees


☐ Slab ☐ Crawl Space ☒ Basement w/plumbing ☐ Basement wo/plumbing

Water Supply: ☒ Individual ☐ Community ☐ Public WELL


Comments: (A) INSTALL 50 CHAMBERS IN FOUR LINES AS SHOWN USING SERIAL DISTRIBUTION (B) KEEP SYSTEM MINIMUM 50' FROM LAKE, 100' FROM WELL, 10' FROM PROPERTY LINE.

Comments:

INITIAL SITE SKETCH

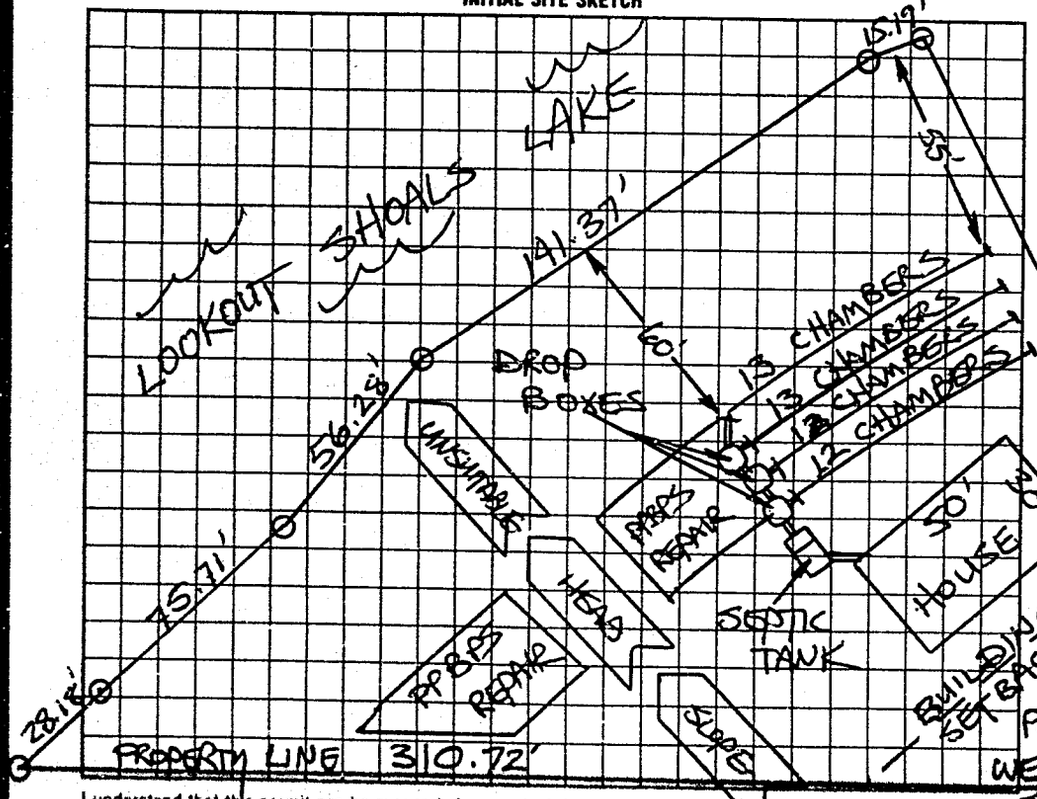

AS BUILT SKETCH

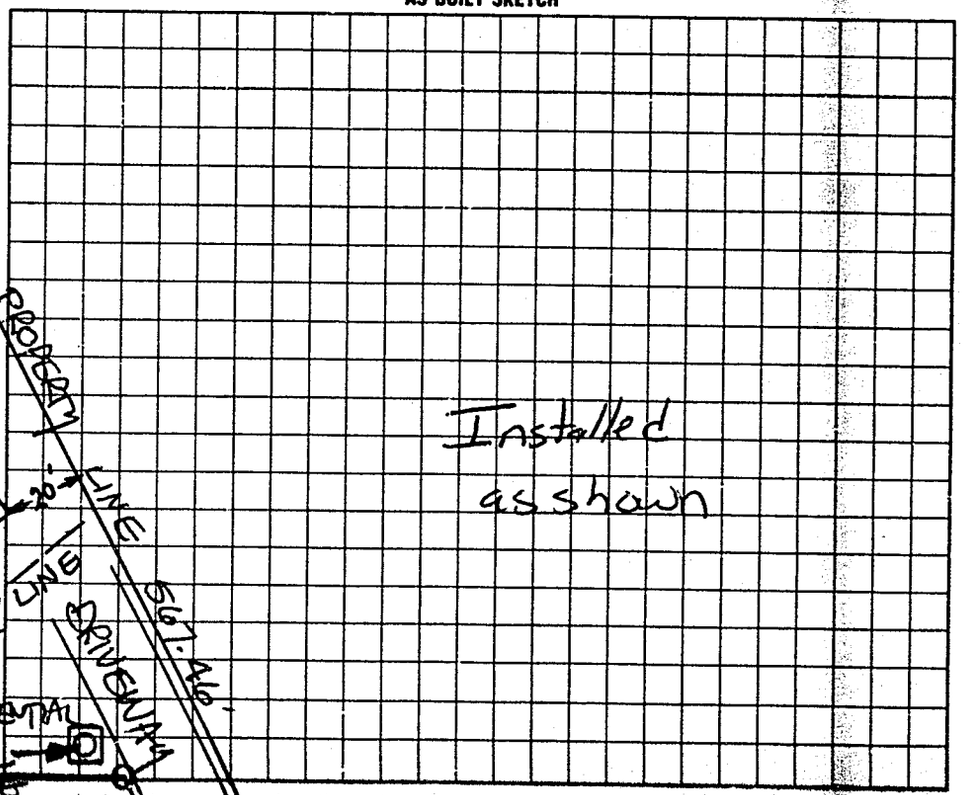

I understand that this permit can be suspended or revoked if any false information is supplied toward securing the permit, any unauthorized changes are made to the site/any unauthorized changes are made in the installation of the system.

Authorization to Construct is valid five (5) years from date of issuance. Improvement Permit has no expiration date.

Signed:

Improvement Permit by: STEVE HEDRICK date 7-11-96

AUTHORIZATION TO CONSTRUCT: STEVE HEDRICK date 7-11-96

Installed by: Johnson's Landscaping date

Certificate of Completion by:

Operation Permit by: Mary C. Ott RS date 8-27-98

DEALER COPY (WHITE) BY [illegible] COPY (PINK) YELLOW OWNER COPY (PINK) YELLOW INSPECTION COPY (INITIAL) PINK OWNER COPY (INITIAL) GOLD

82200