THIS PERMIT VOIDS EXPIRED PERMIT ISSUED 5-9-96

IREDELL COUNTY HEALTH DEPARTMENT

STATESVILLE 704-878-5305 CI MOORESVILLE 704-664-5281

IMPROVEMENT PERMIT / AUTHORIZATION TO CONSTRUCT / OPERATION PERMIT / EXISTING SYSTEM INSPECTION

(1)

PERMIT# 105786 PIN# 3774-72-6642 DATE 4-24-02

OWNER OR CONTRACTOR JAMES V. HEDGECOCK PHONE: Business Home 336-659-8960

ADDRESS 5367 LARCH COURT, WINSTON SALEM, NC 27104

LOCATION I-40 W, TR SHARON SCH RD, TL STEWART ROCK, TL FULBRIGHT, TR GARDNER POINT, TR RIVERCLIFF, TL PIER POINT, END ON (R)

SUBDIVISION RIVERWALK BLOCK / SECTION IV LOT 12 LOT AREA 0.818 ACRE SITE CLASS PS DESIGN FLOW 360 L.T.A.R. 0.30 GPD/FT²

Septic Tank: 1000 Gallons; STB 1007 Date 6-13-02

Pump Tank: ____ Gallons; PT ____ Date ____

Pump Make: ____ Model ____ Serial No. 300

Nitrification Field: No Fields 1 Square Feet 1200 Linear Feet ~~400~~

No Lines ~~FOUR~~ THREE Trench Width 36" Max Trench Bottom Depth 36" Gravel Depth N/A

☑ New System ☐ Repair System Type: I (II) III IV V VI

System Description: 25% REDUCTION, CONVENTIONAL, GRAVITY

Repair System Description: 25% REDUCTION, GRAVITY

Maintenance Agreement Required: ☐ Yes ☑ No

☑ House/Mod. Home No. Bedrooms 3

☐ Mobile Home No. Bathrooms 2

☐ Business No. Employees ____

☐ Other ____

☐ Slab ☐ Crawl Space ☑ Basement w/plumbing ☐ Basement wo/plumbing


Water Supply: ☑ Individual ☐ Public ☐ Community

WELL


Comments:/Conditions: KEEP SYSTEM MINIMUM 100 FEET FROM WELL

Comments:/Conditions: System changed with prior Health Dept Approval. - Installed 48 Infiltrator chambers, poly lok Filter Installed, ST marker Installed.

INITIAL SITE SKETCH

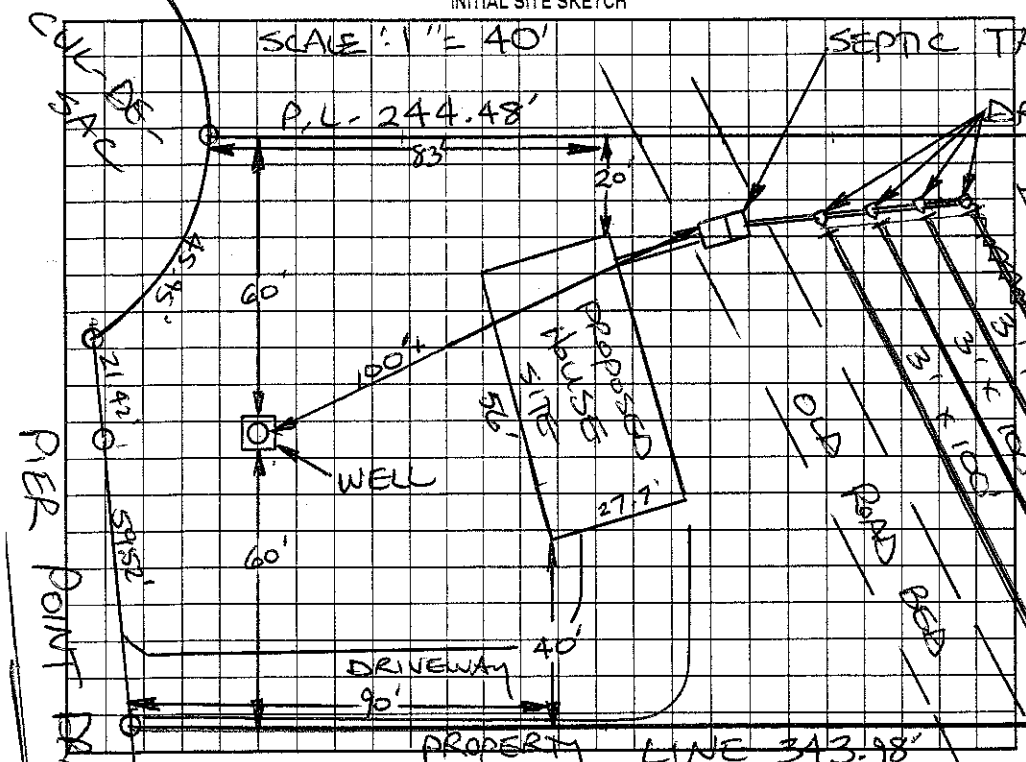

AS BUILT SKETCH

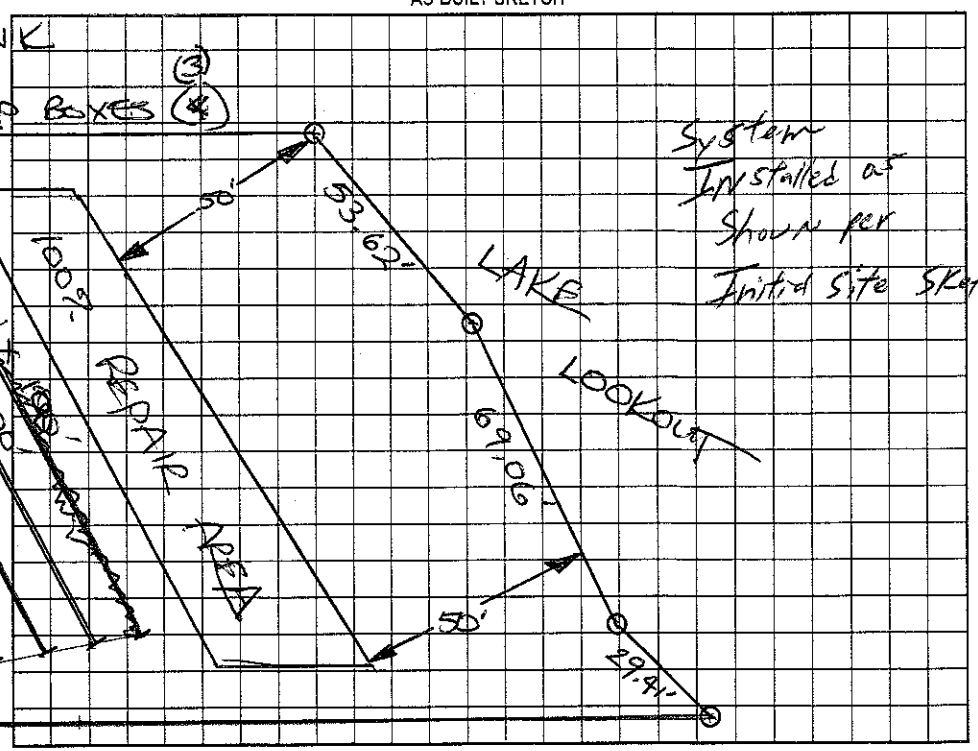

Permit can be suspended or revoked if any false information is supplied toward securing the permit/any unauthorized changes are made to the site/any unauthorized changes are made in the installation of the system. Improvement Permit with plat valid without expiration. Improvement Permit with site plan valid for sixty months. Authorization to Construct is valid for a period equal to that of Improvement Permit – not to exceed sixty months.

Signed: James V Hedgecock date 4-24-02 Installed by: Tommy Cothren

Improvement Permit by: STEVE HEDRICK date 4-24-02 Operation Permit by: William O. Johnson date 1/16/03

Authorization to Construct by: STEVE HEDRICK date 4-24-02 Existing System Inspection by: ____ date ____

HEALTH DEPT. COPY: WHITE OWNER COPY (FINAL): YELLOW OWNER COPY (INITIAL): PINK