76220

THIS PERMIT VOIDS PREVIOUS ISSUED 5-14-96

IREDELL COUNTY HEALTH DEPARTMENT

STATESVILLE 704-878-5305 MOORESVILLE 704-664-5281

IMPROVEMENT PERMIT / AUTHORIZATION TO CONSTRUCT / OPERATION PERMIT / EXISTING SYSTEM INSPECTION

PERMIT# 23756 PIN# 8R-A-1 (PART OF) DATE 8-6-98

OWNER OR CONTRACTOR K. DOUGLAS HULLETT PHONE: Business Home 896-2041

ADDRESS 18809 NAUTICAL DRIVE, CORNELIUS, NC 28031

LOCATION I-40 W, TR SHARON SCH, TL STEWART ROCK, TL FULBRIGHT, TR GARDNER POINT, TR RIVERCLIFF, TL PIER POINT

SUBDIVISION RIVERWALK BLOCK / SECTION IV LOT 10 LOT AREA 0.925 ACRE SITE CLASS. PS DESIGN FLOW 360 L.T.A.R. 0.25 GPD/FT²

Septic Tank: 1000 Gallons; STB 1012 Date 5.17.99

Pump Tank: ____ Gallons; PT ____ Date ____

Pump Make: ____ Model ____ Serial No. ____

Nitrification Field: No Fields 1 Square Feet Eq. to 1440 Linear Feet 240

No Lines SIX Trench Width 24" Max Trench Bottom Depth 36"

[X] New System [ ] Repair System Type: I, II, III, IV, V, VI

System Description: GRAVITY-FED, PPBPS

Repair System Description: PUMP-FED, PPBPS

Maintenance Agreement Required: [ ] Yes [X] No (SEE R-O-W)

~~Gravel~~ Depth SAND 6" [ ] Slab [ ] Crawl Space [X] Basement w/plumbing [ ] Basement wo/plumbing

[X] House/Mod. Home No. Bedrooms 3

[ ] Mobile Home No. Bathrooms 2½

[ ] Business No. Employees ____

[ ] Other ____

Water Supply: [X] Individual [ ] Public [ ] Community WELL


LOT AT END ON LEFT

Comments:/Conditions: ① KEEP SYSTEM MINIMUM 100' FROM WELLS, .1956(6)(9) ② INSTALL 54 PPBPS PANELS IN SIX EQUAL LENGTH LINES ON CONTOUR ③ SEE ATTACHED DUKE POWER CO. LETTER GRANTING PERMISSION TO PLACE SEPTIC SYSTEM IN R-O-W.


Comments:/Conditions:

SCALE: 1"=50'

INITIAL SITE SKETCH

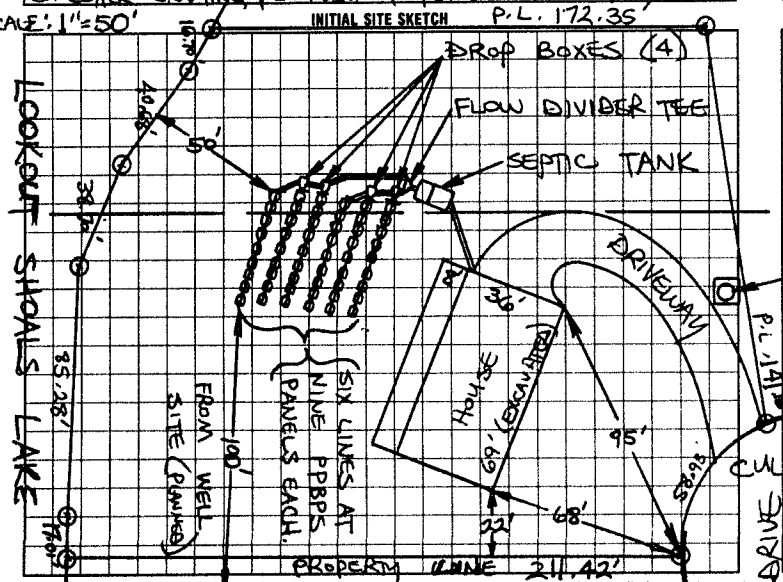

AS BUILT SKETCH

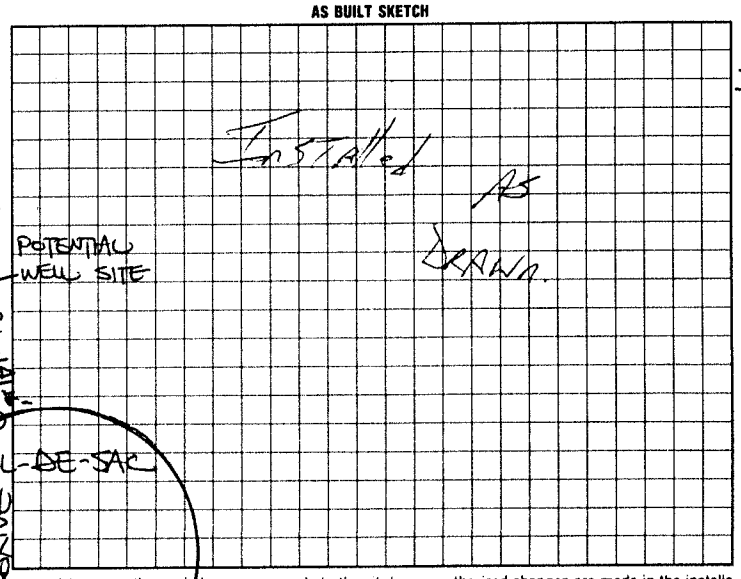

I understand that this permit may be suspended or revoked if any false information is supplied toward securing the permit/any unauthorized changes are made to the site/any unauthorized changes are made in the installation of the system. Improvement Permit with plat valid without expiration. Improvement Permit with site plan valid for sixty months. Authorization to Construct is valid for a period equal to that of Improvement Permit – not to exceed sixty months.

Signed: Doug Hullett date 8-13-98 Installed by: Tommy Frye

Improvement Permit by: STEVE HEDRICK date 8-6-98 Operation Permit by: [signature] date 7.22.99

Authorization to Construct by: STEVE HEDRICK date 8-6-98 Existing System Inspection by: ____ date ____

HEALTH DEPT. COPY: WHITE INSPECTION COPY (FINAL) GREEN OWNER COPY (FINAL) YELLOW INSPECTION COPY (INITIAL) PINK OWNER COPY (INITIAL): GOLD