IREDELL COUNTY HEALTH DEPARTMENT

(C1) THIS PERMIT REPLACES EXPIRED PERMIT #024470

STATESVILLE 704-878-5305 MOORESVILLE 704-664-5281

IMPROVEMENT PERMIT / AUTHORIZATION TO CONSTRUCT / OPERATION PERMIT / EXISTING SYSTEM INSPECTION

(C1)

PERMIT# 134218 PIN# 3774-72-9737 DATE 3-24-06

OWNER OR CONTRACTOR GLEN SAVELLE PHONE: Business 704-439-6449 Home 704-892-9565

ADDRESS 17601 CALVERTON RD HUNTERSVILLE NC 28078

LOCATION STEWART ROCK RD TO FULBRIGHT RD, TR GARDNER, TR RIVER CLIFF TL PIER POINT, 4TH LOT ON LEFT

SUBDIVISION RIVERWALK BLOCK / SECTION IV LOT 8 LOT AREA 0.819 ACRE SITE CLASS PS DESIGN FLOW 480 L.T.A.R. 0.30 GPD/FT²

Septic Tank: 1000 Gallons; STB 760 Date 9-11-06

Pump Tank: ____ Gallons; PT ____ Date ____

Pump Make: ____ Model ____ Serial No. ____

Nitrification Field: No Fields 1 Square Feet ~~480~~ 1600 Linear Feet 400

No Lines FOUR Trench Width 36" Max Trench Bottom Depth 36" Gravel Depth N/A

☑ New System ☐ Repair System Type: I (II) III IV V VI

System Description: 25% REDUCTION, GRAVITY

Repair System Description 50% REDUCTION, GRAVITY

Maintenance Agreement Required: ☐ Yes ☑ No

☑ House/Mod. Home No. Bedrooms 4

☐ Mobile Home No. Bathrooms ____

☐ Business No. Employees ____

☐ Other ____


☐ Slab ☑ Crawl Space ☐ Basement w/plumbing ☐ Basement wo/plumbing

Water Supply: ☑ Individual ☐ Public ☐ Community WELL


Comments:/Conditions: (1) KEEP SYSTEM MINIMUM 100' FROM WELL (2) INSTALL 25% REDUCTION SYSTEM ON CONTOUR AS SHOWN (3) GRADE DRAINFIELD AREA TO UNIFORM SLOPE, REMOVE LARGE ROCK.

Comments:/Conditions: SEPTIC TANK WITH MARKER INSTALLED USING RED "POLYLOK" FILTER

INITIAL SITE SKETCH

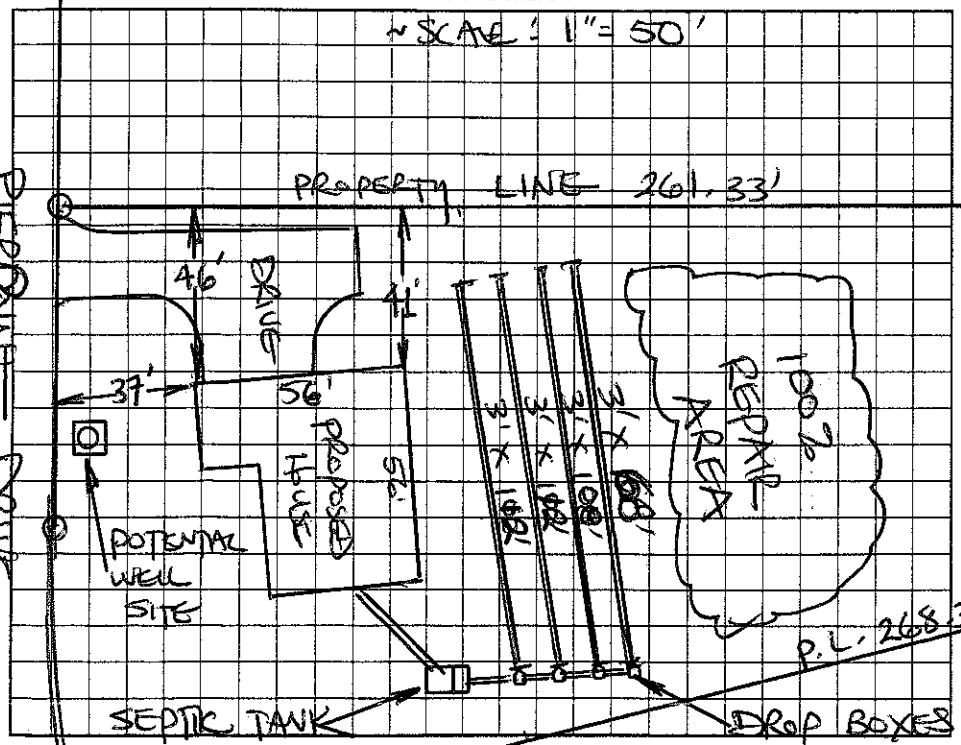

AS BUILT SKETCH

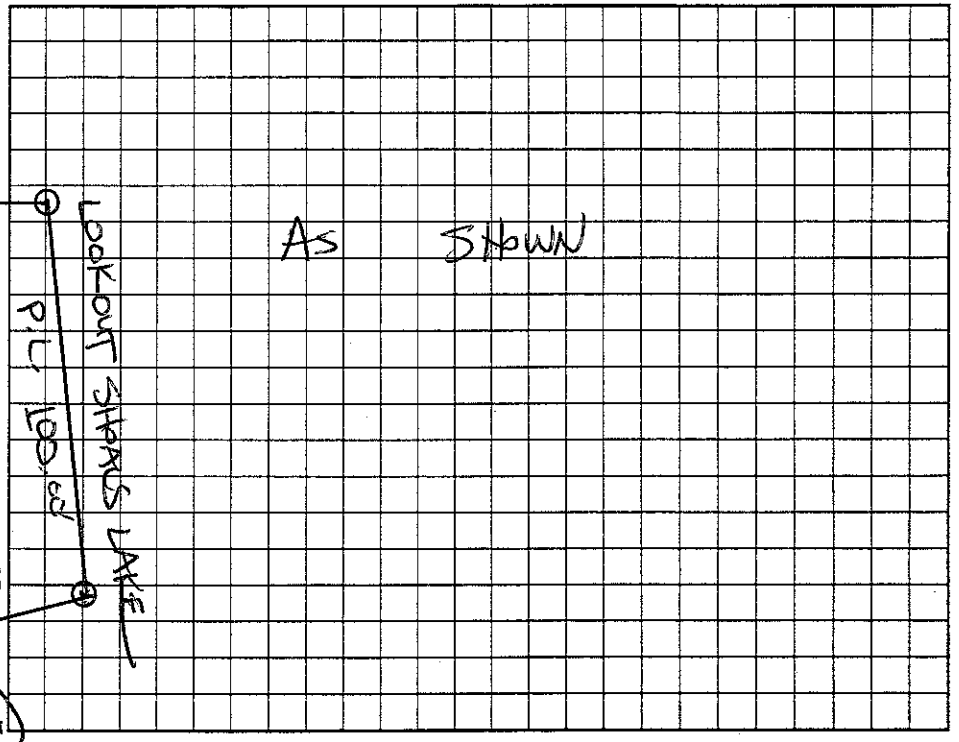

Permit can be suspended or revoked if any false information is supplied toward securing the permit/any unauthorized changes are made to the site/any unauthorized changes are made in the installation of the system. Improvement Permit with plat valid without expiration. Improvement Permit with site plan valid for sixty months. Authorization to Construct is valid for a period equal to that of Improvement Permit – not to exceed sixty months.

Signed ____ date 3-28-06 Installed by: TIM ABEE GRADING

Improvement Permit by: STEVE HEDRICK date 3-24-06 Operation Permit by: STEVE HEDRICK date 3-12-07

Authorization to Construct by: STEVE HEDRICK date 3-24-06 Existing System Inspection by: ____ date ____

HEALTH DEPT. COPY: WHITE OWNER COPY (FINAL): YELLOW OWNER COPY (INITIAL): PINK