IREDELL COUNTY HEALTH DEPARTMENT

THIS PERMIT REPLACES EXPIRED PERMITS ~~NUMBERED~~ 20462 & 20445

STATESVILLE 704-878-5305 MOORESVILLE 704-664-5281

IMPROVEMENT PERMIT / AUTHORIZATION TO CONSTRUCT / OPERATION PERMIT / EXISTING SYSTEM INSPECTION

PERMIT# ~~107957~~ 129/13 PIN# 3774-73-2506 1523 DATE 8-12-02

OWNER OR CONTRACTOR EDWARD & PAULA MIMNAUSH PHONE: Business c/o 704-488-8099 Home 301-642-0511

ADDRESS 18800 JADE CT GAITHERSBURG, MD 20879

LOCATION SHARON SCH RD TO STEWART ROCK RD, TL FULBRIGHT RD, TR RIVERCLIFF RD, 5TH LOT ON RIGHT PAST OVERLOOK DRIVE

SUBDIVISION RIVERWALK BLOCK / SECTION III LOT 27/28 LOT AREA 2.5392 Acres SITE CLASS. PS DESIGN FLOW 480 L.T.A.R. 0.30 GPD/FT²

Septic Tank: 1000 Gallons; STB 160 Date 9-16-05
Pump Tank: ____ Gallons; PT ____ Date ____
Pump Make: ____ Model ____ Serial No. 400
Nitrification Field: No Fields 1 Square Feet 1600 Linear Feet 540
No Lines SIX 4 Trench Width 36" Max Trench Bottom Depth 30" Gravel Depth 12"

☑ New System ☐ Repair System Type: I (II) III. IV. V. VI
System Description: CONVENTIONAL, GRAVITY
Repair System Description: CONVENTIONAL, PUMP
Maintenance Agreement Required: ☐ Yes ☑ No


☑ House/Mod. Home No. Bedrooms 4
☐ Mobile Home No. Bathrooms 3
☐ Business No. Employees ____
☐ Other ____
☐ Slab ☑ Crawl Space ☑ Basement w/plumbing ☐ Basement wo/plumbing

Water Supply: ☑ Individual ☐ Public ☐ Community
WELL


Comments:/Conditions: INSTALL LINES ON CONTOUR, NO DEEPER THAN 30 INCHES.

Comments:/Conditions: ① SEPTIC TANK WITH MARKER, INSTALLED USING "ZABEL" FILTER ② AN "ACCEPTED" SYSTEM WAS INSTALLED USING 100 "QUICK-4" CHAMBERS

INITIAL SITE SKETCH

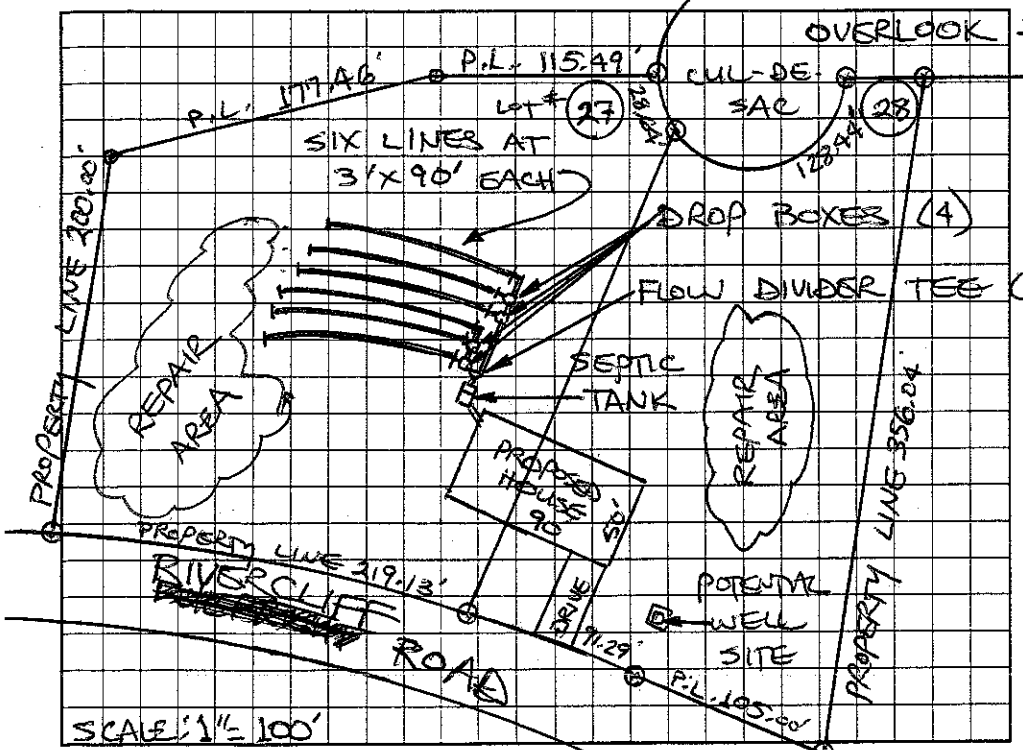

AS BUILT SKETCH

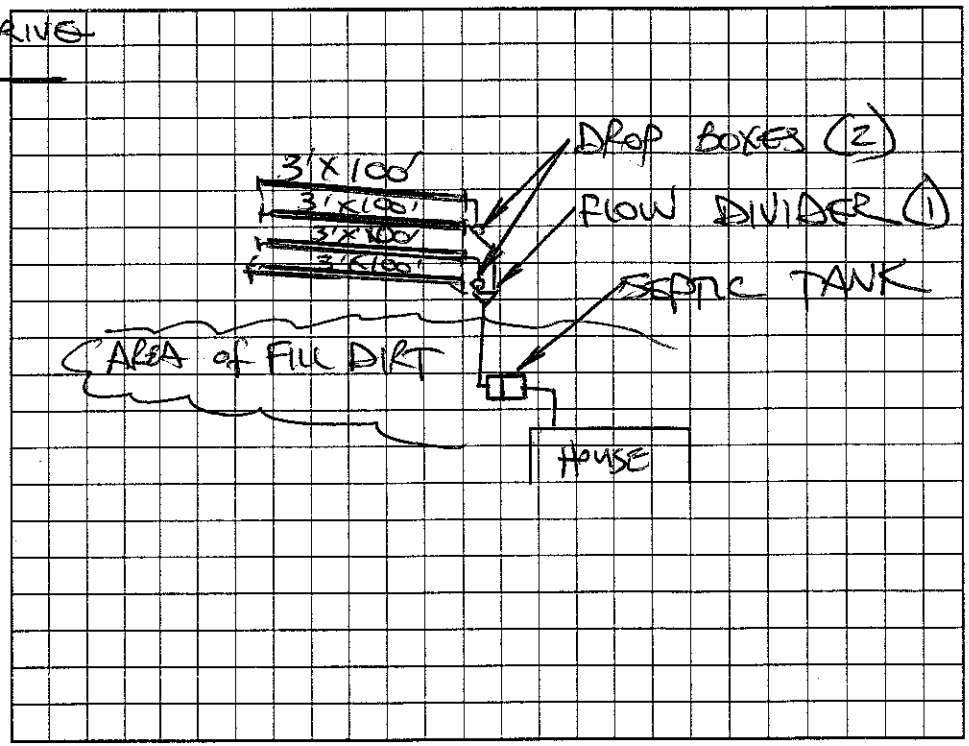

Permit can be suspended or revoked if any false information is supplied toward securing the permit/any unauthorized changes are made to the site/any unauthorized changes are made in the installation of the system. Improvement Permit with plat valid without expiration. Improvement Permit with site plan valid for sixty months. Authorization to Construct is valid for a period equal to that of Improvement Permit – not to exceed sixty months.

Signed: Susan Bolich date 8-14-02 Installed by: KEITH WILLIAMS

Improvement Permit by: STEVE HEDRICK date 8-12-02 Operation Permit by: STEVE HEDRICK date 1-20-06

Authorization to Construct by: STEVE HEDRICK date 8-12-02 Existing System Inspection by: ____ date ____

HEALTH DEPT. COPY: WHITE OWNER COPY (FINAL): YELLOW OWNER COPY (INITIAL): PINK