TIM & DONNA HEATHERLY

IREDELL COUNTY HEALTH DEPARTMENT

THIS PERMIT VOIDS PREVIOUS ISSUED 8-13-96

STATESVILLE 704-878-5305 MOORESVILLE 704-664-5281

IMPROVEMENT PERMIT / AUTHORIZATION TO CONSTRUCT / OPERATION PERMIT / EXISTING SYSTEM INSPECTION

PERMIT# 72499 24477 PIN# 8R-2-D-19 DATE 3-6-98

OWNER OR CONTRACTOR KEJ MARKETING PHONE: Business 878-9012 Home 838-0463

ADDRESS TIM & DONNA HEATHERLY, 144 HALLMARK EST, STATESVILLE NC 28625

LOCATION I-40 W, TR SHARON CHURCH RD, TL STEWART ROCK TL FULBRIGHT, TR RIVERCLIFF 3RD LOT ON LEFT

SUBDIVISION RIVERWALK BLOCK / SECTION IV LOT 19 LOT AREA 1.723 ACRES SITE CLASS. PS DESIGN FLOW 360' L.T.A.R. 0.30 GAL/FT²

Septic Tank: 1000 Gallons; STB 1012 Date 9-28-97
Pump Tank: ____ Gallons; PT ____ Date ____
Pump Make: ____ Model ____ Serial No. ____
Nitrification Field: No Fields 1 Square Feet EQ. TO 1200 Linear Feet 300+
No Lines FIVE Trench Width 36" Max Trench Bottom Depth 36" Actual Depth 24"&6"

☑ New System ☐ Repair System Type: I II III IV V VI
System Description: CHAMBERED GRAVITY
Repair System Description: CHAMBERED GRAVITY
Maintenance Agreement Required: ☐ Yes ☑ No

☑ House/Mod. Home ☐ Mobile Home ☐ Business ☐ Other
No. Bedrooms 3 No. Bathrooms 2 No. Employees ____

☐ Slab ☑ Crawl Space ☐ Basement w/plumbing ☐ Basement wo/plumbing


Water Supply: ☑ Individual ☐ Public ☐ Community
WELL

Comments:/Conditions: ① KEEP SYSTEM MINIMUM 100' FROM WELL ② INSTALL 50 CHAMBERS IN FIVE EQUAL LENGTH LINES ON CONTOUR AS SHOWN.


Comments:/Conditions:

PAST PER POINT DRIVE

INITIAL SITE SKETCH SCALE: 1"=60'

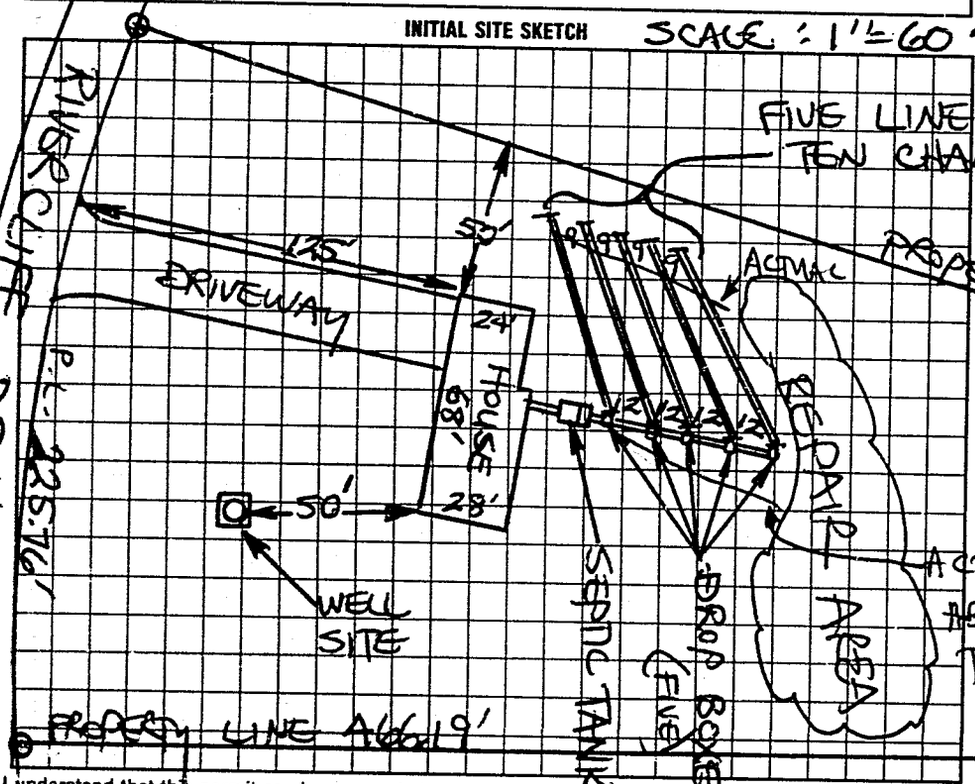

AS BUILT SKETCH

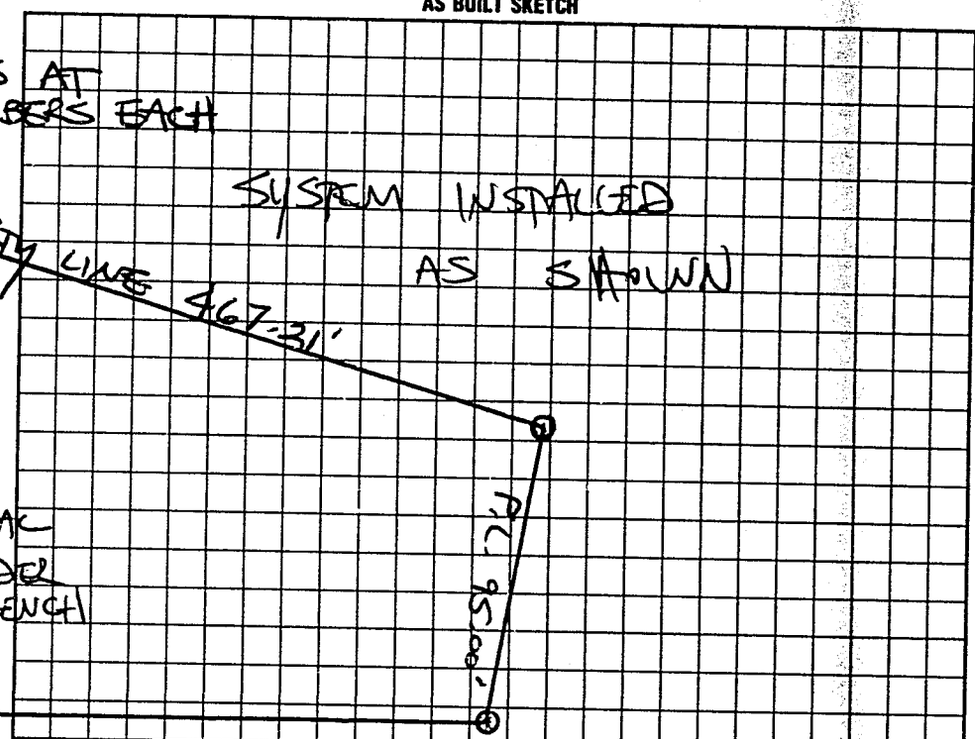

I understand that this permit can be suspended or revoked if any false information is supplied toward securing the permit/any unauthorized changes are made to the site/any unauthorized changes are made in the installation of the system. Improvement Permit with plat valid without expiration. Improvement Permit with site plan valid for sixty months. Authorization to Construct is valid for a period equal to that of Improvement Permit – not to exceed sixty months.

Signed: R. Heatherly date ____ Installed by: HARVEY LEATHERMAN

Improvement Permit by: STEVE HEDRICK date 3-6-98 Operation Permit by: STEVE HEDRICK date 6-3-98

Authorization to Construct by: STEVE HEDRICK date 3-6-98 Existing System Inspection by: ____ date ____

HEALTH DEPT. COPY: WHITE INSPECTION COPY (FINAL): GREEN OWNER COPY (FINAL): YELLOW INSPECTION COPY (INITIAL): PINK OWNER COPY (INITIAL): GOLD