IREDELL COUNTY HEALTH DEPARTMENT

IMPROVEMENT PERMIT / AUTHORIZATION TO CONSTRUCT / OPERATION PERMIT / EXISTING SYSTEM INSPECTION

STATESVILLE 704-878-5305 SC MOORESVILLE 704-664-5281

PERMIT# 11663 9 PIN# 3774734797

OWNER OR APPLICANT DeAyne Miller PHONE: Business 828-327-3789 Home 828-308-6157 DATE 5 December 07

ADDRESS 1508 4th Ave SE Hickory, NC 28602

LOCATION Shaw School Rd. TL Heth-Lv. TR 2nd Riverwalk TR Riverdiff - lot on Rt

SUBDIVISION Riverwalk BLOCK / SECTION III LOT 30 LOT AREA SITE CLASS. P3 DESIGN FLOW 360 gpd L.T.A.R. 0.3/1.7 gpd

Septic Tank: 1000 Gallons: STB 160 Date 4-18-08

Pump Tank: Gallons: PT Date

Pump Make: Model Serial No.

Nitrification Field: No Fields 1 Square Feet 1200 Linear Feet 300

No Lines 3 Trench Width 36 Max Trench Bottom Depth 30"

☑ New System ☐ Repair ☐ Expansion System Type: I II III IV V VI

System Description: 25% Reduction

Repair System Description: 25% Reduction

Maintenance Agreement Required: ☐ Yes ☒ No

Gravity ☐ Pressure ☐ Slab ☒ Crawl Space ☐ Basement w/plumbing ☐ Basement wo/plumbing

☒ House/Mod. Home No. Bedrooms 3

☐ Mobile Home No. Persons

☐ Business No. Employees

☐ Other

Water Supply: ☒ Individual ☐ Public ☐ Community

Comments:/Conditions:

Follow contour / House setbacks

Comments:/Conditions:

Filter install & Marker install

INITIAL SITE SKETCH

Please See Attached Layout

AS BUILT SKETCH

Install as Drawn on Layout Plan

rmit can be suspended or revoked if any false information is supplied toward securing the permit/any unauthorized changes are made to the site/any unauthorized changes are made in the installation of the system. Improvement
rmit with plat valid without expiration ☐ Improvement Permit with site plan valid for sixty months ☑ Authorization to Construct is valid for a period equal to that of Improvement Permit – not to exceed sixty months.

ed: DeAyne Miller

ovement Permit by: R.S. date 5/12/17

rization to Construct by: R.S. date 5 Dec. 07

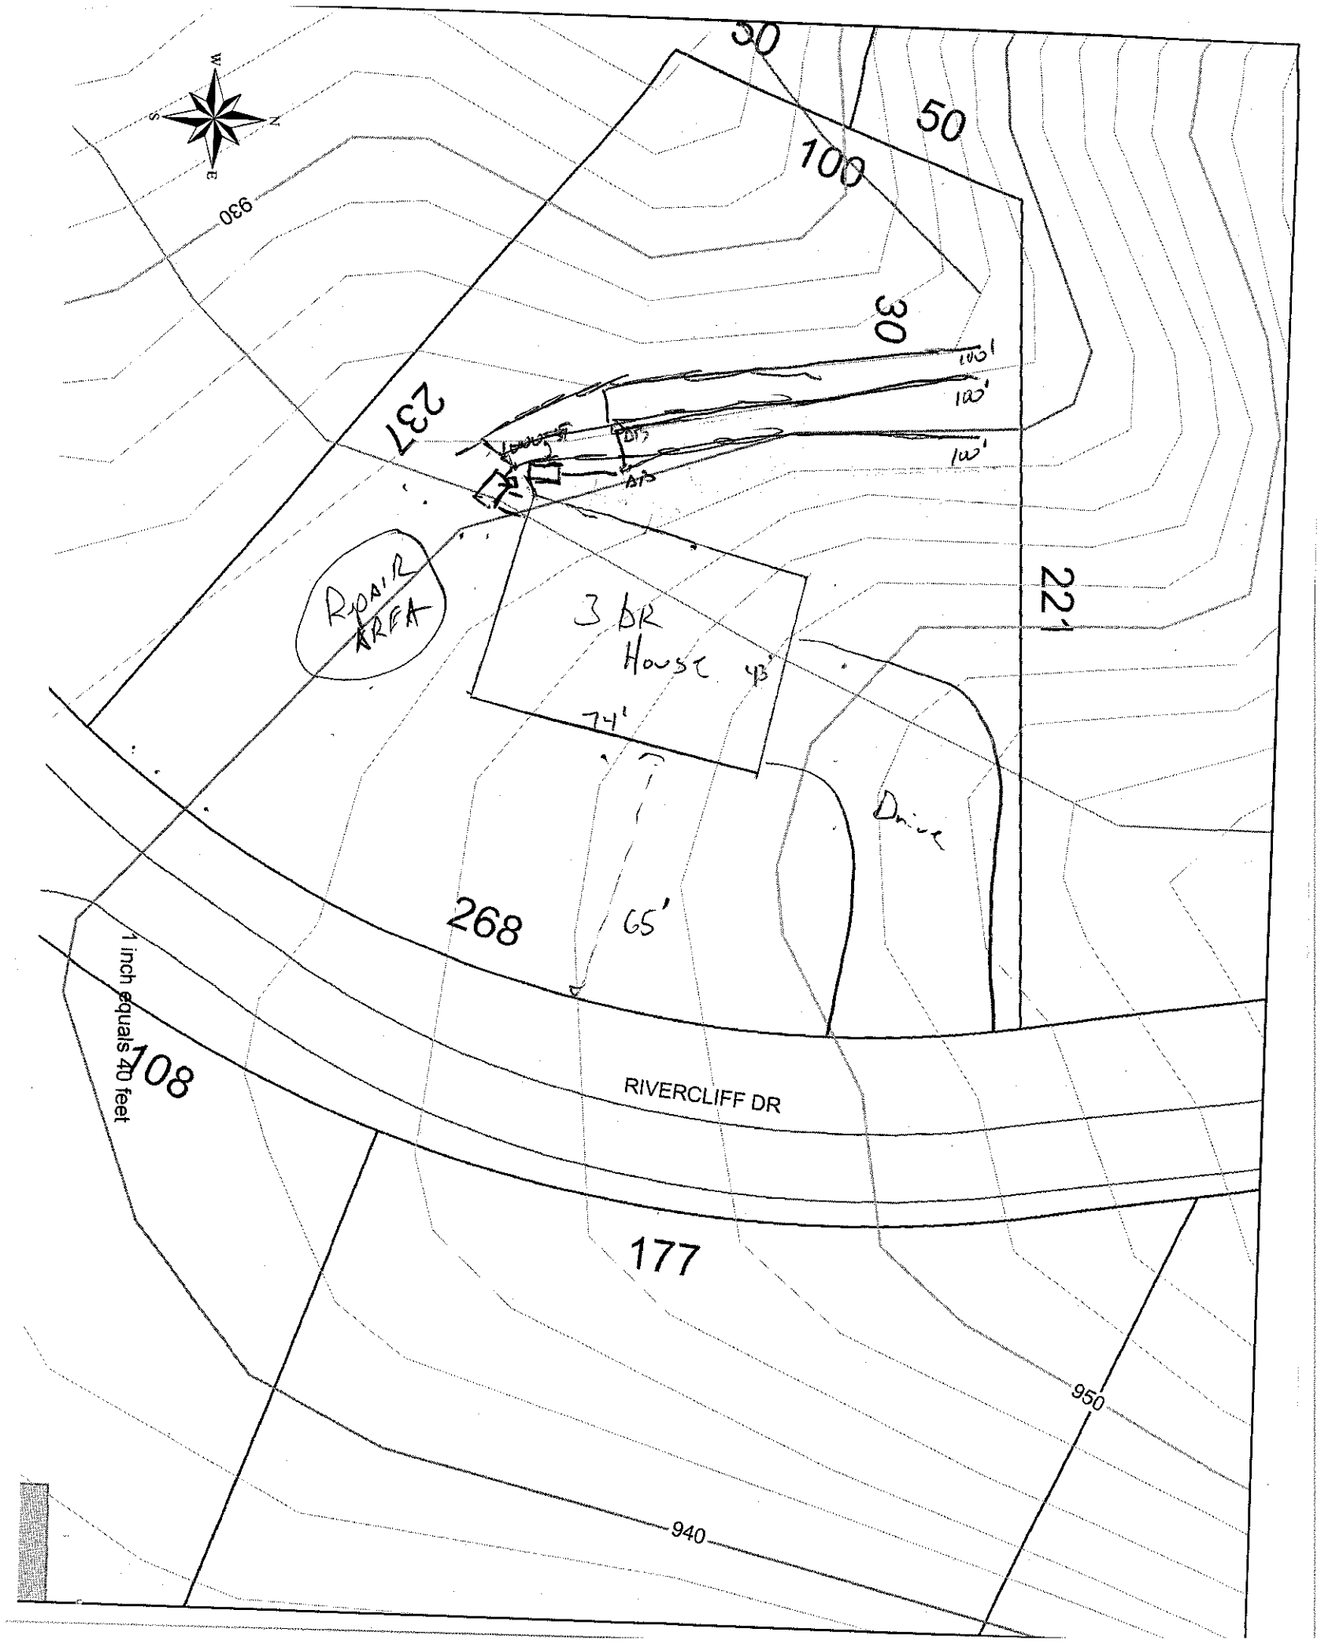
Installed by: Scott Green

Operation Permit by: R.S. date 5 Dec. 07

Existing System Inspection by: date 12 June 08

date

HEALTH DEPT. COPY: WHITE OWNER COPY (FINAL): YELLOW OWNER COPY (INITIAL): PINK


N
S
E
W
930
30
50
100
30
237
100'
100'
100'
3 BR
House
43'
74'
221
Drive
268
65'
108
1 inch equals 40 feet
RIVERCLIFF DR
177
950
940