IREDELL COUNTY HEALTH DEPARTMENT

THIS PERMIT VOIDS PREVIOUS EXPIRED #24473

STATESVILLE 704-878-5305 MOORESVILLE 704-664-5281

IMPROVEMENT PERMIT / AUTHORIZATION TO CONSTRUCT / OPERATION PERMIT / EXISTING SYSTEM INSPECTION

PERMIT# 126123 PIN# 3774-73-6085 DATE 3-21-05

OWNER OR CONTRACTOR SUMMERWOOD HOMES LLC PHONE: Business (704) 799-8055 Home

ADDRESS 173 WEST MARANTHA RD. MOORESVILLE NC 28117

LOCATION I-40 TR SHARON SCHOOL RD. TL STEWART ROCK TL FULBRIGHT TR GARDNER POINT TR RIVERCLIFF TL PIERPOINT 3RD ON RT

SUBDIVISION RIVERWALK BLOCK / SECTION IV LOT 15 LOT AREA 1.20 SITE CLASS. PS DESIGN FLOW 360 L.T.A.R. 0.30 gpd/ft²

Septic Tank: 1000 Gallons; STB 312 Date 6-27-05
Pump Tank: ____ Gallons; PT ____ Date ____
Pump Make: ____ Model ____ Serial No. ____
Nitrification Field: No Fields 1 Square Feet 1200 Linear Feet 300
No Lines 4 Trench Width 36" Max Trench Bottom Depth 30"

☑ New System ☐ Repair System Type: I, II, ③ IV, V, VI
System Description: GRAVITY 25% REDUCTION
Repair System Description: LP PANEL 50% REDUCTION
Maintenance Agreement Required: ☐ Yes ☑ No

Gravel Depth N/A
☐ Slab ☐ Crawl Space ☑ Basement w/plumbing ☐ Basement wo/plumbing


☑ House/Mod. Home No. Bedrooms 3
☐ Mobile Home No. Bathrooms ____
☐ Business No. Employees ____
☐ Other ____

Water Supply:
☑ Individual
☐ Public
☐ Community


Comments/Conditions: ① INSTALL LINES NO DEEPER THAN 30" ON CONTOUR ③ MAINTAIN SETBACKS

Comments/Conditions: DRAW LINES TO RIGHT OF HEADER DITCH INSPECTED 8-5-05 - OK LC DRAW LINES TO LEFT OF HEADER DITCH INSPECTED 8-8-05. HAD 4" FALL PER FOOT - OK, LC

INITIAL SITE SKETCH

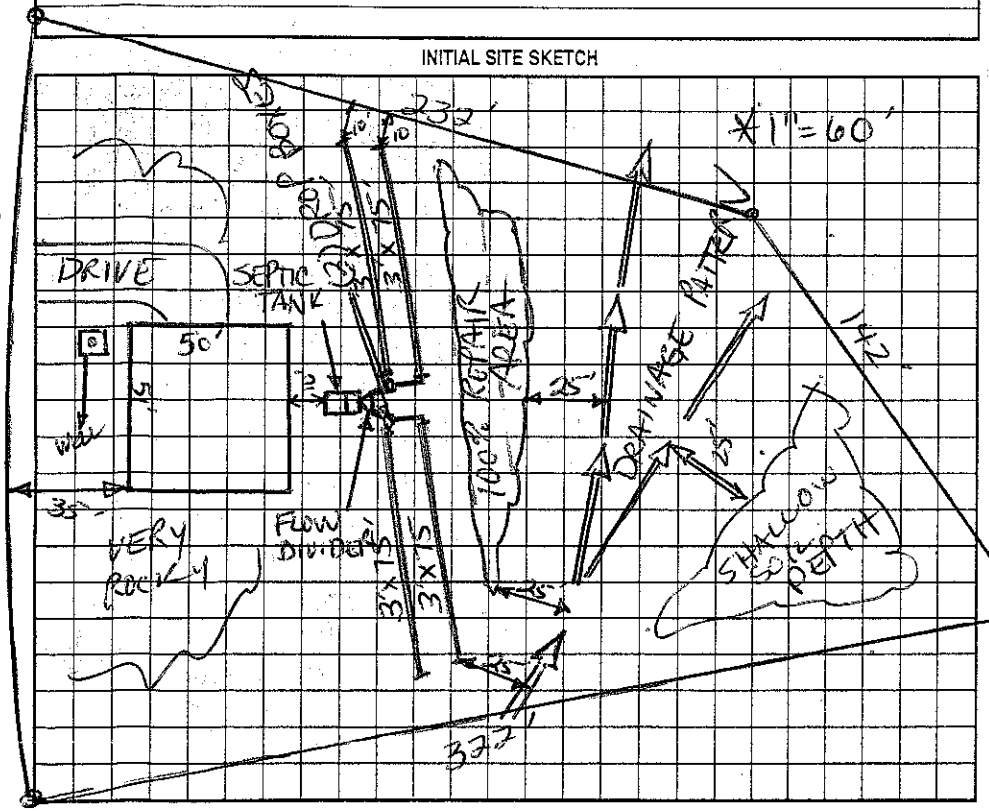

AS BUILT SKETCH

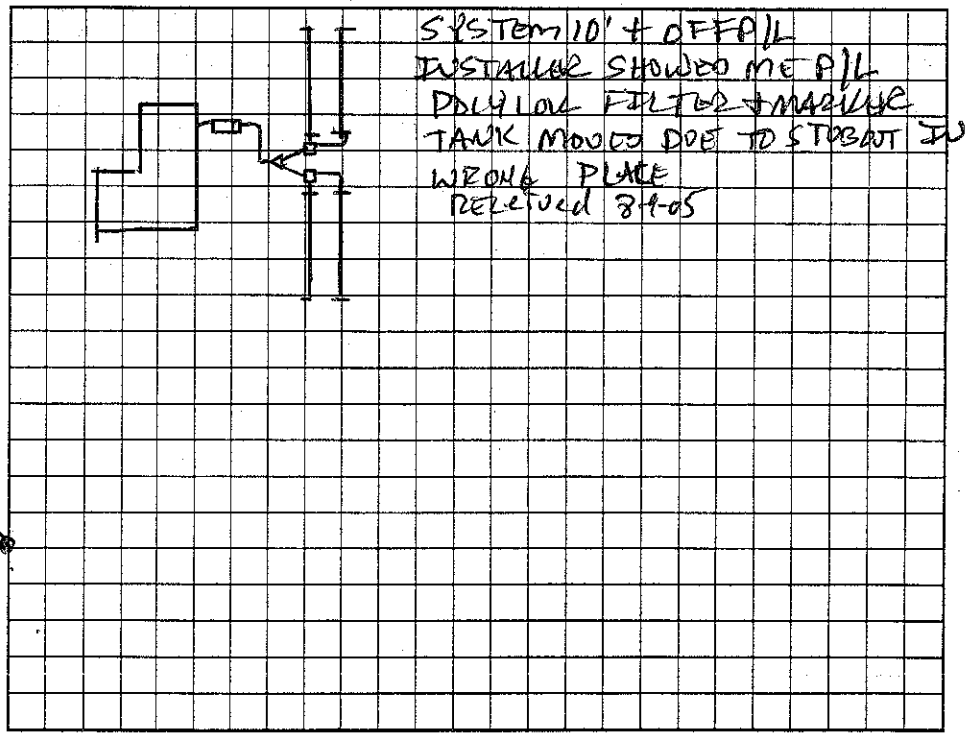

Permit can be suspended or revoked if any false information is supplied toward securing the permit/any unauthorized changes are made to the site/any unauthorized changes are made in the installation of the system. Improvement Permit with plat valid without expiration. Improvement Permit with site plan valid for sixty months. Authorization to Construct is valid for a period equal to that of Improvement Permit – not to exceed sixty months.

Signed: Ted Fox date 3-22-05 Installed by: LARRY FULLER

Improvement Permit by: Christopher M. Shelton, LRS, LSS date 3-21-05 Operation Permit by: [signature] date 8-9-05

Authorization to Construct by: Christopher M. Shelton, LRS, LSS date 3-21-05 Existing System Inspection by: ____ date ____

HEALTH DEPT. COPY: WHITE OWNER COPY (FINAL): YELLOW OWNER COPY (INITIAL): PINK