CI THIS PERMIT REPLACES EXPIRED PERMIT #024466

IREDELL COUNTY HEALTH DEPARTMENT

STATESVILLE 704-878-5305 MOORESVILLE 704-664-5281

IMPROVEMENT PERMIT / AUTHORIZATION TO CONSTRUCT / OPERATION PERMIT / EXISTING SYSTEM INSPECTION

PERMIT# 123699 PIN# 3774-73-8543 DATE 9-20-04

OWNER OR CONTRACTOR MARGARET BERTRAND PHONE: Business 704-896-4778 Home 704-252-1592

ADDRESS P.O. BOX 6, MOUNT MOURNE, NC 28123

LOCATION I-40 W TR SHARON SCHOOL RD, TL STEWART ROCK RD, TL FULBRIGHT RD, TR GARDNER POINT, TR RIVER CLIFF, ON LEFT AT PIER POINT

SUBDIVISION RIVERWALK BLOCK / SECTION IV LOT 2 LOT AREA 1.867 ACRES SITE CLASS. PS DESIGN FLOW _____ L.T.A.R. 0.30 GPD/FT²

Septic Tank: 1000 Gallons; STB 1012 Date 12-5-04
Pump Tank: _____ Gallons; PT _____ Date _____
Pump Make: _____ Model _____ Serial No. _____
Nitrification Field: No Fields 1 Square Feet 600 TO 1200 Linear Feet 300
No Lines ~~FOUR~~ SIX Trench Width 36" Max Trench Bottom Depth 36" Gravel Depth N/A

☑ New System ☐ Repair System Type: I, II, (III), IV, V, VI
System Description: 25% REDUCTION, GRAVITY
Repair System Description: 25% REDUCTION, GRAVITY
Maintenance Agreement Required: ☐ Yes ☑ No


☑ House/Mod. Home No. Bedrooms 3
☐ Mobile Home No. Bathrooms 6
☐ Business No. Employees ____
☐ Other _____
☐ Slab ☐ Crawl Space ☑ Basement w/plumbing ☐ Basement wo/plumbing

Water Supply: ☑ Individual ☐ Public ☐ Community WELL


Comments/Conditions: ① KEEP SYSTEM MINIMUM 100' FROM WELL ② CONTACT HEALTH DEPT. AFTER CLEARING & PRIOR TO INSTALLATION TO FLAG-OUT SYSTEM ③ INSTALL 25% REDUCTION SYSTEM ON CONTOUR AS FLAGGED.

Comments/Conditions: UPPER FOUR LINES INSPECTED 2-2-05 KM
TUFF TITE FILTER & RISER
V'D LAST TO LINES WELL IS 76+30+30 = 126' TO DRAIN FIELDS
✓ TANK (2-9-05)

INITIAL SITE SKETCH

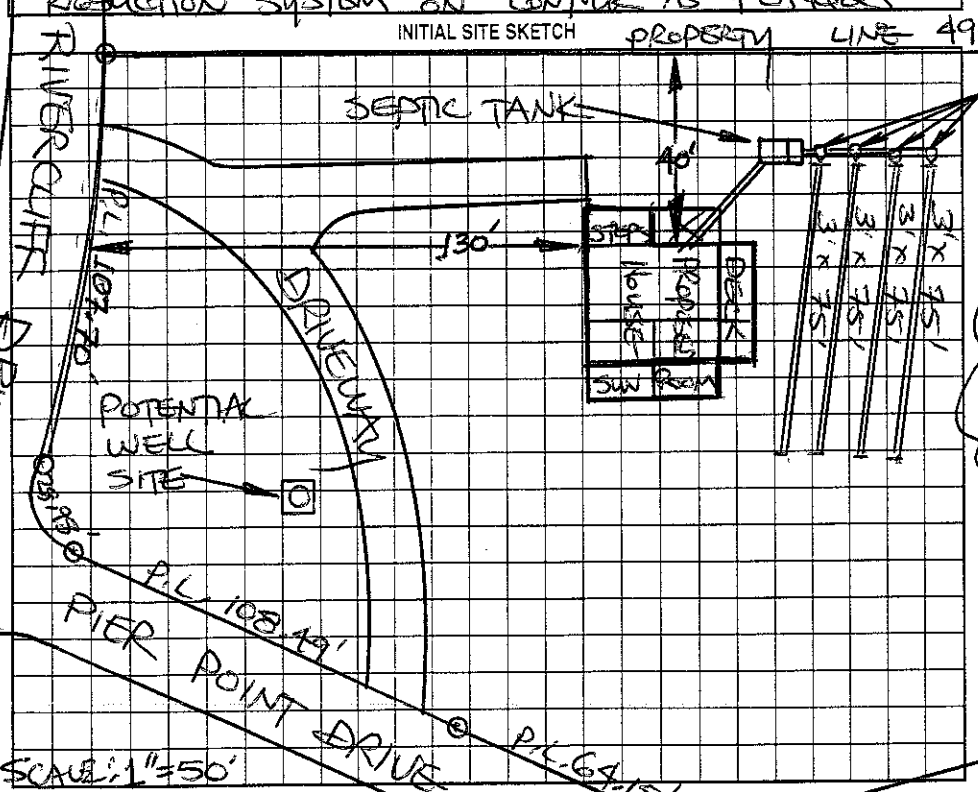

AS BUILT SKETCH

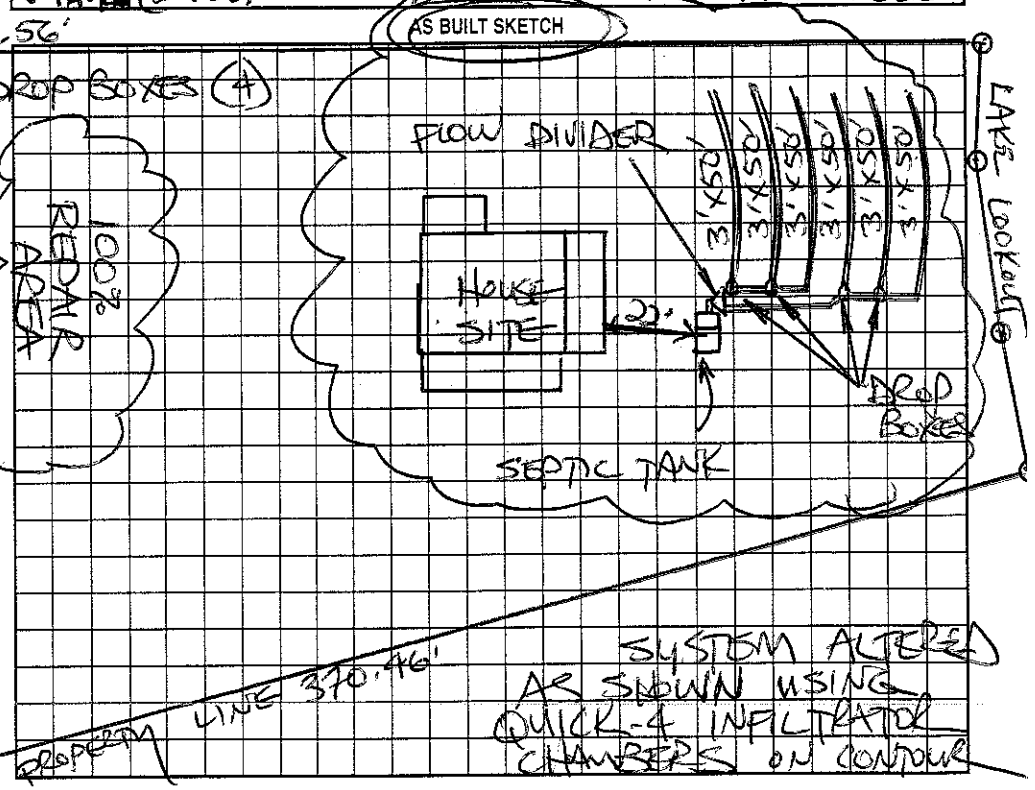

Permit can be suspended or revoked if any false information is supplied toward securing the permit/any unauthorized changes are made to the site/any unauthorized changes are made in the installation of the system. Improvement Permit with plat valid without expiration. Improvement Permit with site plan valid for sixty months. Authorization to Construct is valid for a period equal to that of Improvement Permit – not to exceed sixty months.

Signed: Margaret E Bertrand date 9/20/04 Installed by: CHARLES TOWNSEND

Improvement Permit by: STEVE HEDRICK date 9-20-04 Operation Permit by: _____ date 2-10-05

Authorization to Construct by: STEVE HEDRICK date 9-20-04 Existing System Inspection by: _____ date _____

HEALTH DEPT. COPY: WHITE OWNER COPY (FINAL): YELLOW OWNER COPY (INITIAL): PINK