# IREDELL COUNTY HEALTH DEPARTMENT

Statesville Office (704) 878-5305 Mooresville Office (704) 660-3625 PERMIT # 217764

## IMPROVEMENT PERMIT / AUTHORIZATION TO CONSTRUCT / OPERATION PERMIT / EXISTING SYSTEM

PIN # 3774738543 ✓

APPLICANT: Blue Ridge Pools APPLICANT ADDRESS: 827 Poplar Springs Rd

SITE ADDRESS: 105 Pier Point Dr. PHONE: 704-902-8489 ALT. PHONE: 704-251-3044

SITE DIRECTIONS: Sharon School Rd TL Stewart Rock Rd TL Fulbright TR Gardner Pt TR Rivercliff TL Pier Pt

SUBDIVISION: Riverwalk SECTION: 5A LOT # 2 LOT AREA: 1.87 acres DESIGN FLOW: Existing L.T.A.R.: Existing


| | | | | | | | |
|---|---|---|---|---|---|---|---|
| Septic Tank | Existing (gal) | STB | Date | ☐ New System ☐ Repair ☐ Expansion | System Type: I II (III) IV V VI | ☑ Residence | No. Bedrooms Ex |
| Pump Tank | (gal) | PT | Date | System Description: | Existing | ☐ Business | No. Persons Ex |
| Pump Make | Model | | Serial # | Repair System Description: | | ☐ Other | No. Employees |
| # Nitrification Fields | Ex # Lines Ex | | Linear Ft: Ex | Maintenance Agreement Required: | ☐ YES ☑ NO | ☐ Slab | ☐ Crawl Space |
| Trench Width | Ex Max. Trench Bottom Depth Ex | | Gravel Depth Ex | | ☐ GRAVITY ☐ PRESSURE | ☑ Basement w/plumbing | ☐ Basement w/o plumbing |

**Water Supply**: ☑ Private ☐ Public ☐ Community


**Comments / Conditions:**

- maintain a minimum of 15' between proposed pool & all components of septic tank system.

INITIAL SITE SKETCH

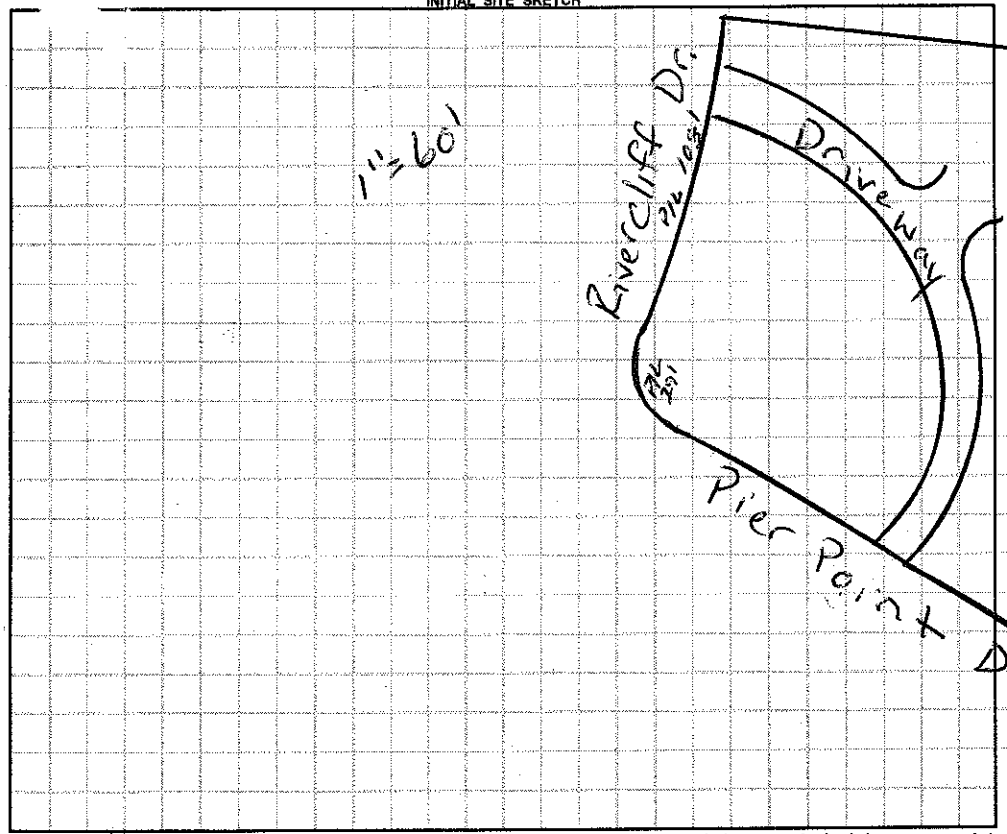


AS BUILT SKETCH

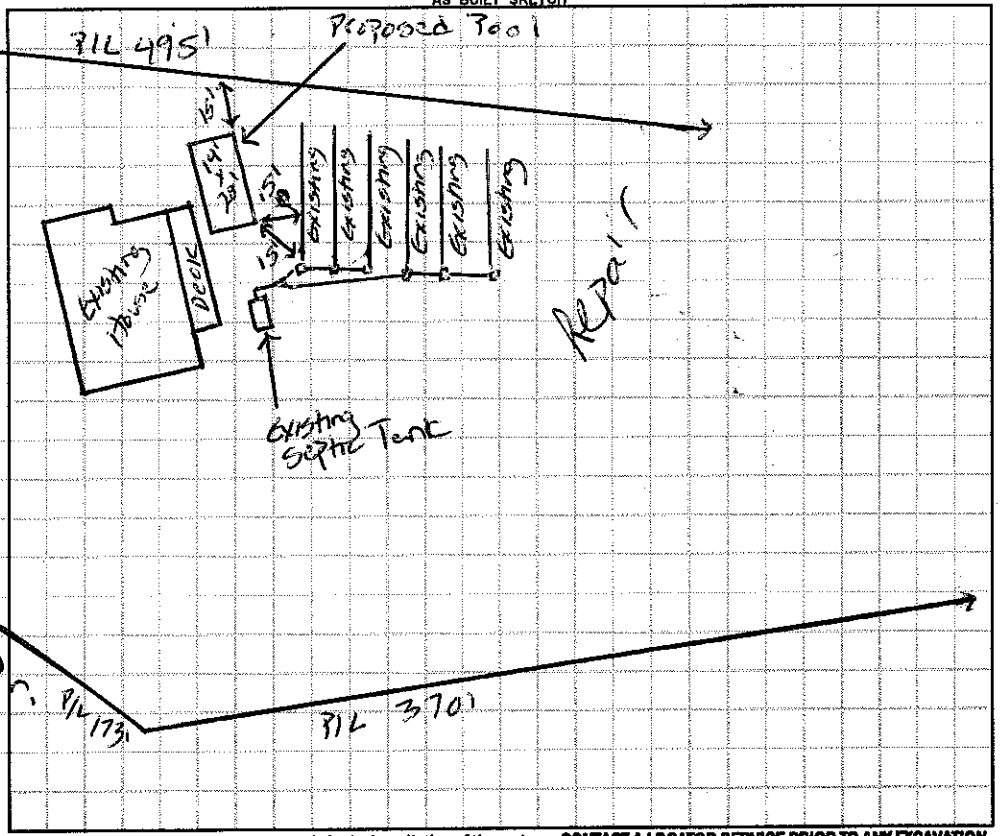


*Permit can be suspended or revoked if any false information is supplied toward securing the permit / any unauthorized changes are made to the site / any unauthorized changes are made in the installation of the system.* **CONTACT A LOCATOR SERVICE PRIOR TO ANY EXCAVATION**

☐ **IMPROVEMENT PERMIT** *with plat valid without expiration.* ☐ **IMPROVEMENT PERMIT** *with site plan valid for 60 mos.* ☐ **AUTHORIZATION TO CONSTRUCT** *valid for period equal to IMPROVEMENT PERMIT--not to exceed 60 mo.*

Owner / Applicant Signature: Harry McLain Date: Installed by:

IMPROVEMENT PERMIT by: Date: OPERATION PERMIT by: Date:

AUTHORIZATION TO CONSTRUCT by: Date: Existing System Inspected by: Justin Henderson Date: 5-17-16

Health Dept. Copy - WHITE Applicant (Final Approval) - YELLOW Applicant (Conditional Approval) - PINK