IREDELL COUNTY HEALTH DEPARTMENT

THIS PERMIT VOIDS PREVIOUS ISSUED 8-15-96

STATESVILLE 704-878-5305 MOORESVILLE 704-664-5281

IMPROVEMENT PERMIT / CERTIFICATE OF COMPLETION / OPERATION PERMIT / EXISTING SYSTEM INSPECTION

PROPERTY DESCRIPTION NO. 24468 0457022 DATE 11-30-96 TAX MAP NO. 8R-2-D-6 Watershed: ~~IV PA~~ ☒ No

OWNER OR CONTRACTOR DENNIS DUKES (KEJ MARKETING) PHONE: Business 464-4221 Home 465-2865

ADDRESS 1631 KENSINGTON CIRCLE NEWTON NC 28658

LOCATION FULBRIGHT ROAD TO RIVERCLIFF DRIVE, TL PIER POINT DRIVE, 5TH LOT ON LEFT

SUBDIVISION RIVERWALK BLOCK / SECTION IV LOT 6 LOT AREA 0.6668 AC SITE CLASS. P5 DESIGN FLOW 360 L.T.A.R. 0.30 GPD/FT²

Septic Tank: 1000 Gallons; STB 1012 Date 7-5-97

Pump Tank: _____ Gallons; PT _____ Date _____

Pump Make: _____ Model _____ Serial No. _____

Nitrification Field: No Fields 1 Square Feet ~~600~~ 1200 Linear Feet 200

No Lines FIVE Trench Width 24" Max Trench Bottom Depth 32" Gravel Depth 6"

☒ New System ☐ Repair System Type: I, II, III, IV, V, VI

System Description: PPBPS, GRAVITY

Repair System Description: LARGE DIAMETER PIPE

Maintenance Agreement Required: ☐ Yes ☐ No

☒ House/Mod. Home No. Bedrooms 3

☐ Mobile Home No. Bathrooms 2.5

☐ Business No. Employees ____

☐ Other


☐ Slab ☐ Crawl Space ☒ Basement w/plumbing ☐ Basement wo/plumbing

Water Supply: ☒ Individual ☐ Community ☐ Public WELL


Comments: ① INSTALL 45 PPBPS PANELS IN FIVE EQUAL LENGTH LINES ON CONTOUR USING SERIAL DISTRIBUTION ② KEEP SYSTEM MINIMUM 100' FROM WELL

Comments: System Sized for 3 Bedrooms

INITIAL SITE SKETCH

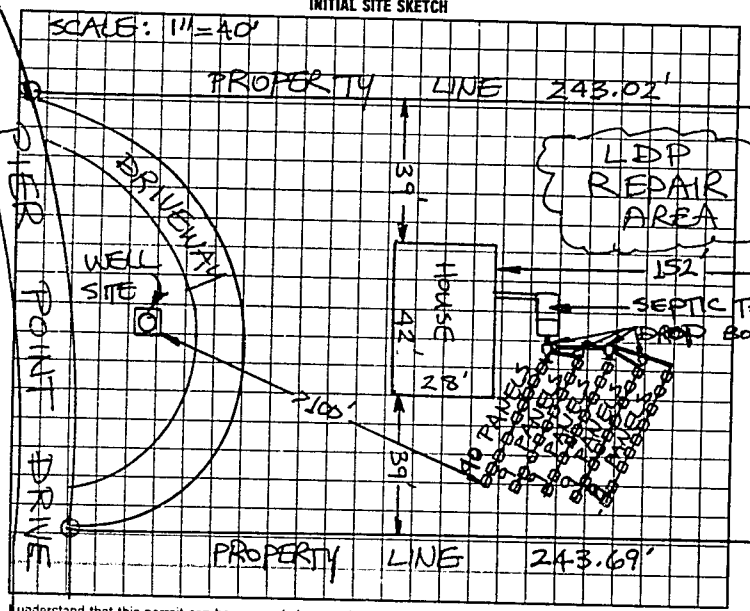

AS BUILT SKETCH

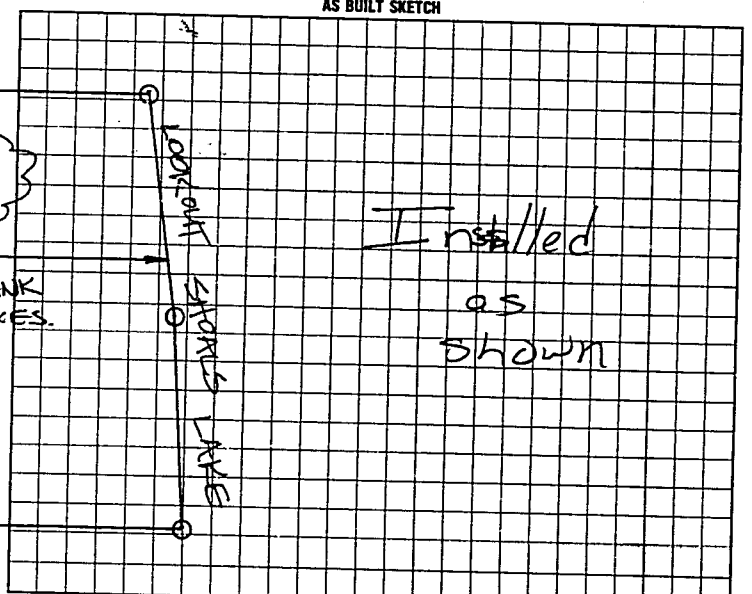

I understand that this permit can be suspended or revoked if any false information is supplied toward securing the permit/any unauthorized changes are made to the site/any unauthorized changes are made in the installation of the system. Auth. to Const. is valid for a period equal to the validity of the IP not to exceed five years. IP w/site plan is valid five years.

Signed: Dennis Dukes 12-4-96

Installed by: Donald Lackey

Permit Issued by: Authorization to Construct STEVE HEDRICK date 11-30-96

Certificate of Completion by: _____ date _____

Operation Permit by STEVE HEDRICK date 11-30-96

Operation Permit by Mark C Dietz RS date 10-8-97

APPLICANT COPY WHITE INSPECTION COPY (FINAL) GREEN OWNER COPY (FINAL) YELLOW INSPECTION COPY (INITIAL) PINK OWNER COPY (INITIAL) GOLD