IREDELL COUNTY HEALTH DEPARTMENT

STATESVILLE 704-878-5305 MOORESVILLE 704-664-5281

IMPROVEMENT PERMIT / AUTHORIZATION TO CONSTRUCT / OPERATION PERMIT / EXISTING SYSTEM INSPECTION

PERMIT# 20450 / 87024 PIN# TAX MAP 8 R Z C-33 DATE June 22 2000

OWNER OR CONTRACTOR Jerry R. Phillips PHONE: Business 828 632-5679 Home 704-427-3988

ADDRESS 20 Jarrell Garden Ln Taylorsville NC

LOCATION Sharon Sch Rd (R) off I40 To end Turn ~~Left~~ Stewart Rock ~~Right~~ Left Turn Gardner Point (R) Fulbright (R) Riverchff on Right

SUBDIVISION Riverwalk BLOCK / SECTION III LOT 33 LOT AREA 1.069 Ac SITE CLASS. PS DESIGN FLOW 240 L.T.A.R. .27 plus Corner of Rockcliff Riverwalk

Septic Tank: 1000 Gallons; STB 821 Date 6/9/00

Pump Tank: _____ Gallons; PT _____ Date _____

Pump Make: _____ Model _____ Serial No. _____

Nitrification Field: No Fields 1 Square Feet 900 Linear Feet 300

No Lines 3 Trench Width 36" Max Trench Bottom Depth 36" Gravel Depth 12"

☑ New System ☐ Repair System Type: I, (II), III, IV, V, VI

System Description: Conventional Gravity

Repair System Description: Pump Reduction pass.bk

Maintenance Agreement Required: ☐ Yes ☑ No

☐ Slab ☐ Crawl Space ☑ Basement w/plumbing ☐ Basement wo/plumbing

☑ House/Mod. Home No. Bedrooms 2

☐ Mobile Home No. Bathrooms 2

☐ Business No. Employees ____


☐ Other ____

Water Supply: ☐ Individual ☐ Public ☐ Community WELL

Comments/Conditions: Set Septic Tank as high As Possible
To begin septic Lines As Flagged
No PARKing over septic Tank
Divert gutter & foundation drains Away From System

Comments/Conditions: Zabel Filter used

INITIAL SITE SKETCH Not To Scale

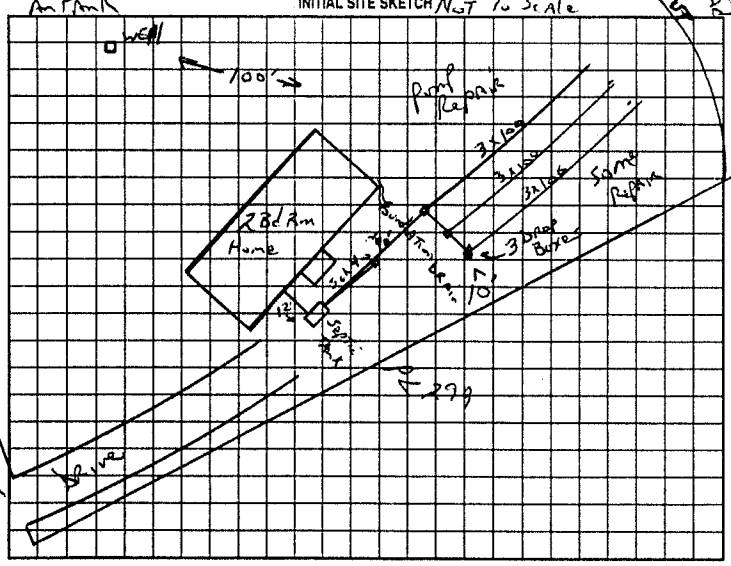

AS BUILT SKETCH

System Installed As Designed
Top Line deeper than 36" in 40" Depth

Permit can be suspended or revoked if any false information is supplied toward securing the permit/any unauthorized changes are made to the site/any unauthorized changes are made in the installation of the system. Improvement Permit with plat valid without expiration; Improvement Permit with site plan valid for sixty months. Authorization to Construct is valid for a period equal to that of Improvement Permit – not to exceed sixty months.

Signed: Jerry R Phillips date 6/23/00 Installed by: D + D Grading

Improvement Permit by: Lyc Potter date June 22 2000 Operation Permit by: Lyc Potter date July 26 2000

Authorization to Construct by: Lyc Potter date June 22 2000 Existing System Inspection by: _____ date _____

HEALTH DEPT. COPY: WHITE OWNER COPY (FINAL): YELLOW OWNER COPY (INITIAL): PINK