IREDELL COUNTY HEALTH DEPARTMENT

Replaces Perm:1 16 Mar/07 (ad)

STATESVILLE 704-878-5305 (ad) MOORESVILLE 704-664-5281

IMPROVEMENT PERMIT / AUTHORIZATION TO CONSTRUCT / OPERATION PERMIT / EXISTING SYSTEM INSPECTION

PERMIT # 141935 PIN # 3774-74-3485 DATE 18 May 09

OWNER or APPLICANT Marie Rhone PHONE: Business Home: (704) 898-4445

OWNER or APPLICANT ADDRESS 1001 East WT Harris Blvd. Charlotte NC.

LOCATION / DIRECTIONS 196 Rivercliff Dr, Stoney Point, N.C. 28678

SUBDIVISION Riverwalk BLOCK / SECTION III LOT # 34 LOT AREA 1.219ac. DESIGN FLOW 360g/d L.T.A.R. 0.3g/Ft²/day

Septic Tank 1000 Gallons: STB 1009 Date 9-23-09

Pump Tank 1000 Gallons: PT 274 Date 7-1-09

Pump Make Zoeller Model N152-B Serial # 1hp

Nitrification Field No Fields 1 No Lines 3 Linear Feet 300

Trench Width 36" Max. Trench Bottom Depth 36" Gravel Depth NA

☑ New System ☐ Repair ☐ Expansion System Type I II (III) IV V VI

System Description: 25% Reduction

Repair System Description: 50% Reduction - LPP

Maintenance Agreement Required ☐ YES ☑ NO

☐ GRAVITY ☑ PRESSURE

☑ Residence No. Bedrooms 3

☐ Business No. Persons

☐ Other No. Employees

☐ Slab ☐ Crawl Space

☑ Basement w/plumbing ☐ Basement w/o plumbing

Water Supply: ☑ Private ☐ Public ☐ Community


Comments / Conditions: Follow contour with septic system. Pump specs. are approx. and Final determination will be made when plumbing elevations Finalized. Manifold requirements Attached.

Comments / Conditions: ST Filter - polylock

INITIAL SITE SKETCH

Please see Attached Site Sketch.

AS BUILT SKETCH

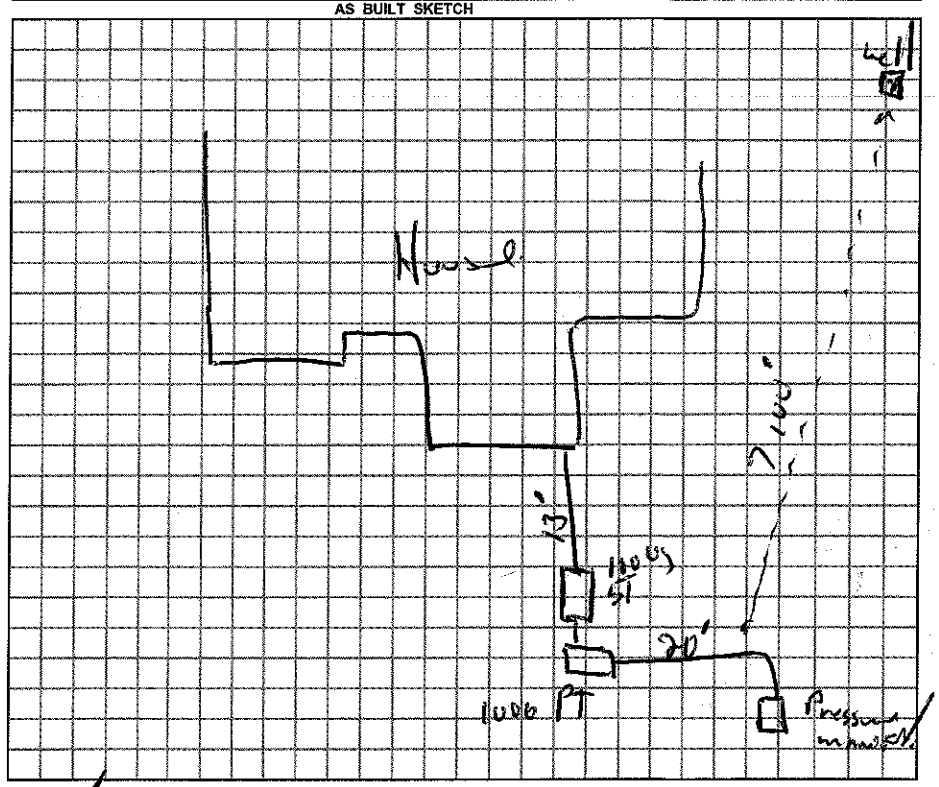

Permit can be suspended or revoked if any false information is supplied toward securing the permit / any unauthorized changes are made to the site / any unauthorized changes are made in the installation of the system.

☐ IMPROVEMENT PERMIT w / plat valid without expiration ☑ IMPROVEMENT PERMIT w / site plan valid for 60 mos. ☑ AUTHORIZATION TO CONSTRUCT valid for period equal to IMPROVEMENT PERMIT-not to exceed 60 mo.

Owner / Applicant Signature: Marie Rhone Date 5-19-09

Improvement Permit by: , R.S. Date 18 Mar/09

Authorization to Construct by: , R.S. Date 18 Mar/09

Installed by: Kevin Boles

Operation Permit by: , R.S. Date: 6 Nov. 09

Existing System Inspected by: Date:

YOU SHOULD CONTACT A LOCATOR SERVICE PRIOR TO ANY EXCAVATION!

WHITE COPY Environmental Health YELLOW COPY (Final) Owner / Applicant PINK COPY (Initial) Owner / Applicant


3774-74-0706
125
950
1
3774-74-4615
143
271
3774-64-9664
125
WOOD COVE LN
275
940
34
183
125
960
RIVERCLIFF DR
3774-74-931
Well AREA
Repair AREA
Repair AREA
Garage
139
3774-64-8485
299
3774-74-809
980
88
33
145
970
54
3774-74-3299
217
OVER LOOK DR
3774-64-9635
296
1 inch equals 50 feet
OVER LOOK DR