IREDELL COUNTY HEALTH DEPARTMENT

Statesville Office – Central Permitting (704) 878-5305 Mooresville Office (704) 660-3625


PRIVATE DRINKING WATER WELL PERMIT # 20883 **PIN #** 4722357222 **Type of Permit (circle one):** New Repair **Abandonment**

APPLICANT NAME: Josh Singleton ADDRESS: 138 chick Ln Union Grove NC PHONE: 704-735-7500

DIRECTIONS TO SITE: Buffalo Shoals T/L old mtn T/R Compton Park lot on right

SITE ADDRESS: 172 Compton Park Statesville NC SUBDIVISION: N/A SECTION/LOT: N/A

Initial Site Sketch

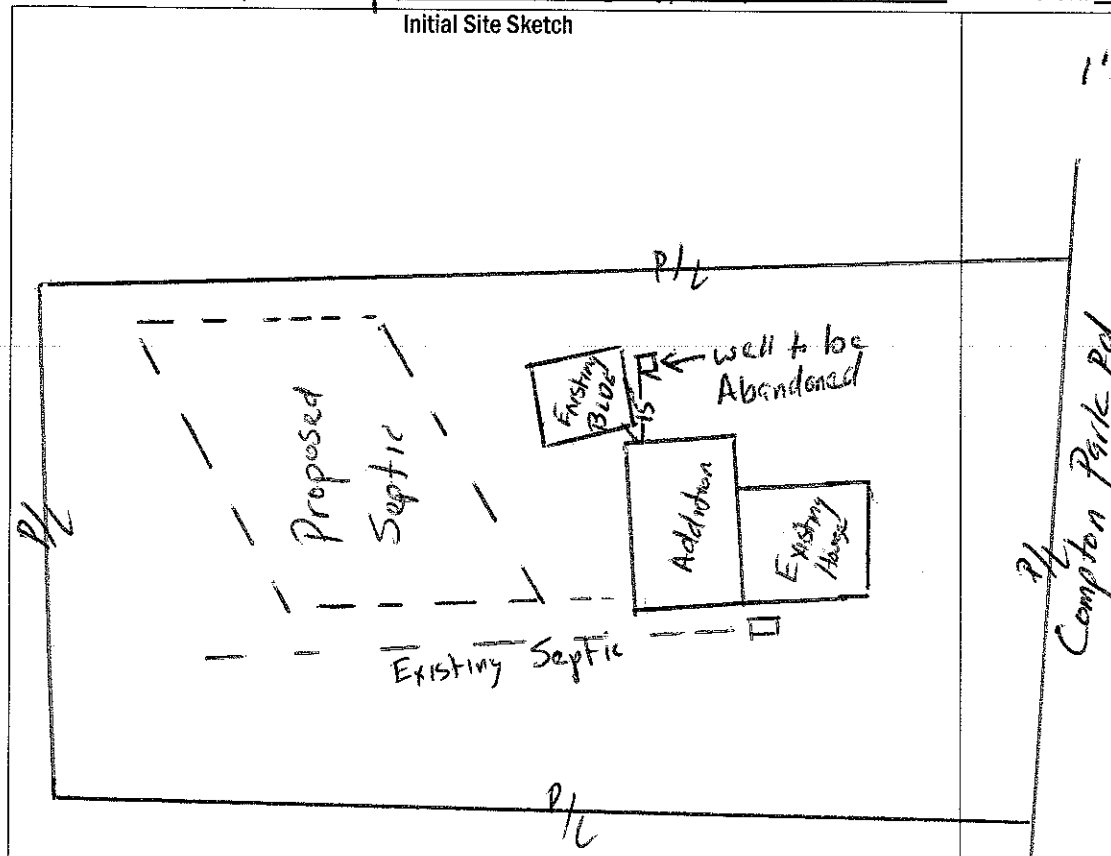

"As Built" Sketch

1"=50'

Well GPS Latitude: _____ Longitude: _____

PERMIT CONDITIONS/COMMENTS: Abandon per 2c rules

WELL PERMIT ISSUED BY: Debbie Allen DATE: 05/06/15 (Permit is valid for 5 years from date issued. This permit may be revoked if it is determined there has been a material change in any fact or circumstance upon which the permit is issued. Actions of the employees of the Iredell County Health Department shall in no way be taken as a guarantee that this well will produce water of any particular quantity or quality or for any amount of time. Employees of the Iredell County Health Department assume no liability for any damages, either direct or consequential which may be caused by this well.)

Well Contractor: Carolina Pump+Well CONTRACTOR CERT #: _____ GROUT INSPECTION BY: _____ DATE: _____

OR CERTIFICATION OF GROUT NOT WITNESSED BY DEPT: _____ DATE: 5-19-15 WELL HEAD INSPECTION BY: _____ DATE: _____

WELL HEAD INSPECTION (check when completed): GROUT TO GROUND SURFACE ☐ WELL CONTRACTOR ID PLATE ☐ PUMP INSTALLER ID PLATE ☐ SAMPLE PORT ☐

ACCESS PORT / VENT ☐ WELL SEAL ☐ WELL HEAD 12 INCHES / PITLESS ADAPTOR 8 INCHES ABOVE GRADE ☐

CERTIFICATE OF COMPLETION BY: Debbie Allen DATE: 06/02/15 WATER SAMPLES BY: _____ DATE: _____

Attachments: Form GW-1a (required except for abandonment) ☐ Form GW-30 ☑ Water Sample Results ☐ Plat ☐

Health Dept. Copy – White Applicant Certificate of Completion – Yellow Applicant Well Construction Permit - Pink