IREDELL COUNTY HEALTH DEPARTMENT Const. Auth. STATESVILLE 704-878-5305 MOORESVILLE 704-664-5281

IMPROVEMENT PERMIT / ~~CERTIFICATE OF COMPLETION~~ / OPERATION PERMIT / EXISTING SYSTEM INSPECTION

PROPERTY DESCRIPTION NO. 06B098 DATE Sept. 25, '97 TAX MAP NO. 3774749738 Watershed: ☑ Yes ☐ No

OWNER OR CONTRACTOR KEJ Marketing II Chris Dockey PHONE: Business _____ Home _____

ADDRESS PO Box 1627, Matthews 28106

LOCATION I40 Sharon Sch Rd N. TL Stewart Rock TL Fulbright TR Gardner Pt. on Right

SUBDIVISION Riverwalk BLOCK / SECTION 6 LOT 13 LOT AREA 8.24Ac / SITE CLASS PS DESIGN FLOW 360gpd L.T.A.R. ~.3

Septic Tank: 1000 Gallons; STB 901 Date 3 22 00

Pump Tank: _____ Gallons; PT _____ Date _____

Pump Make: _____ Model _____ Serial No. _____

Nitrification Field: No Fields 1 Square Feet 1200 Linear Feet 400

No Lines 4@100' Trench Width 36" Max Trench Bottom Depth 24" Gravel Depth 12"

☑ New System ☐ Repair System Type: I, II, III, IV, V, VI

System Description: Gravity Conventional

Repair System Description: Same

Maintenance Agreement Required: ☐ Yes ☑ No

☐ Slab ☐ Crawl Space ☑ Basement w/plumbing ☐ Basement wo/plumbing

☑ House/Mod. Home No. Bedrooms 3

☐ Mobile Home No. Bathrooms 3

☐ Business No. Employees _____


☐ Other _____

Water Supply: ☑ Individual ☐ Community ☐ Public

Comments: USE DROP BOXES FOR SERIAL DISTRIBUTION

Comments: ZABEL FILTER USED
DROP TEES USED

INITIAL SITE SKETCH 1" = 200'

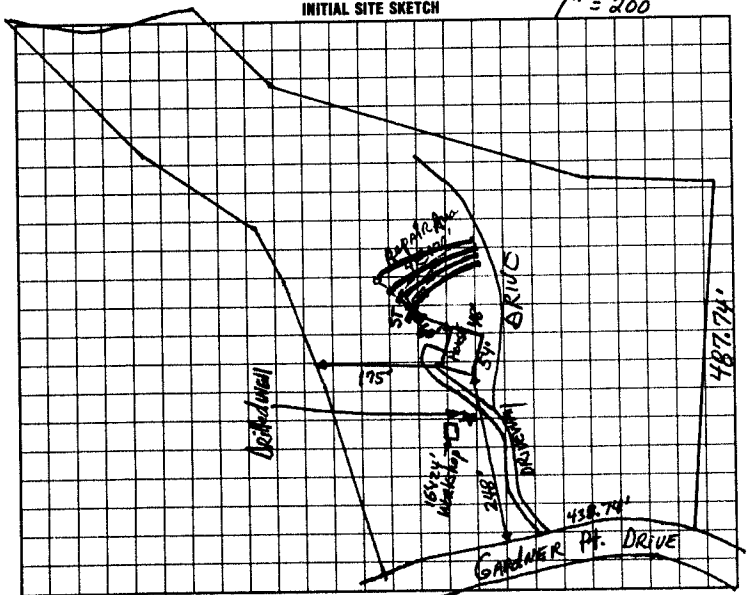

AS BUILT SKETCH

SYSTEM INSTALLED AS DESIGNED

I understand that this permit can be suspended or revoked if any false information is supplied toward securing the permit/any unauthorized changes are made to the site/any unauthorized changes are made in the installation of the system. Improvement Permit is valid for 60 months from date of issuance.

Signed: _____

Improvement Permit by: _____ date 9-25-97

CONSTRUCTION Authorization ~~Existing System Inspection~~ by: _____ date 10/1/97

Installed by: Cline & Gilleland

Certificate of Completion by: _____ date May 23 2000

Operation Permit by: _____ date _____

HEALTH DEPT. COPY: WHITE INSPECTION COPY (FINAL): GREEN OWNER COPY (FINAL): YELLOW INSPECTION COPY (INITIAL): PINK OWNER COPY (INITIAL): GOLD