This ~~Permit replaces~~ previous permit issued 9-22-06

IREDELL COUNTY HEALTH DEPARTMENT

Statesville Office (704) 878-5305 Mooresville Office (704) 660-3625 PERMIT # 201573

IMPROVEMENT PERMIT / AUTHORIZATION TO CONSTRUCT / OPERATION PERMIT / EXISTING SYSTEM

PIN # 3774771994

APPLICANT: Gary Dings APPLICANT ADDRESS: 135 Greentree Ln.

SITE ADDRESS: 359 Stewart Rock Dr. PHONE: 704-662-3479 ALT. PHONE: N/A

SITE DIRECTIONS: I-40W TR Sharon School Rd TL Stewart Rock Dr.


SUBDIVISION: Riverwalk SECTION: 9 LOT # 12 LOT AREA: 5.6 acres DESIGN FLOW: 360gpd L.T.A.R.: 0.03

Septic Tank	1000 (gal)	STB	76-1000	Date	4-9	☑ New System	☐ Repair	☐ Expansion	System Type: I (II) III IV V VI	☑ Residence	No. Bedrooms 3
Pump Tank	(gal)	PT		Date		System Description:			Conventional 25% Red.	☐ Business	No. Persons 6
Pump Make	Model			Serial #		Repair System Description:			Conventional	☐ Other	No. Employees
# Nitrification Fields	1	# Lines	4 3	Linear Ft:	~~400~~ 300	Maintenance Agreement Required:	☐ YES	☐ NO		☐ Slab	☐ Crawl Space
Trench Width	36"	Max. Trench Bottom Depth	36"	Gravel Depth	12"		☑ GRAVITY	☐ PRESSURE		☐ Basement w/plumbing	☑ Basement w/o plumbing

Water Supply: ☑ ~~Private~~ ☐ Public ☐ Community

Comments / Conditions: Install a conventional system on contour with serial distribution. An approved system may also be installed.


INITIAL SITE SKETCH

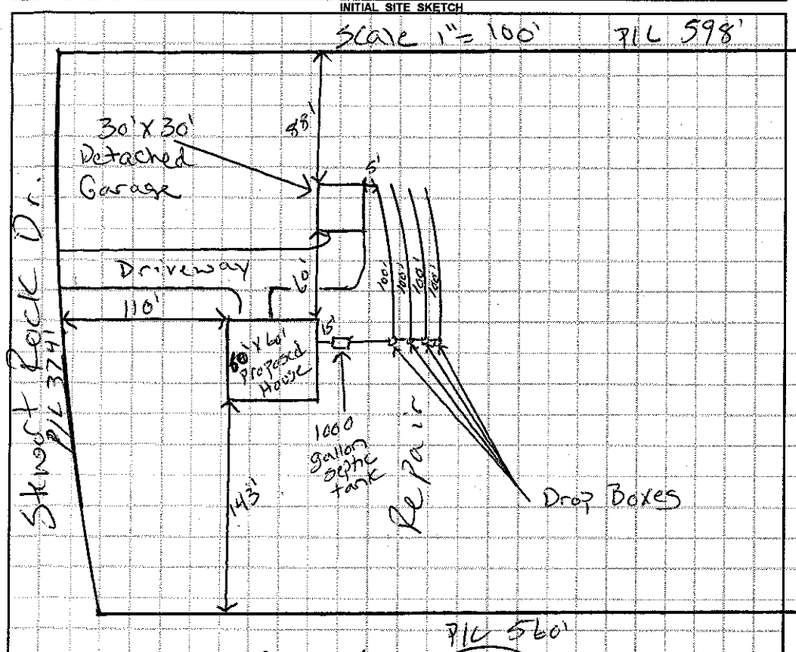

AS BUILT SKETCH

- Red Polylok filter installed
- Quick 4 Chambers installed

Installed as drawn here

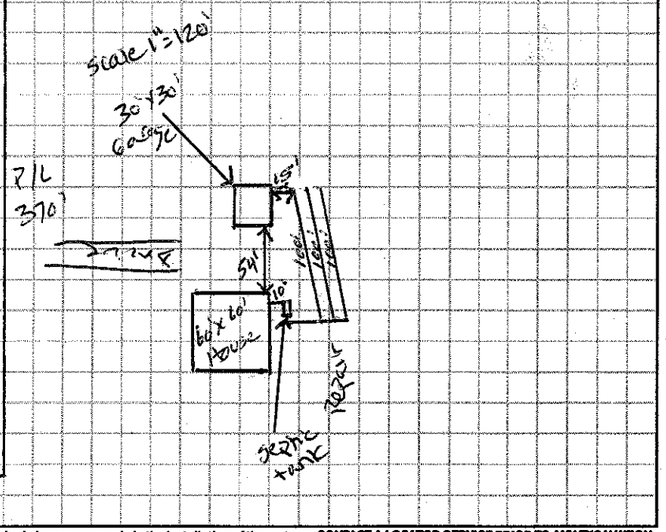

Permit can be suspended or revoked if any false information is supplied toward securing the permit / any unauthorized changes are made to the site / any unauthorized changes are made in the installation of the system. **CONTACT A LOCATOR SERVICE PRIOR TO ANY EXCAVATION**

☐ **IMPROVEMENT PERMIT** *with plat valid without expiration* ☑ **IMPROVEMENT PERMIT** *with site plan valid for 60 mos.* ☑ **AUTHORIZATION TO CONSTRUCT** *valid for period equal to IMPROVEMENT PERMIT--not to exceed 60 mo.*

Owner / Applicant Signature: [signature] Date: 3/24/14 Installed by: Specialty Septic

IMPROVEMENT PERMIT by: Justin Henderson Date: 3-21-14 OPERATION PERMIT by: Justin Henderson Date: 3-26-14

AUTHORIZATION TO CONSTRUCT by: Justin Henderson Date: 3-21-14 Existing System Inspected by: Date:

Health Dept. Copy - WHITE Applicant (Final Approval) - YELLOW Applicant (Conditional Approval) - PINK