IREDELL COUNTY HEALTH DEPARTMENT

THIS PERMIT VOIDS PREVIOUS ISSUED 9/10/97

STATESVILLE 704-878-5305 MOORESVILLE 704-664-5281

IMPROVEMENT PERMIT / AUTHORIZATION TO CONSTRUCT / OPERATION PERMIT / EXISTING SYSTEM INSPECTION

PERMIT# 068099 PIN# 3774 74 9738 DATE 11-18-98

OWNER OR CONTRACTOR TERRY & SHEILA FOX PHONE Business Home 873-9416

ADDRESS 558 NEW STERLING ROAD, STONY POINT, NC, 28678

LOCATION I-40W, TR SIMON SCH. RD, TL STEWART ROCK, TL FULBRIGHT, TR GARDNER POINT, 5TH LOT ON RIGHT

SUBDIVISION RIVERWALK BLOCK / SECTION VI LOT 14 LOT AREA 6.59 ACRES SITE CLASS PS DESIGN FLOW 480 L.T.A.R. 0.30 GPD/FT²

Septic Tank: 1000 Gallons; STB 794 Date 8-13-98

Pump Tank: ____ Gallons; PT ____ Date ____

Pump Make: ____ Model ____ Serial No. ____

Nitrification Field: No Fields 1 Square Feet 1600 Linear Feet 533+

No. Lines SIX Trench Width 36" Max Trench Bottom Depth 24" Gravel Depth 12"

✓ New System ☐ Repair System Type: I II III IV V VI

System Description: CONVENTIONAL GRAVITY

Repair System Description: 25% REDUCTION GRAV.

Maintenance Agreement Required: ☐ Yes ✓ No

✓ House/Mod. Home ☐ Mobile Home ☐ Business ☐ Other

No. Bedrooms 4 No. Bathrooms 3 No. Employees ____


☐ Slab ☐ Crawl Space ✓ Basement w/plumbing ☐ Basement wo/plumbing

Water Supply: ✓ Individual ☐ Public ☐ Community WELL


Comments/Conditions: ① KEEP SYSTEM MINIMUM 100 FEET FROM WELL ② USE ONE FLOW DIVIDER TEE TO ACHIEVE EQUAL DISTRIBUTION INTO TWO SERIES OF DROP BOXES ③ INSTALL LINES ON CONTOUR AS FLAGGED.

Comments/Conditions:

INITIAL SITE SKETCH

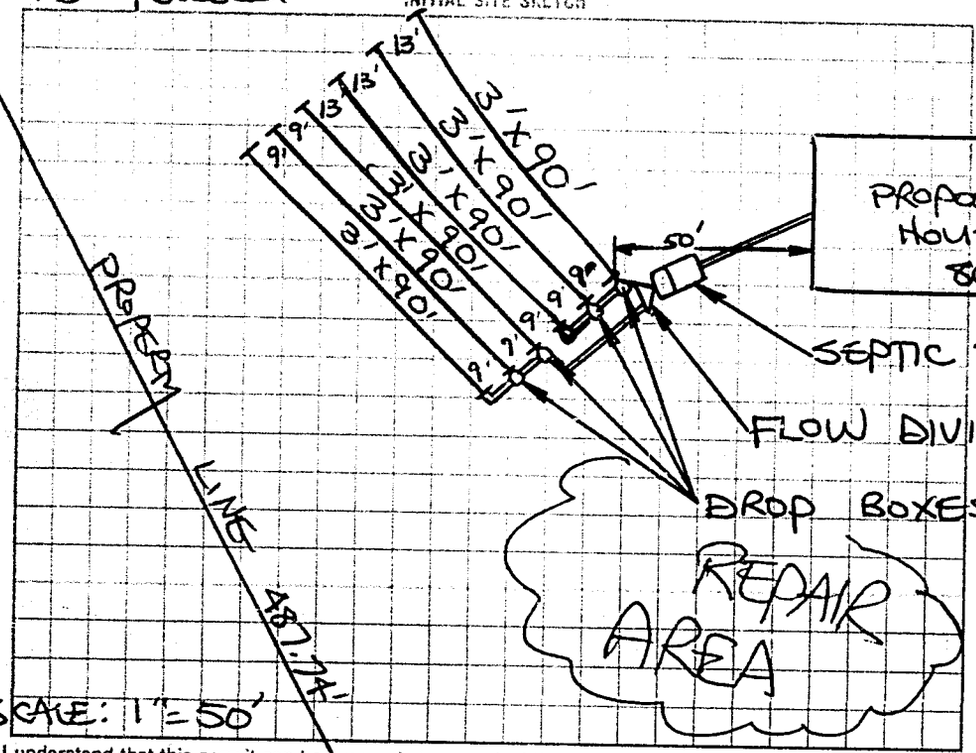

AS BUILT SKETCH

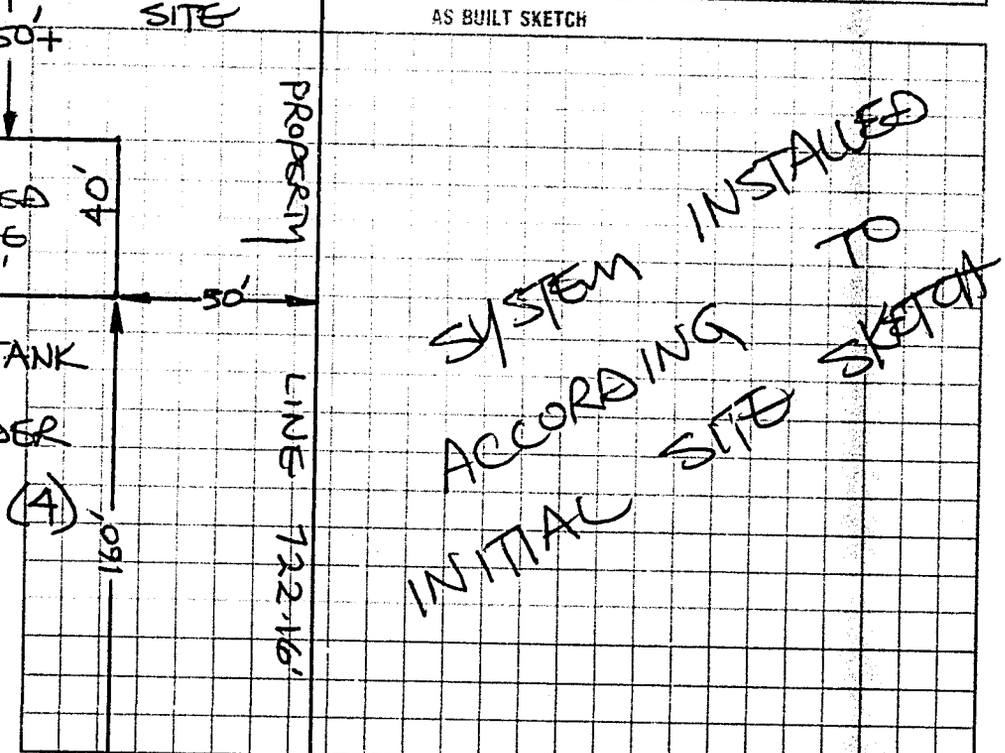

I understand that this permit can be suspended or revoked if any false information is supplied toward securing the permit/any unauthorized changes are made to the site/any unauthorized changes are made in the installation of the system. Improvement Permit with plat valid without expiration. Improvement Permit with site plan valid for sixty months. Authorization to Construct is valid for a period equal to that of Improvement Permit – not to exceed sixty months.

Signed: Beth Miller date 11-18-98 Installed by: JAMES HUBER

Improvement Permit by: STEVE HEDRICK date 11-18-98 P.L. 183-43 Operation Permit by: STEVE HEDRICK date 12-3-98

Authorization to Construct by: STEVE HEDRICK date 11-18-98 Existing System Inspection by: date

HEALTH DEPT COPY WHITE BUILDER COPY (FINAL) CANARY INSTALLER COPY PINK OWNER COPY (INITIAL) GOLD

GARDNER POINT DRIVE