Permit #100357 = See info for outbuilding addition onsite in 2010

IREDELL COUNTY HEALTH DEPARTMENT

STATESVILLE 704-878-5305 CI MOORESVILLE 704-664-5281

IMPROVEMENT PERMIT / AUTHORIZATION TO CONSTRUCT / OPERATION PERMIT / EXISTING SYSTEM INSPECTION

PERMIT# 111693 PIN# 3774-78-6497 DATE 4/3/02

OWNER OR CONTRACTOR Nantz Bldg Co PHONE: Business Home (704) 528-6043

ADDRESS 147 Nantz Woods Lane Troutman, NC 28166

LOCATION I-40 W, @ Sharon School Rd, @ Stewart Rock, 3rd lot on left Past Fulbright

SUBDIVISION River Walk BLOCK / SECTION 9 LOT 10 LOT AREA 5.0 Ac SITE CLASS. P5 DESIGN FLOW P5 L.T.A.R. .30

Septic Tank: 1,000 Gallons; STB 1012 Date 10-24-03

Pump Tank: Gallons; PT Date

Pump Make: Model Serial No.

Nitrification Field: No Fields 1 Square Feet 1440 Linear Feet 534

No Lines 4 @ 134' Trench Width 36" Max Trench Bottom Depth 36" Gravel Depth 12"

☒ New System ☐ Repair System Type: I (II) III, IV, V, VI

System Description: Gravity Conventional

Repair System Description: Gravity, Pump, Conventional

Maintenance Agreement Required: ☐ Yes ☐ No

☒ House/Mod. Home ☐ Mobile Home ☐ Business ☐ Other

No. Bedrooms 4 No. Bathrooms 3 No. Employees


☐ Slab ☐ Crawl Space ☐ Basement w/plumbing ☒ Basement wo/plumbing

Water Supply: ☒ Individual ☐ Public ☐ Community


Comments:/Conditions: @ Install well 100ft from Septic System

Comments:/Conditions:
- House moved W/O H.D Approval / ST moved W/O H.D Approval
- Septic Liner deeper than 36"
- Tuff-Tite Filter & ST marker Installed

INITIAL SITE SKETCH

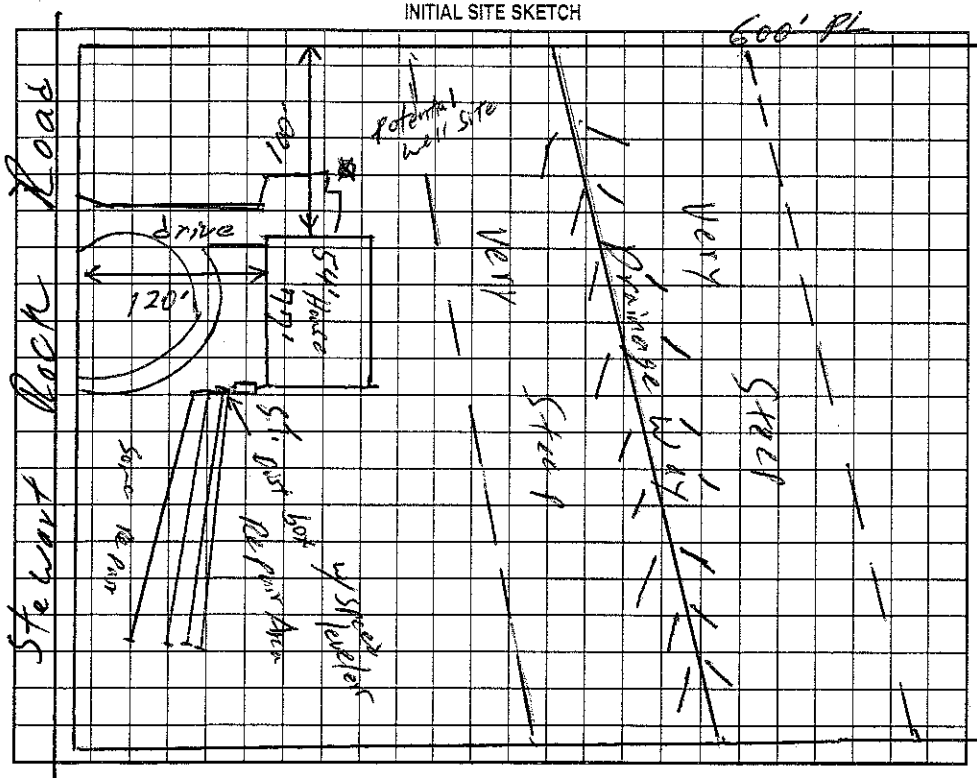

AS BUILT SKETCH

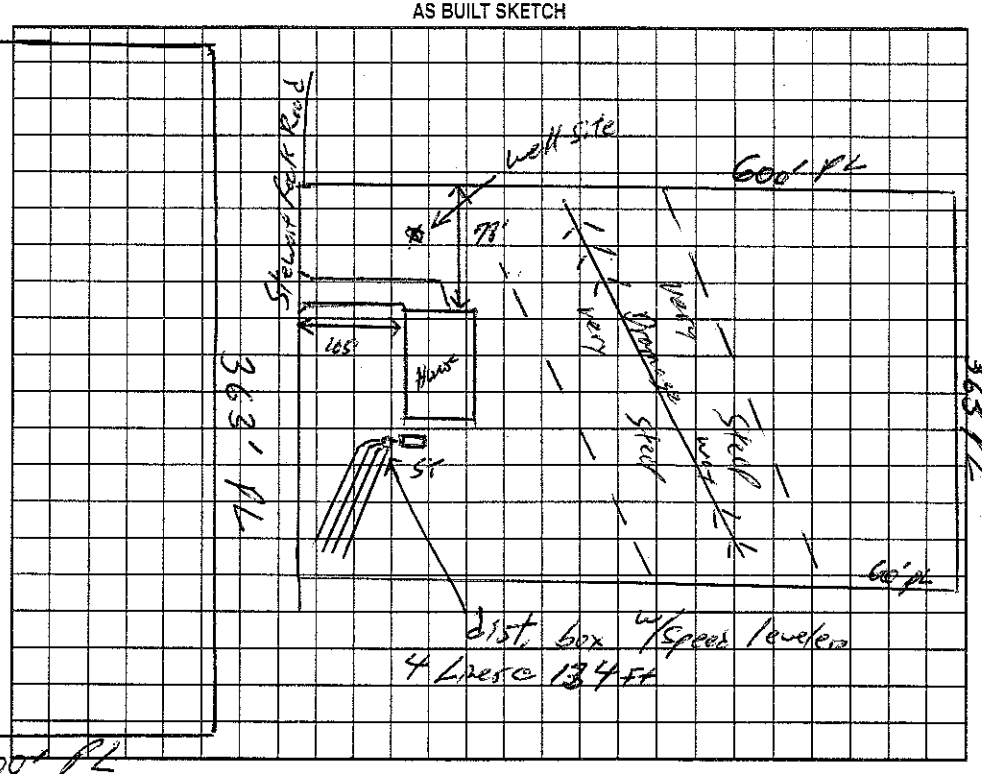

Permit can be suspended or revoked if any false information is supplied toward securing the permit/any unauthorized changes are made to the site/any unauthorized changes are made in the installation of the system. Improvement Permit with plat valid without expiration. Improvement Permit with site plan valid for sixty months. Authorization to Construct is valid for a period equal to that of Improvement Permit – not to exceed sixty months.

Signed: D. Darrell Nantz date 4/3/03 Installed by: Tommy Frye

Improvement Permit by: William O. Johnson date 4/3/03 Operation Permit by: William O. Johnson date 4/28/04

Authorization to Construct by: William O. Johnson date 4/3/03 Existing System Inspection by: date

HEALTH DEPT. COPY: WHITE OWNER COPY (FINAL): YELLOW OWNER COPY (INITIAL): PINK