IREDELL COUNTY HEALTH DEPARTMENT

STATESVILLE 704-878-5305 MOORESVILLE 704-664-5281

IMPROVEMENT PERMIT / AUTHORIZATION TO CONSTRUCT / OPERATION PERMIT / EXISTING SYSTEM INSPECTION

PERMIT # 159657 PIN # 3774-32-4876 DATE 2-23-10

OWNER or APPLICANT Richard & Joyce Reno PHONE: Business 704-682-8775 Home: 941-737-1083

OWNER or APPLICANT ADDRESS 3912 52nd Dr. W Bradenton, FL 34210

LOCATION / DIRECTIONS Sharon School Rd to Stewart Rock Rd to Fulbright to Cowles Pt to Ridge Point on RT


SUBDIVISION River Walk BLOCK / SECTION V LOT # 9 LOT AREA .962 DESIGN FLOW 360 L.T.A.R. .13

Septic Tank 1000	Gallons: STB 70	Date 6-8-10	☐ New System ☐ Repair ☐ Expansion System Type I II III IV V VI	☑ Residence No. Bedrooms 3	Water Supply ☑ Private
Pump Tank	Gallons: PT 70	Date	System Description: 25% Gravity	☐ Business No. Persons	☐ Public
Pump Make	Model	Serial #	Repair System Description: 50% Low Pressure	☐ Other No. Employees	☐ Community
Nitrification Field No Fields 1	No Lines	Linear Feet 360	Maintenance Agreement Required ☐ YES ☑ NO	☐ Slab ☐ Crawl Space	
Trench Width 36"	Max. Trench Bottom Depth 36"	Gravel Depth NA	☑ GRAVITY ☐ PRESSURE	☑ Basement w/plumbing	☐ Basement w/o plumbing


Comments / Conditions

Comments / Conditions
* Reinstall on Contour
* Maintain all setbacks
* Must use drop boxes

INITIAL SITE SKETCH

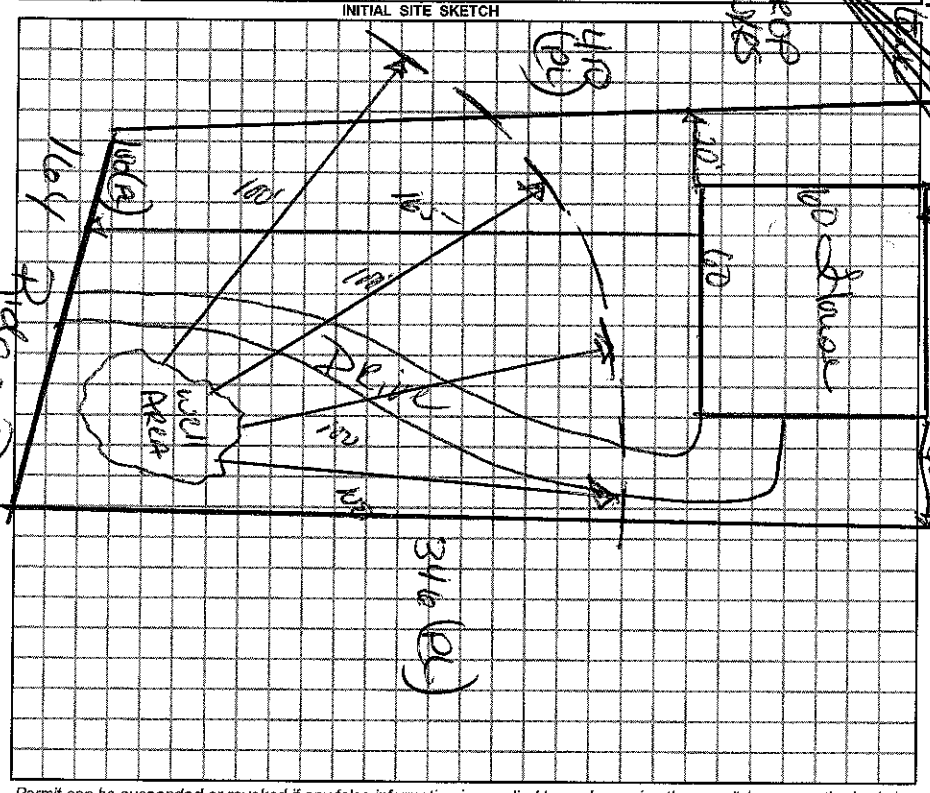

AS BUILT SKETCH

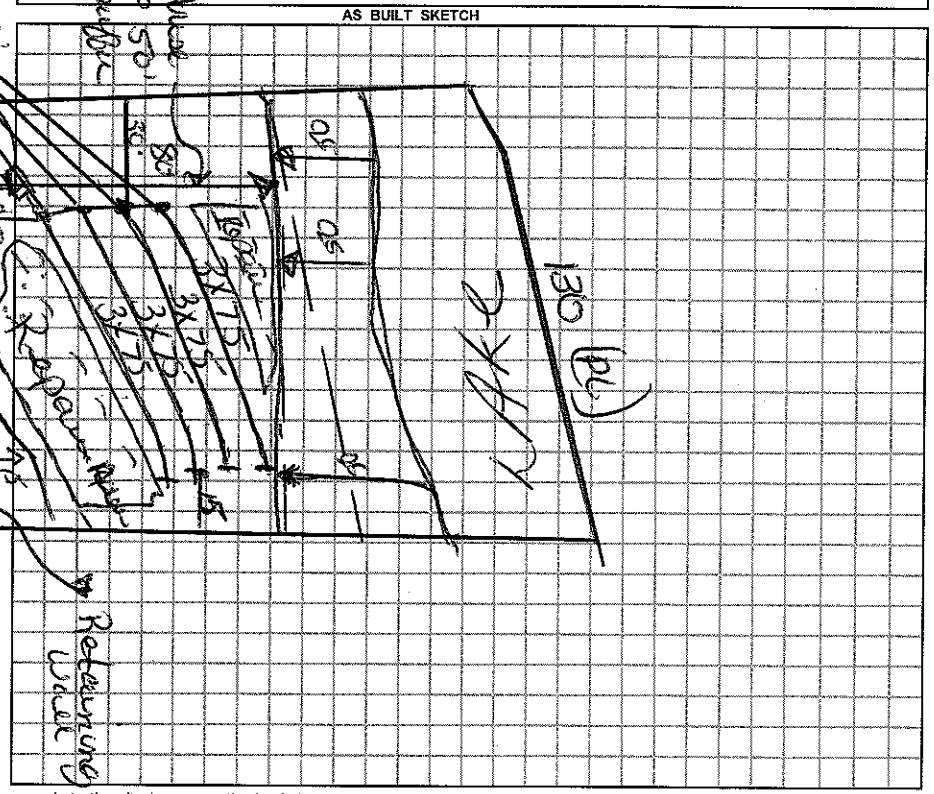

Permit can be suspended or revoked if any false information is supplied toward securing the permit / any unauthorized changes are made to the site / any unauthorized changes are made in the installation of the system.

☐ *IMPROVEMENT PERMIT w / plat valid without expiration.* ☑ *IMPROVEMENT PERMIT w / site plan valid for 60 mos.* ☑ *AUTHORIZATION TO CONSTRUCT valid for period equal to IMPROVEMENT PERMIT-not to exceed 60 mo.*

Owner / Applicant Signature: [signature] Date 2-25-10

Improvement Permit by: [signature] Date 2-23-10

Authorization to Construct by: [signature] Date 2-23-10

Installed by: Larry Tucker Construction

Operation Permit by: [signature] Date: 10-22-10

Existing System Inspected by: Date:

YOU SHOULD CONTACT A LOCATOR SERVICE PRIOR TO ANY EXCAVATION.

WHITE COPY Environmental Health YELLOW COPY (Final) Owner / Applicant PINK COPY (Initial) Owner / Applicant