IREDELL COUNTY HEALTH DEPARTMENT

STATESVILLE 704-878-5305 MOORESVILLE 704-664-5281

IMPROVEMENT PERMIT / AUTHORIZATION TO CONSTRUCT / OPERATION PERMIT / EXISTING SYSTEM INSPECTION

PERMIT# 115851 PIN# 3774-83-3817 DATE 4/1/04

OWNER OR CONTRACTOR John Pimiento PHONE: Business — Home (704) 838-1611

ADDRESS 124 Ravenwood Drive Statesville, N.C. 28677

LOCATION I-40 W (R) Shaver School Rd (L) Stewart Rock (L) Gardner Point Dr. (R) Pebble Creek to end on Right

SUBDIVISION River Walk BLOCK / SECTION II LOT 1 LOT AREA 1.96 Ac. SITE CLASS. RS DESIGN FLOW 480 L.T.A.R. .35 gpd/ft²

Septic Tank: 1,000 Gallons; STB 1012 Date 4-29-05
Pump Tank: ____ Gallons; PT ____ Date ____
Pump Make: ____ Model ____ Serial No. ____
Nitrification Field: No Fields 1 Square Feet 1372 Linear Feet 345
No Lines 4 Trench Width 36" Max Trench Bottom Depth 32" Gravel Depth N/A

☒ New System ☐ Repair System Type: I, II (III) IV, V, VI
System Description: Gravity, 25% Reduction
Repair System Description: Pump, Gravity, 50% Reduction
Maintenance Agreement Required: ☐ Yes ☒ No


☒ House/Mod. Home No. Bedrooms 4
☐ Mobile Home No. Bathrooms 4½
☐ Business No. Employees ____
☐ Other ____
☐ Slab ☐ Crawl Space ☐ Basement w/plumbing ☐ Basement wo/plumbing

Water Supply: ☒ Individual ☐ Public ☐ Community


Comments:/Conditions: (1) Keep well 100 ft from septic system (2) Install lines on contour (3) maintain proper setbacks

Comments:/Conditions: SEPTIC TANK WITH MARKER INSTALLED USING "TUFFTITE" FILTER

INITIAL SITE SKETCH

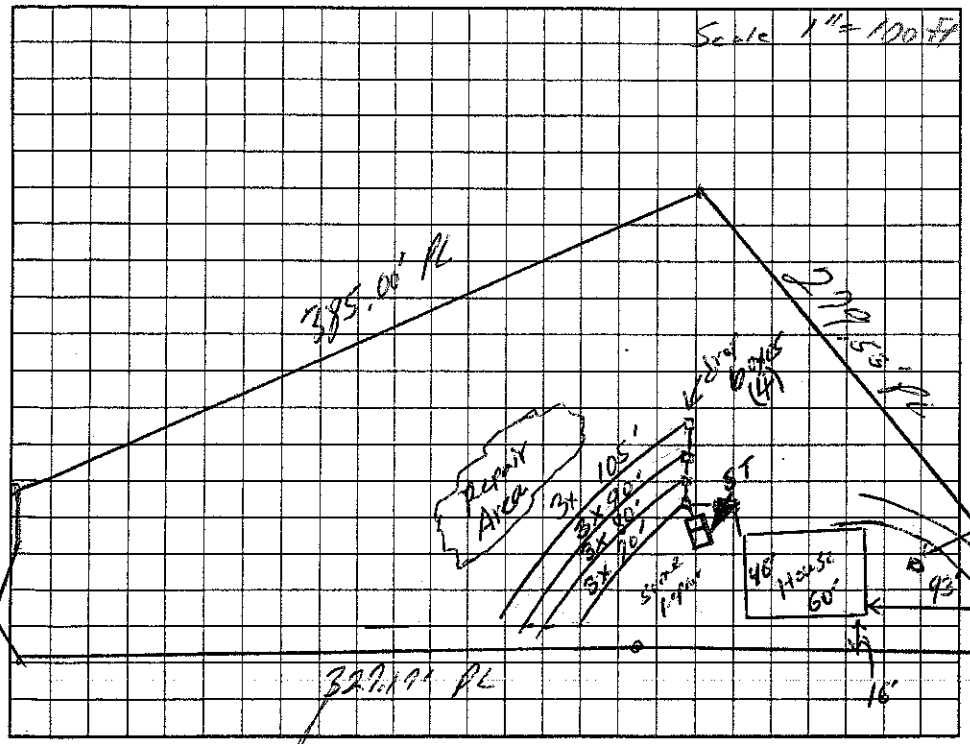

AS BUILT SKETCH

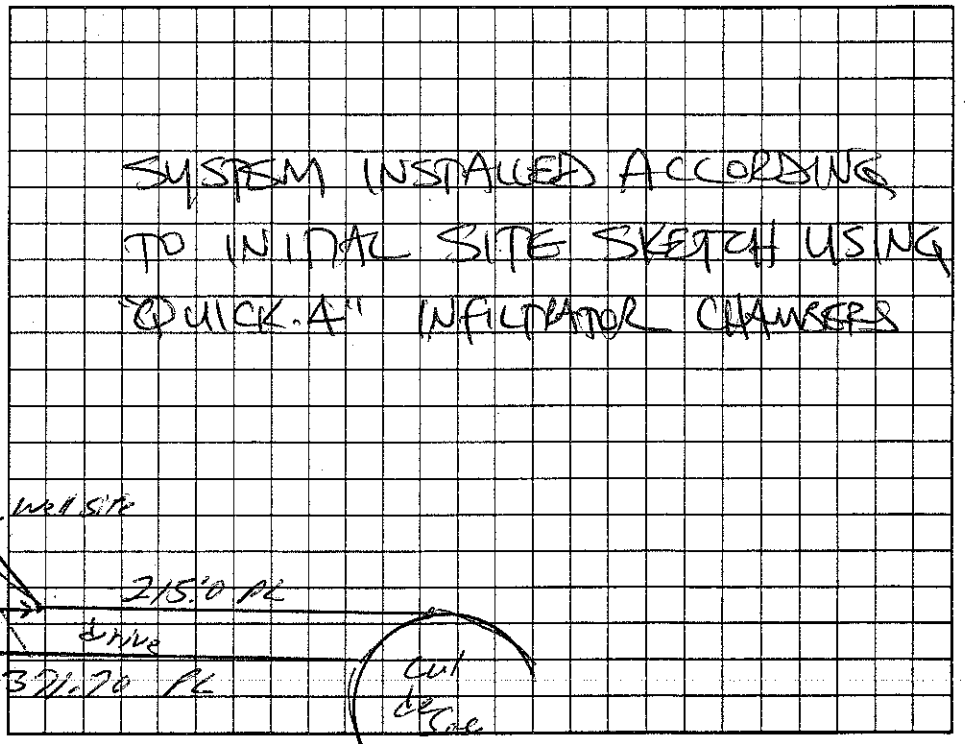

Permit can be suspended or revoked if any false information is supplied toward securing the permit/any unauthorized changes are made to the site/any unauthorized changes are made in the installation of the system. Improvement Permit with plat valid without expiration. Improvement Permit with site plan valid for sixty months. Authorization to Construct is valid for a period equal to that of Improvement Permit – not to exceed sixty months.

Signed: ____ date ____

Improvement Permit by: William O. Johnson date 4/1/04

Authorization to Construct by: William O. Johnson date 4/1/04

Installed by: A-1 Backhoe

Operation Permit by: Steve Fredrick date 11-04-05

Existing System Inspection by: ____ date ____

HEALTH DEPT. COPY: WHITE OWNER COPY (FINAL): YELLOW OWNER COPY (INITIAL): PINK