# IREDELL COUNTY HEALTH DEPARTMENT

THIS PERMIT VOIDS PREVIOUS ISSUED 11-2-96

STATESVILLE 704-878-5305 MOORESVILLE 704-664-5281

## IMPROVEMENT PERMIT / AUTHORIZATION TO CONSTRUCT / OPERATION PERMIT / EXISTING SYSTEM INSPECTION

PERMIT# 083183 PIN# 3774 83 6004 DATE 5-24-00

OWNER OR CONTRACTOR MARK NELSON PHONE: Business 910 528-~~6805~~ 6805 Home

ADDRESS C/O KENT SHAW, 321 WAGNER ST, TROUTMAN, NC 28166

LOCATION GARDNER POINT DRIVE, JR RIDGE POINT DRIVE, 8TH LOT ON RIGHT

SUBDIVISION RIVERWALK BLOCK / SECTION V LOT 7 LOT AREA 1.107 ACRES SITE CLASS PS DESIGN FLOW 480 L.T.A.R. 0.30 GPD/FT²

Septic Tank: 1000 Gallons; STB 1007 Date 9-6-00
Pump Tank: ____ Gallons; PT ____ Date ____
Pump Make: ____ Model ____ Serial No. ____
Nitrification Field: No Fields 1 Square Feet EQ. TO 1600 Linear Feet 400+
No Lines SIX Trench Width 36" Max Trench Bottom Depth 32" ~~Bedrock~~ Depth SAND 64"

☑ New System ☐ Repair System Type: I, II, ☑ III, IV, V, VI
System Description: 25% REDUCTION GRAVITY
Repair System Description: 50% REDUCTION GRAVITY
Maintenance Agreement Required: ☐ Yes ☑ No
☐ Slab ☐ Crawl Space ☑ Basement w/plumbing ☐ Basement wo/plumbing


☑ House/Mod. Home No. Bedrooms 4
☐ Mobile Home No. Bathrooms 3
☐ Business No. Employees ____
☐ Other ____

Water Supply: ☑ Individual ☐ Public ☐ Community
WELL


Comments/Conditions: ① KEEP SYSTEM MINIMUM 100 FEET FROM WELL ② INSTALL 25% REDUCTION SYSTEM USING SIXTY-SEVEN (67) CHAMBERS ON CONTOUR AS FLAGGED ON-SITE.

Comments/Conditions: SEPTIC TANK & DRAINLINES INSTALLED 12-1-00. HEADER DITCH (FLOW DIVIDER & DROP BOXES) REMAIN TO BE INSPECTED 12-1-00

INITIAL SITE SKETCH

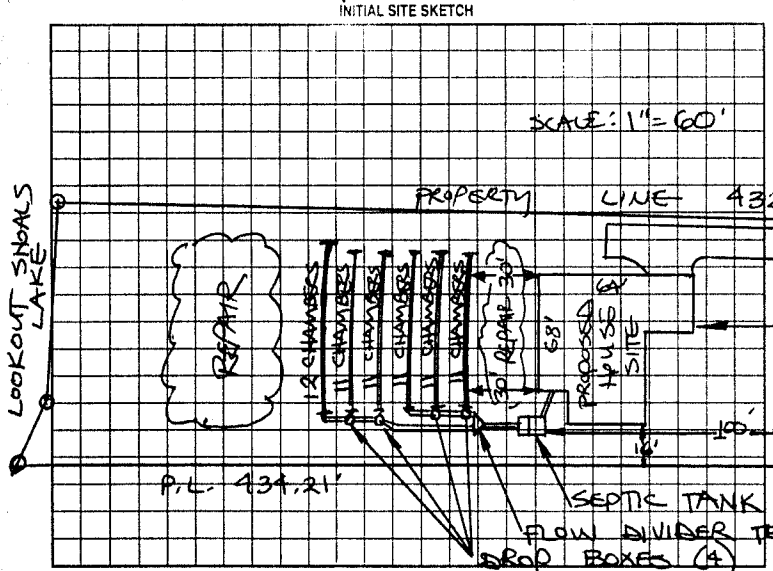


AS BUILT SKETCH

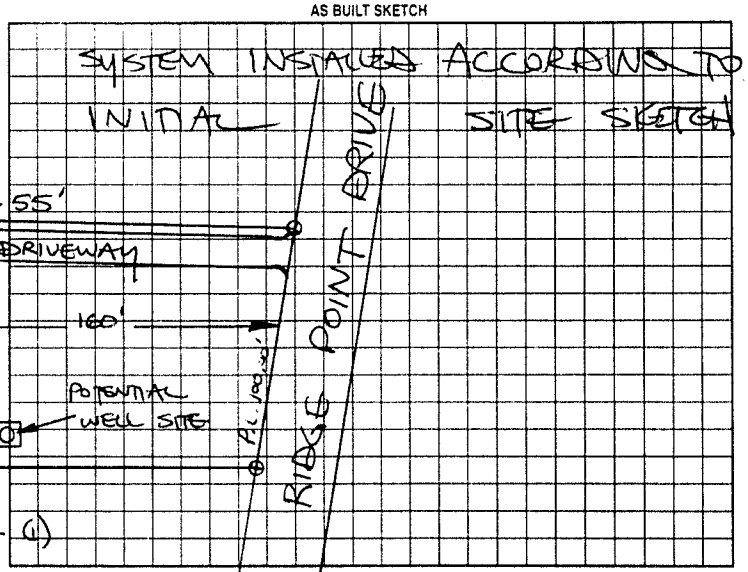


Permit can be suspended or revoked if any false information is supplied toward securing the permit/any unauthorized changes are made to the site/any unauthorized changes are made in the installation of the system. Improvement Permit with plat valid without expiration. Improvement Permit with site plan valid for sixty months. Authorization to Construct is valid for a period equal to that of Improvement Permit – not to exceed sixty months.

Signed: Mark Nelson date 6-7-06 Installed by: JOAN TRAVIS

Improvement Permit by: STEVE HEDRICK date 5-24-00 Operation Permit by: STEVE HEDRICK date 12-4-00

Authorization to Construct by: STEVE HEDRICK date 5-24-00 Existing System Inspection by: ____ date ____

HEALTH DEPT. COPY WHITE OWNER COPY (FINAL) YELLOW OWNER COPY (INITIAL) PINK