EGER CRANFILL — THIS PERMIT VOIDS PREVIOUS ISSUED 11-20-96

IREDELL COUNTY HEALTH DEPARTMENT

STATESVILLE 704-878-5305 — MOORESVILLE 704-664-5281

IMPROVEMENT PERMIT / AUTHORIZATION TO CONSTRUCT / OPERATION PERMIT / EXISTING SYSTEM INSPECTION

PERMIT# 25270 PIN# 8R-A-1 (PART) DATE 4-3-98

OWNER OR CONTRACTOR EGER CRANFILL PHONE: Business 872-0819 Home 878-2982

ADDRESS % KES MARKETING, P.O. BOX 1627 MATTHEWS, NC 28106

LOCATION OAK POINT LANE OFF GARDNER POINT DRIVE 4TH LOT ON RIGHT

SUBDIVISION RIVERWALK BLOCK / SECTION V LOT 37 LOT AREA 0.730 ACRE SITE CLASS PS DESIGN FLOW 360 L.T.A.R. 0.30 GPD/FT²

Septic Tank: 1000 Gallons; STB 1012 Date 12-11-01
Pump Tank: 1000 Gallons; PT 17 Date 12-29-01
Pump Make: Zoeller Model N-152A Serial No. —
Nitrification Field: No Fields 1 Square Feet Eq. to 1200 Linear Feet 200
No Lines FIVE Trench Width 24" Max Trench Bottom Depth 32" Gravel Depth SAND 6"

☑ New System ☐ Repair System Type: I, II, (III), IV, V, VI
System Description: PPBPS, PUMP-FED
Repair System Description: PPBPS, PUMP-FED
Maintenance Agreement Required: ☐ Yes ☑ No

☑ House/Mod. Home No. Bedrooms 3
☐ Mobile Home No. Bathrooms 2
☐ Business No. Employees ___
☐ Other ___


☐ Slab ☐ Crawl Space ☑ Basement w/plumbing ☐ Basement wo/plumbing

Water Supply: ☑ Individual ☐ Public ☐ Community — WELL

Comments/Conditions: ① INSTALL 45 PPBPS PANEL IN FIVE EQUAL LENGTH LINES ON CONTOUR AS SHOWN ② KEEP SYSTEM MAXIMUM FEASIBLE DISTANCE (60') FROM WELL ③ SEE ATTACHED SHEETS FOR PUMP & PRESSURE MANIFOLD REQUIREMENTS.

Comments/Conditions: - Polylok filter installed, Septic Tank marker installed, Pressure check okay, Pump Floats + Alarm Not Checked - okay, Alarm + Electrical okay.

INITIAL SITE SKETCH

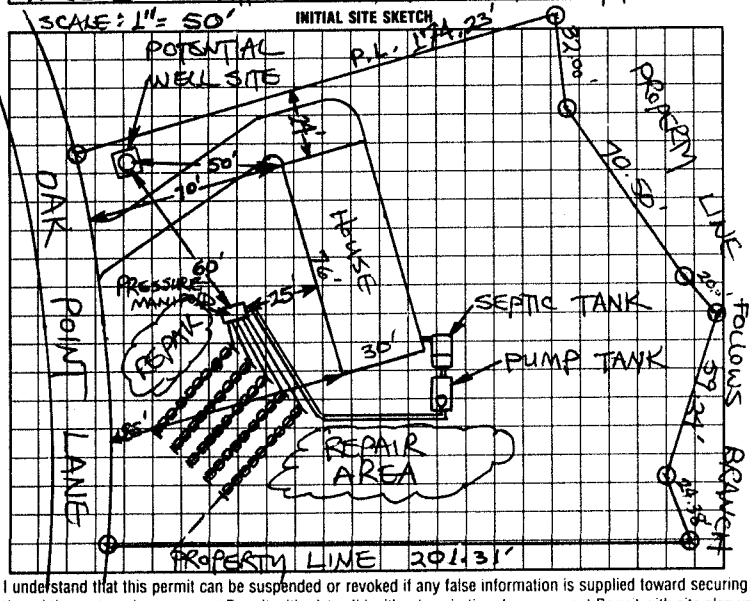

AS BUILT SKETCH

CHECKED TANKS, NOT PUMP. LINES INSPECTED 4-26-02

Installed as shown per Initial Site Sketch

I understand that this permit can be suspended or revoked if any false information is supplied toward securing the permit/any unauthorized changes are made to the site/any unauthorized changes are made in the installation of the system. Improvement Permit with plat valid without expiration. Improvement Permit with site plan valid for sixty months. Authorization to Construct is valid for a period equal to that of Improvement Permit – not to exceed sixty months.

Signed: _____ date ___

Improvement Permit by: STEVE HEDRICK date 4-3-98

Authorization to Construct by: STEVE HEDRICK date 4-3-98

Installed by: Jerry Jackson w/ Home Owner

Operation Permit by: William B. Johnson date 6/24/02

Existing System Inspection by: _____ date ___

HEALTH DEPT. COPY: WHITE — INSPECTION COPY (FINAL): GREEN — OWNER COPY (FINAL): YELLOW — INSPECTION COPY (INITIAL): PINK — OWNER COPY (INITIAL): GOLD