IREDELL COUNTY HEALTH DEPARTMENT

STATESVILLE 704-878-5305 CI MOORESVILLE 704-664-5281

IMPROVEMENT PERMIT / AUTHORIZATION TO CONSTRUCT / OPERATION PERMIT / EXISTING SYSTEM INSPECTION

PERMIT# 106322 PIN# 3774-84-~~5592~~ 5405 DATE 6/20/02

OWNER OR CONTRACTOR Terry + Shelia Fox PHONE: Business — Home (704) 585-6683

ADDRESS 150 Gardner Point Drive Stony Point, N.C. 28

LOCATION I-40 W, (R) Sharon School Rd, (L) Stewart Rock Road, (L) Fulbright, (R) Gardner Point, (R) Pebble Creek, 4th lot on Right

SUBDIVISION Riverwalk BLOCK / SECTION V LOT ~~50+51~~ 6A LOT AREA 3.7 Acres SITE CLASS. PS DESIGN FLOW 480 L.T.A.R. .30

Septic Tank: 1,000 Gallons; STB 1007 Date 9-5-02
Pump Tank: Gallons; PT Date
Pump Make: Model Serial No.
Nitrification Field: No Fields 1 Square Feet Equiv. to 1600 Linear Feet 400'
No Lines 7 Trench Width 36" Max Trench Bottom Depth 30" Gravel Depth

☒ New System ☐ Repair System Type: I, II, (III), IV, V, VI
System Description: Gravity, 25% Reduction
Repair System Description: Gravity, 25% Reduction
Maintenance Agreement Required: ☐ Yes ☒ No
☐ Slab ☐ Crawl Space ☒ Basement w/plumbing ☐ Basement wo/plumbing


☒ House/Mod. Home No. Bedrooms 4
☐ Mobile Home No. Bathrooms 4
☐ Business No. Employees
☐ Other

Water Supply:
☒ Individual
☐ Public
☐ Community

Comments:/Conditions: (1) Install liner on contour (2) Install 25% Reduction System w/ flow divider tee (3) Keep well 100 ft from System

Comments:/Conditions: - Polylok Filter + S Tank marker Installed - Installed 64 Bio Diffuser Chambers

INITIAL SITE SKETCH

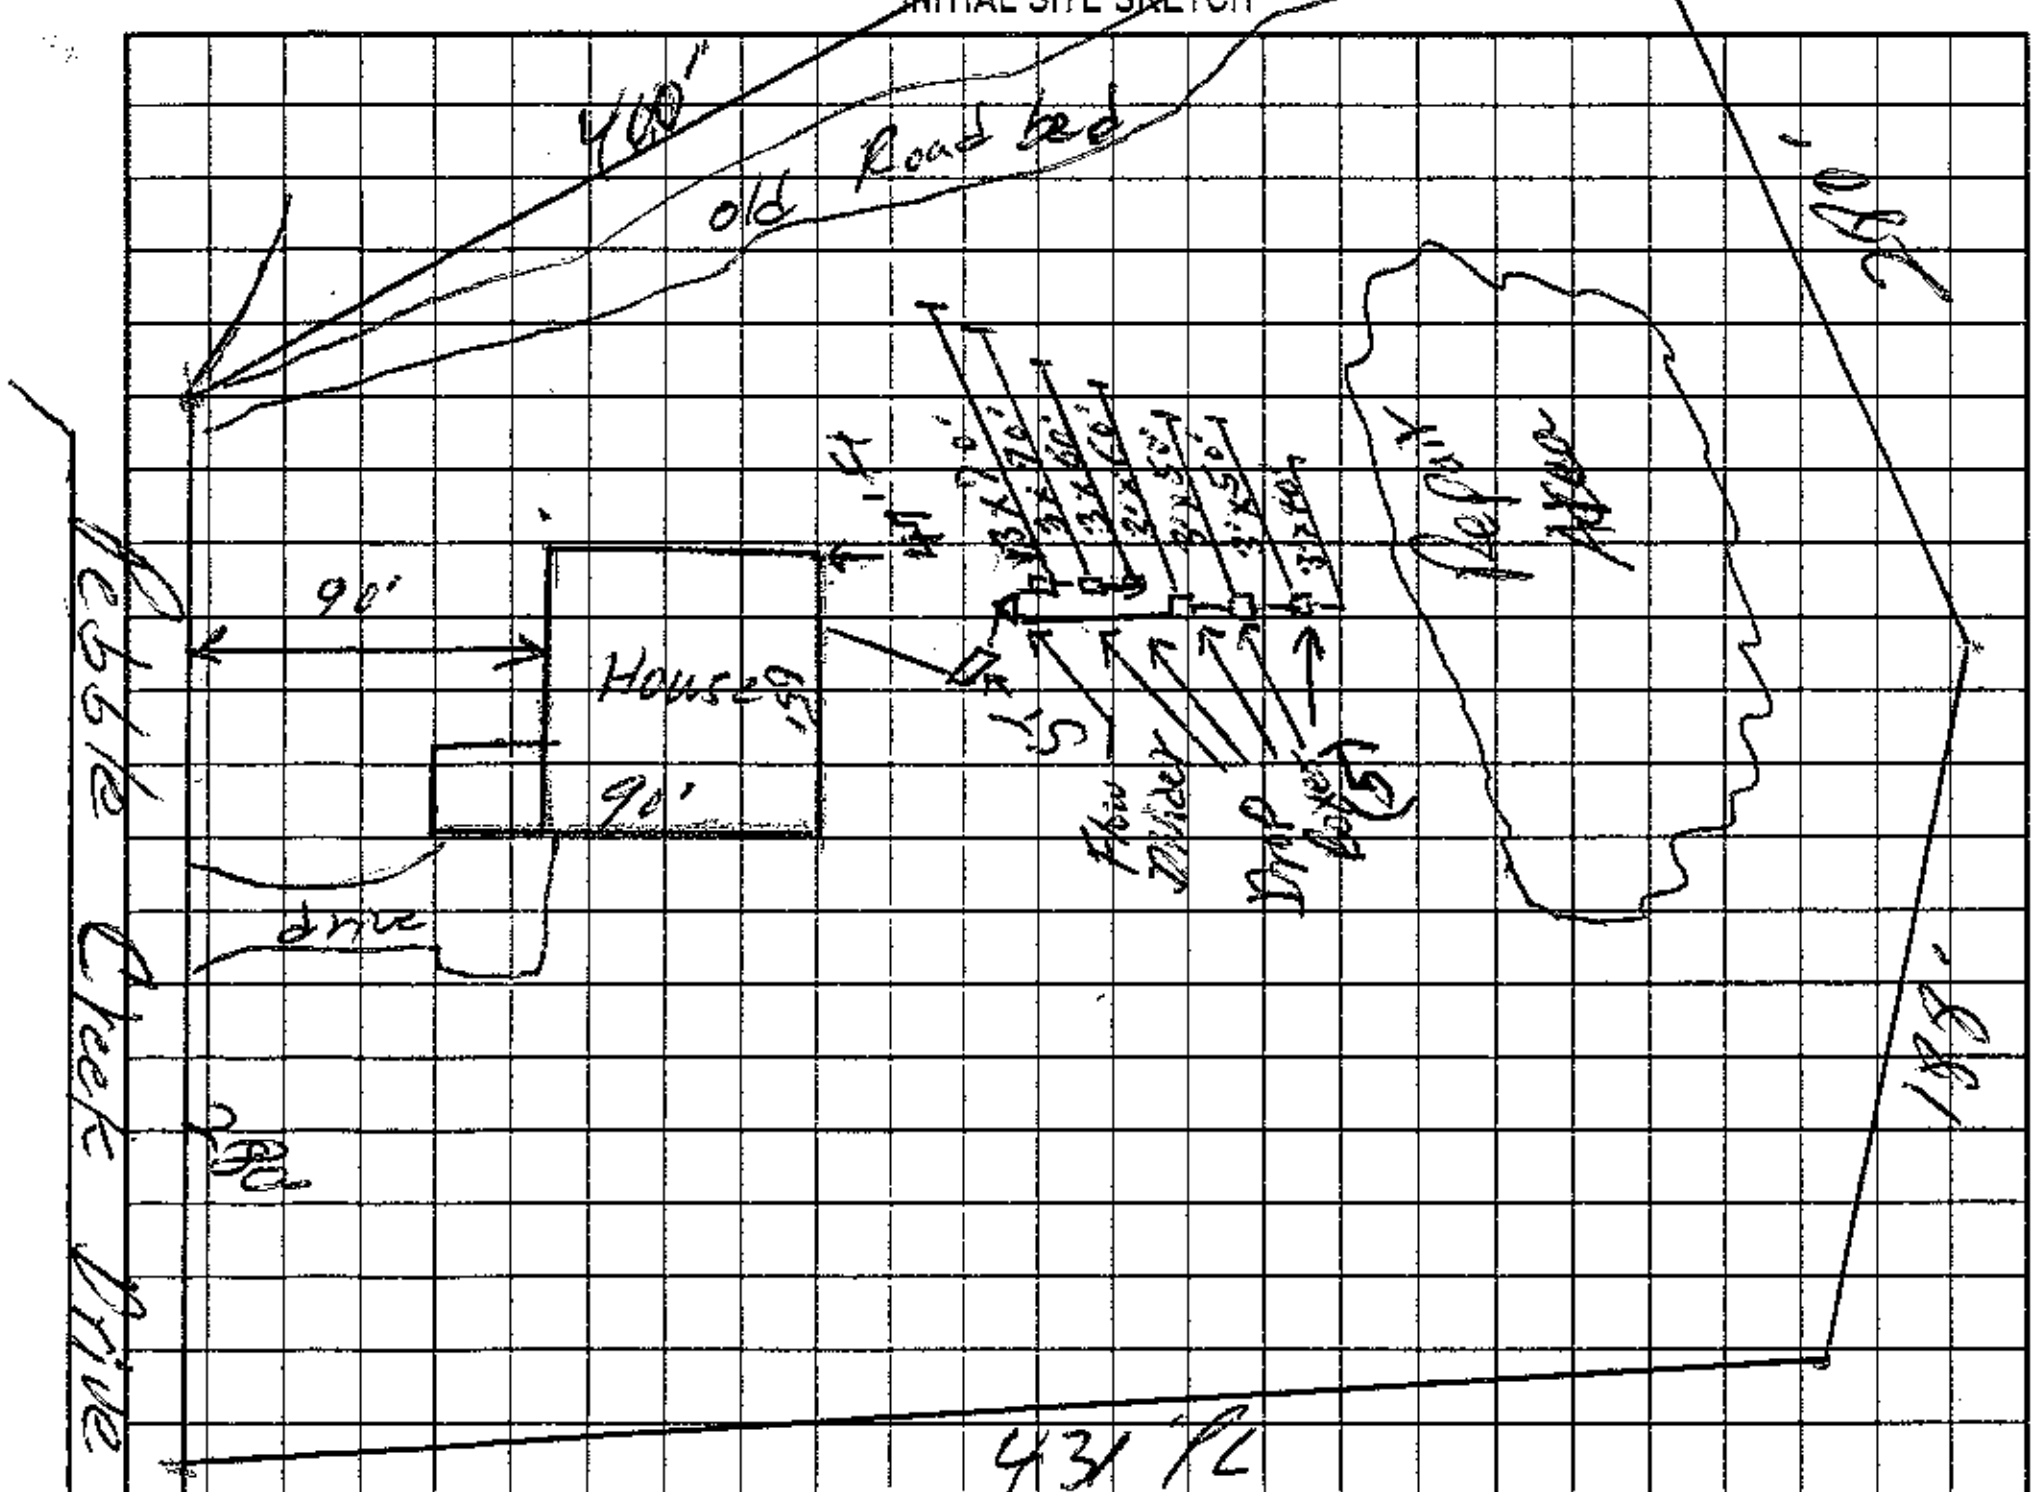

AS BUILT SKETCH

Installed As Shown per site sketch

Permit can be suspended or revoked if any false information is supplied toward securing the permit/any unauthorized changes are made to the site/any unauthorized changes are made in the installation of the system. Improvement Permit with plat valid without expiration. Improvement Permit with site plan valid for sixty months. Authorization to Construct is valid for a period equal to that of Improvement Permit – not to exceed sixty months.

Signed: T. Fox date 6-24-02 Installed by: James Hudler

Improvement Permit by: William O. Johnson date 6/20/02 Operation Permit by: William O. Johnson date 1/2/03

Authorization to Construct by: William O. Johnson date 6/20/02 Existing System Inspection by: date

HEALTH DEPT. COPY: WHITE OWNER COPY (FINAL): YELLOW OWNER COPY (INITIAL): PINK