This Permit Voids Permit Issued on 11-18-96 (Expired on 11/18/98)

IREDELL COUNTY HEALTH DEPARTMENT

STATESVILLE 704-878-5305 MOORESVILLE 704-664-5281

IMPROVEMENT PERMIT / AUTHORIZATION TO CONSTRUCT / OPERATION PERMIT / EXISTING SYSTEM INSPECTION

PERMIT# 102302 PIN# 3774-84-6083 DATE 4/19/01

OWNER OR CONTRACTOR Marvin Todd Harbert PHONE: Business (336) 838-2925 Home

ADDRESS 121 Morrisfield Ln. Apt. 20 N. Wilkesboro, N.C. 28659

LOCATION Carlene Pt. Dr. (R) Pebble Creek Drive End on Left

SUBDIVISION Riverwalk BLOCK / SECTION V LOT 48 LOT AREA 0.933 Ac SITE CLASS PS DESIGN FLOW 360 L.T.A.R. .30 GPDA

Septic Tank: 1,000 Gallons; STB 1007 Date 9-1-02

Pump Tank: Gallons; PT Date

Pump Make: Model Serial No.

Nitrification Field: No Fields 1 Square Feet Fig to 1200 Linear Feet 300

No Lines 5@60ft Trench Width 36" Max Trench Bottom Depth 32" Gravel Depth NA

☒ New System ☐ Repair System Type: I, II, III, IV, V, VI

System Description: Gravity/25% Reduction

Repair System Description: Gravity, Pump / 25% Reduction

Maintenance Agreement Required: ☐ Yes ☐ No

☒ House/Mod. Home ☐ Mobile Home ☐ Business ☐ Other

No. Bedrooms 3 No. Bathrooms 2½ No. Employees


☐ Slab ☐ Crawl Space ☐ Basement w/plumbing ☒ Basement wo/plumbing

Water Supply: ☒ Individual ☐ Public ☐ Community


Comments:/Conditions: ① Keep System 100ft From well ② Install 25% Reduction System of Chamber or HDES Sections on Contour

Comments:/Conditions: 48 Infiltrator Chambers Installed – Tuff Tite Filter + ST marker Installed

INITIAL SITE SKETCH 222' PL

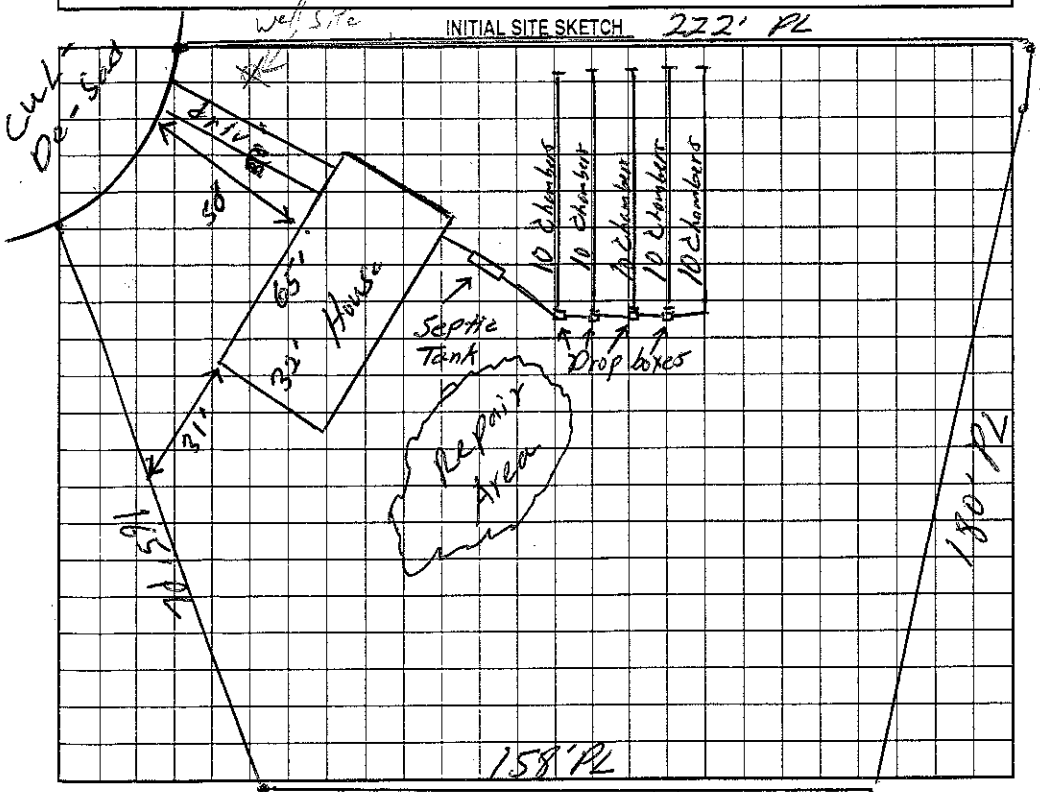

AS BUILT SKETCH 202' PL

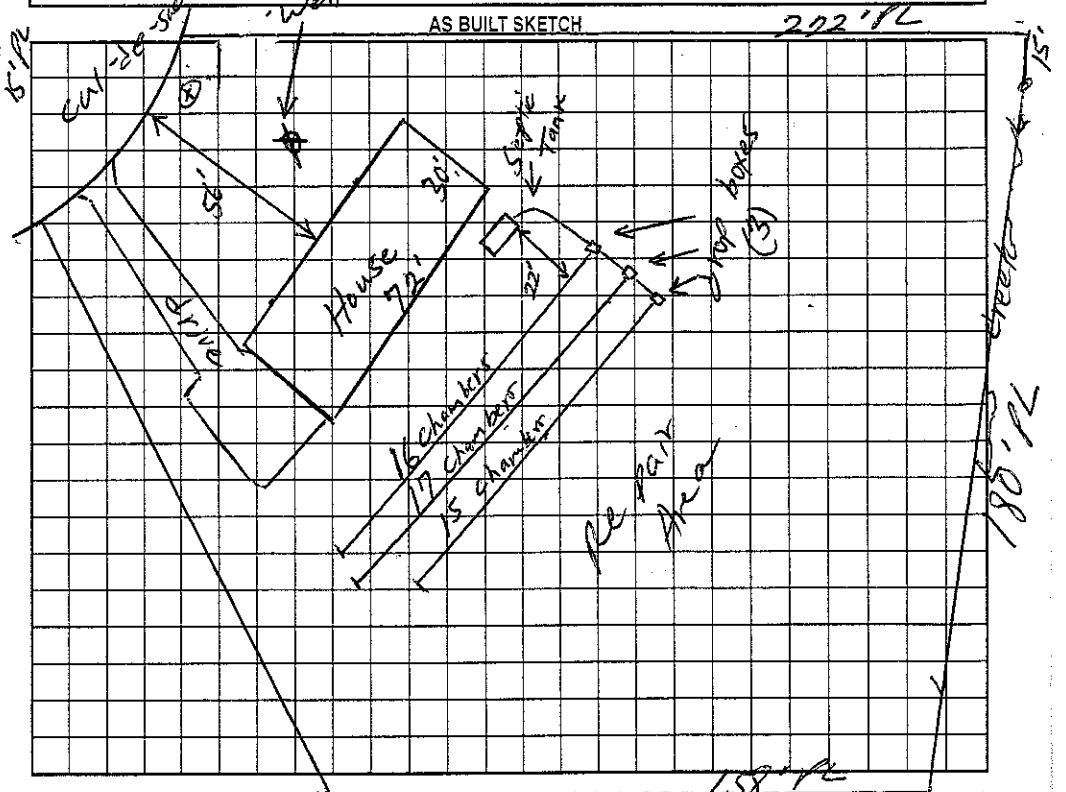

Permit can be suspended or revoked if any false information is supplied toward securing the permit/any unauthorized changes are made to the site/any unauthorized changes are made in the installation of the system. Improvement Permit with plat valid without expiration. Improvement Permit with site plan valid for sixty months. Authorization to Construct is valid for a period equal to that of Improvement Permit – not to exceed sixty months.

Signed: Marvin Harbert date 1/30/02

Improvement Permit by: William O. Johnson date 11/30/01

Authorization to Construct by: William O. Johnson date 11/30/01

Installed by: Kelly Ward

Operation Permit by: William O. Johnson date 11/20/03

Existing System Inspection by: date

HEALTH DEPT. COPY: WHITE OWNER COPY (FINAL): YELLOW OWNER COPY (INITIAL): PINK