IREDELL COUNTY HEALTH DEPARTMENT

STATESVILLE 704-878-5305 MOORESVILLE 704-664-5281

IMPROVEMENT PERMIT / AUTHORIZATION TO CONSTRUCT / OPERATION PERMIT / EXISTING SYSTEM INSPECTION

PERMIT# 102302 PIN# 3924-50-1083 DATE 4/13/01

OWNER OR CONTRACTOR Paul & Liz Reeves PHONE: Business (336) 731-2725 Home

ADDRESS 121 Mayfield Dr. Apt. 20 N. Wilkesboro, NC 28659

LOCATION Center for Life & Bethel Creek Drive Ext. on Left

SUBDIVISION Rockcliff BLOCK / SECTION LOT 45 LOT AREA 0.732 Ac. SITE CLASS PP DESIGN FLOW 360 L.T.A.R. .30 equiv

Septic Tank: 1000 Gallons; STB Date

Pump Tank: Gallons; PT Date

Pump Make: Model Serial No.

Nitrification Field: No Fields 1 Square Feet 675 Linear Feet 300

No Lines 5@60' Trench Width 36" Max Trench Bottom Depth 32" Gravel Depth 12"

☒ New System ☐ Repair System Type: I, II, III, IV, V, VI

System Description: Conv. 1250 Reduction

Repair System Description: Conv. Rep/1250 Reduction

Maintenance Agreement Required: ☐ Yes ☐ No

☒ House/Mod. Home No. Bedrooms 3

☐ Mobile Home No. Bathrooms 2

☐ Business No. Employees

☐ Other


☐ Slab ☐ Crawl Space ☐ Basement w/plumbing ☒ Basement wo/plumbing

Water Supply: ☒ Individual ☐ Public ☐ Community

Comments/Conditions: 1) Keep System 100' from Lot 1 2) 2 trees 25' below, instead of 1 per 1/2 Section or Portion

Comments/Conditions:

INITIAL SITE SKETCH 233' AL

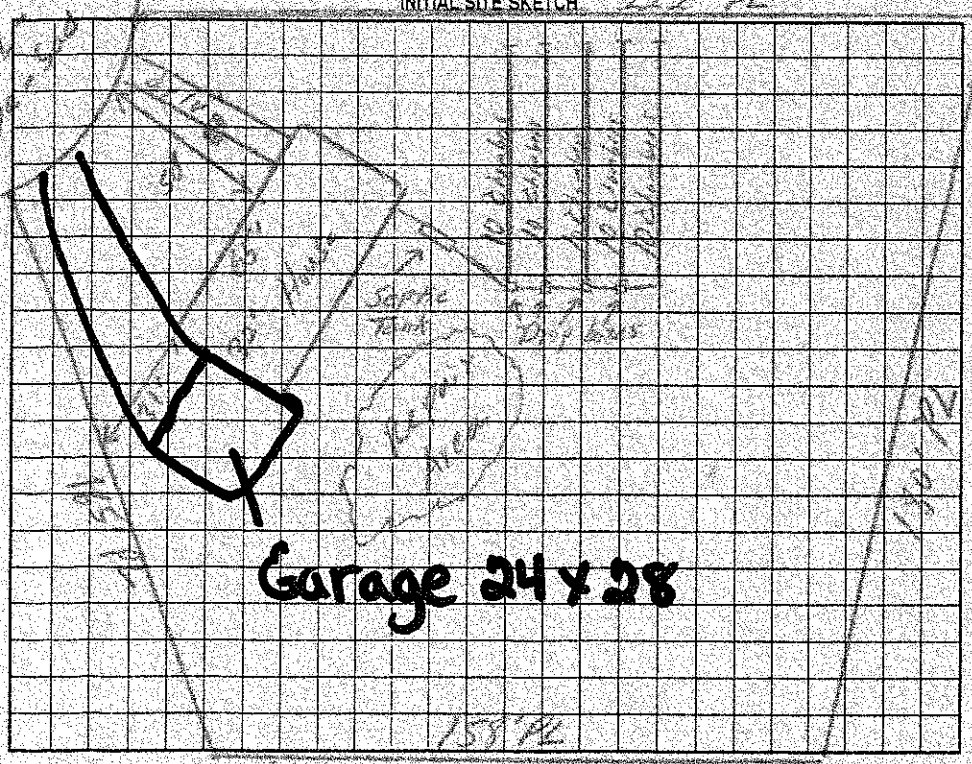

AS BUILT SKETCH

The proposed Garage + Addition addition does not appear to impact the existing septic system.

**NOTE:

R.S.

Date: 21 May 01

ICHD-Environmental Health Division

Permit can be suspended or revoked if any false information is supplied toward securing the permit/any unauthorized changes are made to the site/any unauthorized changes are made in the installation of the system. Improvement Permit with plat valid without expiration. Improvement Permit with site plan valid for sixty months. Authorization to Construct is valid for a period equal to that of Improvement Permit – not to exceed sixty months.

Signed: date 4/13/01 Installed by:

Improvement Permit by: date 4/13/01 Operation Permit by: date

Authorization to Construct by: date 4/13/01 Existing System Inspection by: date

HEALTH DEPT. COPY: WHITE OWNER COPY (FINAL): YELLOW OWNER COPY (INITIAL): PINK