IREDELL COUNTY HEALTH DEPARTMENT

STATESVILLE 704-878-5305 CI MOORESVILLE 704-664-5281

IMPROVEMENT PERMIT / AUTHORIZATION TO CONSTRUCT / OPERATION PERMIT / EXISTING SYSTEM INSPECTION

PERMIT# 107046 PIN# 3774-86-~~5932~~ 5956 DATE 7/9/02

OWNER OR CONTRACTOR Larry Michael Beaver PHONE: Business — Home (704) 873-8219

ADDRESS 122 Karmen Lane Statesville N.C. 28677

LOCATION Hwy 40 W, (R) Sharon School Rd, (L) on Stewart Rock Rd, (L) on Fulbright @ end on Right

SUBDIVISION Patriots Point BLOCK / SECTION — LOT 7 LOT AREA 2.779 Ac. SITE CLASS. PS DESIGN FLOW 360 L.T.A.R.

Septic Tank: 1,000 Gallons; STB 1012 Date 12-10-02

Pump Tank: Gallons; PT Date

Pump Make: Model Serial No.

Nitrification Field: No Fields 1 Square Feet 1200 Linear Feet 400'

No Lines 4@100' Trench Width 36" Max Trench Bottom Depth 30" Gravel Depth 12"

[X] New System ☐ Repair System Type: I, (II), III, IV, V, VI

System Description: Gravity, Conventional

Repair System Description: Gravity/Pump, 25% Red.

Maintenance Agreement Required: ☐ Yes [X] No

[X] House/Mod. Home ☐ Mobile Home ☐ Business ☐ Other

No. Bedrooms 3 No. Bathrooms 2 No. Employees

☐ Slab [X] Crawl Space ☐ Basement w/plumbing ☐ Basement wo/plumbing


Water Supply: [X] Individual ☐ Public ☐ Community

Comments:/Conditions: (1) Call Health Dept prior to installation to layout system (2) Install lines on Contour

Comments:/Conditions: — Label filter + S.T. Marker

INITIAL SITE SKETCH

AS BUILT SKETCH

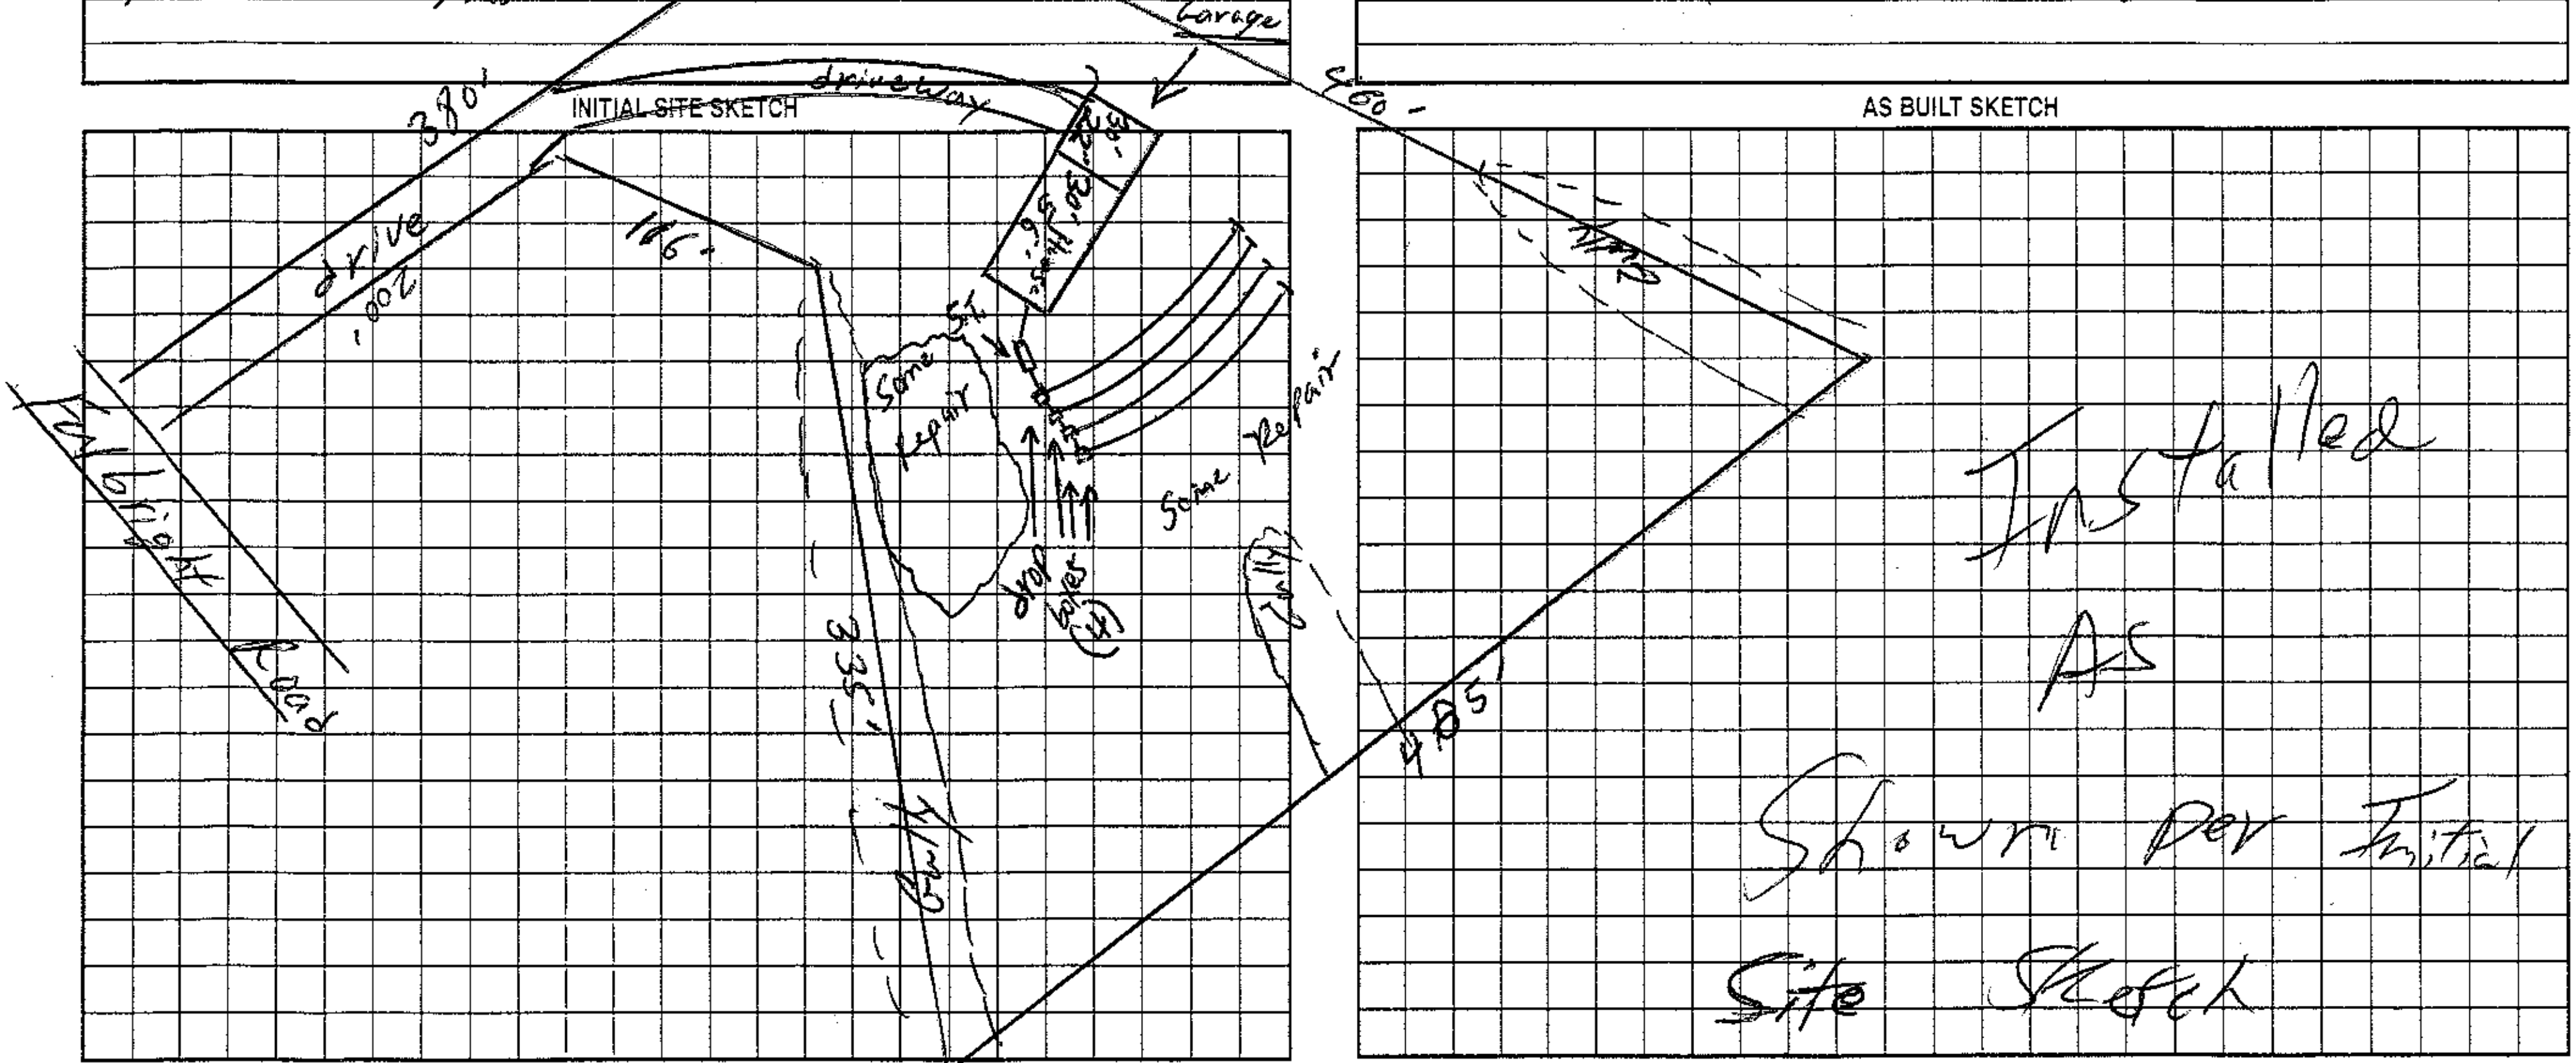

Permit can be suspended or revoked if any false information is supplied toward securing the permit/any unauthorized changes are made to the site/any unauthorized changes are made in the installation of the system. Improvement Permit with plat valid without expiration. Improvement Permit with site plan valid for sixty months. Authorization to Construct is valid for a period equal to that of Improvement Permit – not to exceed sixty months.

Signed: Larry Michael Beaver date

Improvement Permit by: William O. Johnson date 7/9/02

Authorization to Construct by: William O. Johnson date 7/9/02

Installed by: A-1 Backhoe

Operation Permit by: William O. Johnson date 6/25/03

Existing System Inspection by: date

HEALTH DEPT. COPY: WHITE OWNER COPY (FINAL): YELLOW OWNER COPY (INITIAL): PINK