IREDELL COUNTY HEALTH DEPARTMENT

STATESVILLE 704-878-5305 MOORESVILLE 704-664-5281

IMPROVEMENT PERMIT / CERTIFICATE OF COMPLETION / OPERATION PERMIT / EXISTING SYSTEM INSPECTION

1:30 (3)

PROPERTY DESCRIPTION NO. C7617 DATE 08-02-97 TAX MAP NO. Watershed: ☒ Yes ☐ No

OWNER OR CONTRACTOR KEJ MARKETING CO. INC. PHONE: Business 847-6006 Home

ADDRESS P.O. BOX 1627 MATHEWS N.C. 28106

LOCATION GARDNER PT. 1ST LOT ON LEFT, PAST RIVERCLIFF DR.

SUBDIVISION RIVERWALK BLOCK / SECTION VIII LOT 16 LOT AREA 2.082 AC SITE CLASS. P5 DESIGN FLOW 360 L.T.A.R. .325

Septic Tank: 1000 Gallons; STB 1012 Date 10-10-98

Pump Tank: Gallons; PT Date

Pump Make: Model Serial No.

Nitrification Field: No Fields 1 Square Feet 1110 Linear Feet 370+

No Lines THREE Trench Width 36" Max Trench Bottom Depth 36" Gravel Depth 12"

☒ New System ☐ Repair System Type: I (II) III, IV, V, VI

System Description: CONVENTIONAL GRAVITY

Repair System Description:

Maintenance Agreement Required: ☐ Yes ☒ No

☒ House/Mod. Home ☐ Mobile Home ☐ Business ☐ Other

No. Bedrooms 3 No. Bathrooms 2 No. Employees


☐ Slab ☒ Crawl Space ☐ Basement w/plumbing ☐ Basement wo/plumbing

Water Supply: ☒ Individual ☐ Community ☐ Public "WELL"


Comments: PLUMB OUT RT. REAR OF HOUSE AND SET TANK. INSTALL THREE 125' TRENCHES AS SHOWN ON DIAGRAM ON CONTOUR, MAINTAIN 100' MIN. FROM ANY WELL.

Comments:

INITIAL SITE SKETCH

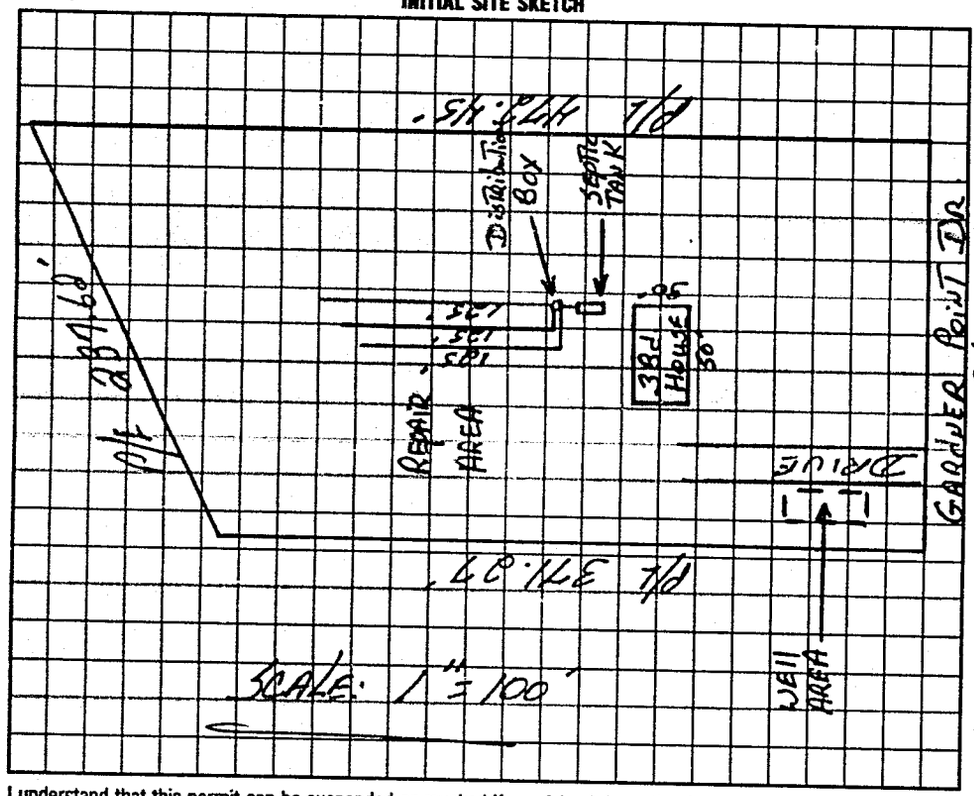

AS BUILT SKETCH

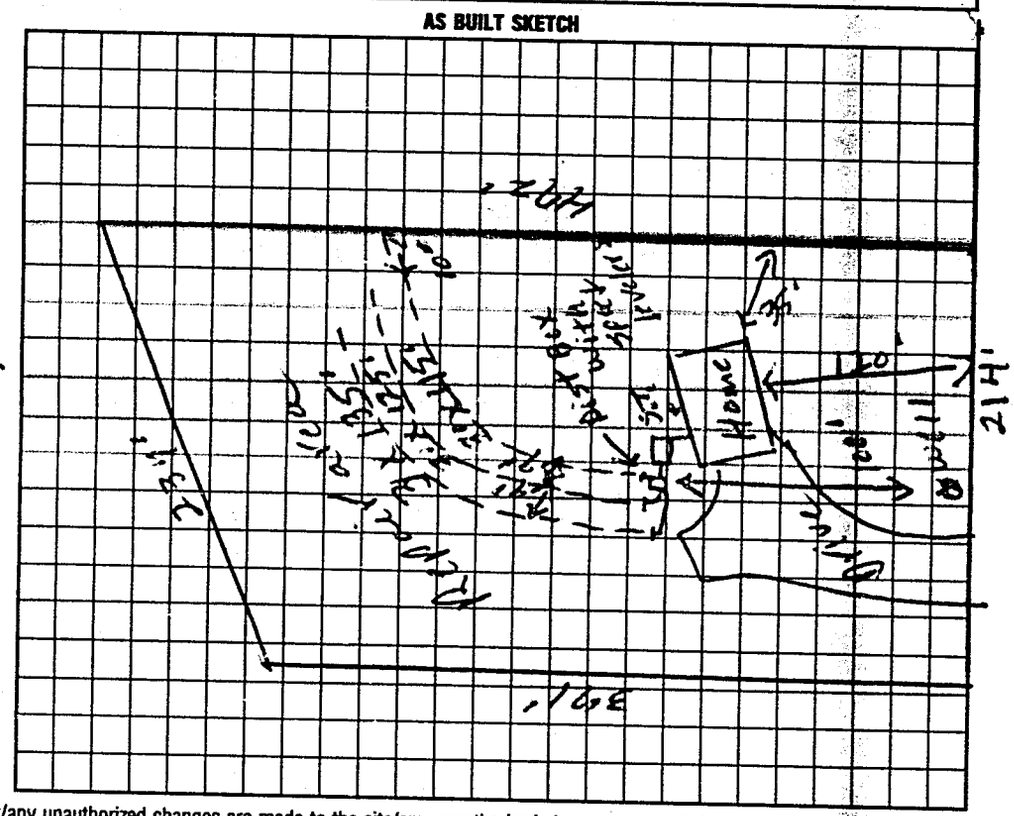

I understand that this permit can be suspended or revoked if any false information is supplied toward securing the permit/any unauthorized changes are made to the site/any unauthorized changes are made in the installation of the system. Improvement Permit is valid for 60 months from date of issuance.

Signed: Owner/Contractor/Agent

Improvement Permit by: DORIAN G. DIXON date 08-02-97

AUTHORIZATION TO CONSTRUCT

~~Existing System Inspection by:~~ DORIAN G. DIXON date 08-02-97

Installed by: TOMMY EVYE

Certificate of Completion by: date

Operation Permit by: C. C. MOORE date 12-18-98

HEALTH DEPT. COPY: WHITE INSPECTION COPY (FINAL): GREEN OWNER COPY (FINAL): YELLOW INSPECTION COPY (INITIAL): PINK OWNER COPY (INITIAL): GOLD

2622 0