IREDELL COUNTY HEALTH DEPARTMENT

Statesville Office (704) 878-5305 Mooresville Office (704) 660-3625 PERMIT # 231857 ~~228005~~

SEPTIC IMPROVEMENT PERMIT / AUTHORIZATION TO CONSTRUCT / OPERATION PERMIT / EXISTING SYSTEM

PIN # 3774868663

APPLICANT/OWNER: Raymond McLillian APPLICANT ADDRESS: 242 Fulbright RD Stony Point NC 28678.

SITE ADDRESS: 242 Fulbright RD Stony Point NC 28678 PHONE: 704-928 7461 ALT. PHONE —

SITE DIRECTIONS: I-40 to Sharon School RD Left on Stewart Rock Left on Fulbright SAP CONTROLLED: ☐ YES ☒ NO


SUBDIVISION: ~ SECTION: ~ LOT # ~ LOT AREA: 2.43 Acres. DESIGN FLOW: 360 L.T.A.R.: .25

Septic Tank	1000 (gal)	STB	760	Date	11-21-17	☐ New System ☒ Repair ☐ Expansion System Type: I II (III) IV V VI	☒ Residence	No. Bedrooms	3	Water Supply	
Pump Tank	~ (gal)	PT	~	Date	~	System Description: 25% Reduction	☐ Business	No. Persons	6	☒ Private	
Pump Make	~	Model	~	Serial #	~	Repair System Description:	☐ Other	No. Employees		☐ Public	
# Nitrification Fields	1	# Lines	4	Linear Ft	360	Maintenance Agreement Required: ☐ YES ☒ NO	☐ Slab	☒ Crawl Space		☐ Community	
Trench Width	36.	Trench Bottom Depth(Low side)	30	Gravel Depth	~	☒ GRAVITY ☐ PRESSURE	☐ Basement w/ plumbing			☐ Basement w/o plumbing	


Comments / Conditions: Install complete Septic system on the contour of the Land and utilize serial distribution. Crush/Fill or haul away old septic tank. Do not drive upon, park, pave, or grade the drain field area.

Keep system out of Powerline R.O.W.

INITIAL SITE SKETCH

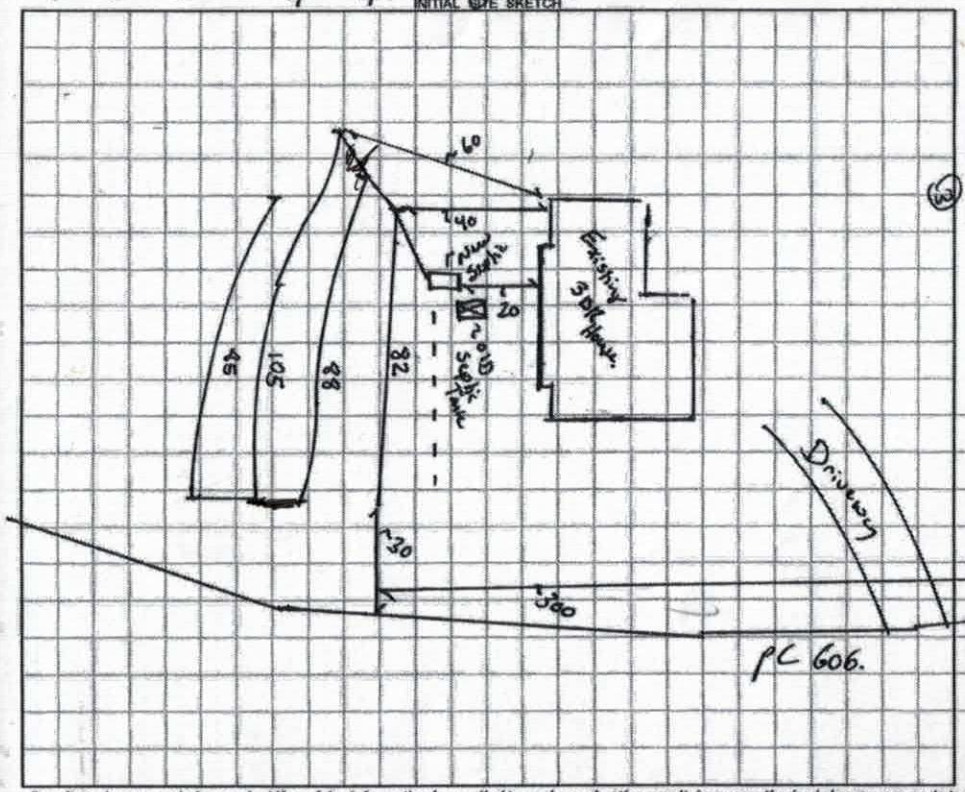

AS BUILT SKETCH

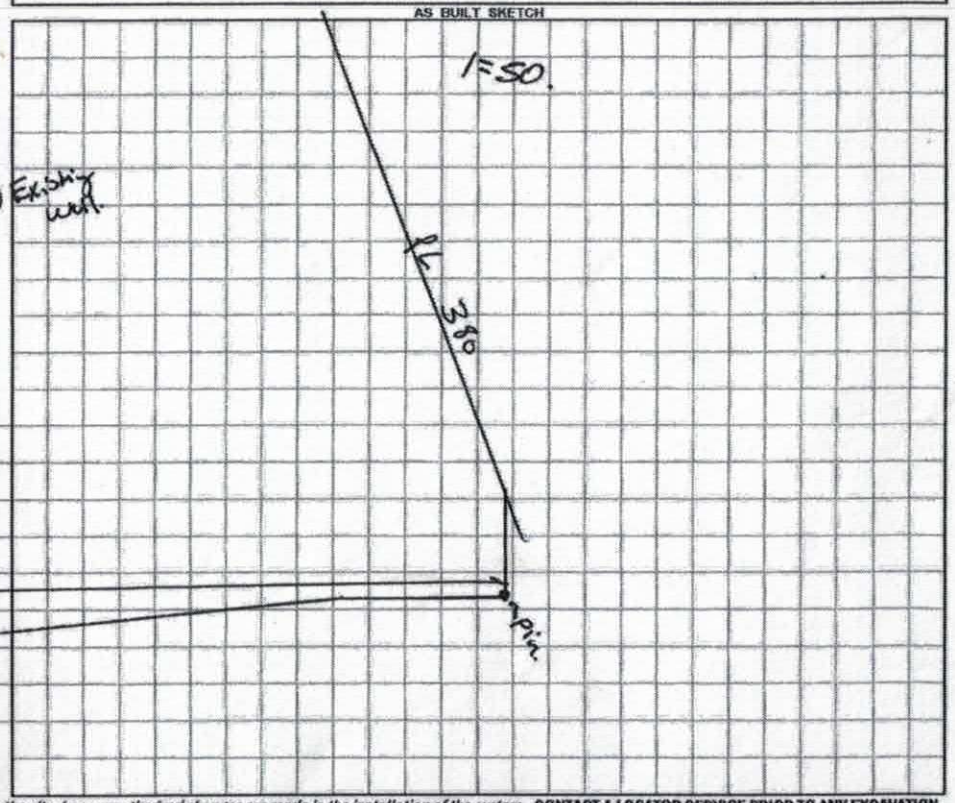

Permit can be suspended or revoked if any false information is supplied toward securing the permit / any unauthorized changes are made to the site / any unauthorized changes are made in the installation of the system. **CONTACT A LOCATOR SERVICE PRIOR TO ANY EXCAVATION**

☐ **IMPROVEMENT PERMIT** *with plat valid without expiration.* ☐ **IMPROVEMENT PERMIT** *with site plan valid for 60 mos.* ☐ **AUTHORIZATION TO CONSTRUCT** *valid for period equal to IMPROVEMENT PERMIT--not to exceed 60 mo.*

Owner / Applicant Signature: [signature] Date: 01-2-18 Installed by: Lentz Septic

IMPROVEMENT PERMIT by: Benjamin Bottoms Date: 12/15/2017 OPERATION PERMIT by: Marian Dotson Date: 1/31/18

AUTHORIZATION TO CONSTRUCT by: Benjamin Bottoms Date: 12/15/2017 Existing System Inspected by: Date:

FOR SEPTIC FINAL INSPECTION: CALL 704-664-3703 between 8am-9am the day the inspection is needed. Be sure to speak with an inpsector to confirm your inspection time.

DEPARTMENT OF HEALTH AND HUMAN SERVICES
DIVISION OF PUBLIC HEALTH, ENVIRONMENTAL HEALTH SECTION
ON-SITE WATER PROTECTION BRANCH

82
86
105
85

Sheet 1 of 1

SOIL/SITE EVALUATION
for **ON-SITE WASTEWATER SYSTEM**
(Complete all fields in full) Repair

OWNER: Melikian.
ADDRESS: 242 Fulbright Stony Point. NC
PROPOSED FACILITY: Home SFR PROPOSED DESIGN FLOW (.1949): 360
LOCATION OF SITE:

APPLICATION DATE 12/6/2017.
DATE EVALUATED: 12/12/2017
PROPERTY SIZE: 2.91 Ac
PROPERTY RECORDED: yes.

WATER SUPPLY: ☐ Private ☑ Public ☐ Well ☐ Spring ☐ Other
EVALUATION METHOD: ☑ Auger Boring ☐ Pit ☐ Cut TYPE OF WASTEWATER: ☐ Sewage ☐ Industrial Process ☐ Mixed

PROFILE #	.1940 LANDSCAPE POSITION/ SLOPE %	HORIZON DEPTH (IN.)	SOIL MORPHOLOGY (.1941)		OTHER PROFILE FACTORS				PROFILE CLASS & LTAR
			.1941 STRUCTURE/ TEXTURE	.1941 CONSISTENCE/ MINERALOGY	.1942 SOIL WETNESS/ COLOR	.1943 SOIL DEPTH	.1956 SAPRO CLASS	.1944 RESTR HORIZ	
1	10-15% Side.	0-3	Top						
		3-24	C SBK	SSSp FR SEHP	2.5YR4/8	50		Many Litho white litho.	PS .25
		24-50	CL WSBK.	SSSp FM ↓	2.5YR4/6.				
2	Side 10-15%	0-3	Top						
		3-40	C SBK	SSSp FR SFqp		49.			PS .3
		40-48	CL	SSSp FM ↓					
3									
4									

DESCRIPTION	INITIAL SYSTEM	REPAIR SYSTEM
Available Space (.1945)		360
System Type(s)		III 25%
Site LTAR		.825

OTHER FACTORS (.1946): Repair
SITE CLASSIFICATION (.1948): PS.
EVALUATED BY: Botkin
OTHER(S) PRESENT: Cave.

COMMENTS:

LEGEND

use the following standard abbreviations

LANDSCAPE POSITION	GROUP	SOIL TEXTURE	CONVENTIONAL .1955 LTAR*	LPP .1957 LTAR*	MINERALOGY/ CONSISTENCE	STRUCTURE
CC (Concave Slope) CV (Convex Slope) D (Drainage Way) DS (Debris Slump) FP (Flood Plain) FS (Foot Slope) H (Head Slope) L (Linear Slope) N (Nose Slope) R (Ridge) S (Shoulder Slope) T (Terrace)	I	S (Sand) LS (Loamy Sand)	1.2 - 0.8	0.6 - 0.4	SEXP (Slightly Expansive) EXP (Expansive)	G (Single Grain) M (Massive) CR (Crumb) GR (Granular) SBK (Subangular Blocky) ABK (Angular Blocky) PL (Platy) PR (Prismatic)
	II	SL (Sandy Loam) L (Loam)	0.8 - 0.6	0.4 - 0.3		
	III	Si (Silt) SiCL (Silty Clay Loam) CL (Clay Loam) SCL (Sandy Clay Loam) SiL (Silt Loam)	0.6 - 0.3	0.3 - 0.15		
	IV	SC (Sandy Clay) SiC (Silty Clay) C (Clay) O (Organic)	0.4 - 0.1	0.2 - 0.05		
			None	None		

MOIST	WET
VFR (Very Friable)	NS (Non-sticky)
FR (Friable)	SS (Slightly Sticky)
FI (Firm)	S (Sticky)
VFI (Very Firm v. Very Sticky)	VS (Very Sticky)
EFI (Extremely Firm)	NP (Non-plastic)
	SP (Slightly Plastic)
	P (Plastic)
	VP (Very Plastic)

*Adjust LTAR due to depth, consistence, structure, soil wetness, landscape, position, wastewater flow and quality.


NOTES

HORIZON DEPTH	In inches below natural soil surface
DEPTH OF FILL	In inches from land surface
RESTRICTIVE HORIZON	Thickness and depth from land surface
SAPROLITE	S(suitable) or U(unsuitable)
SOIL WETNESS	Inches from land surface to free water or inches from land surface to soil colors with chroma 2 or less - record Munsell color chip designation
CLASSIFICATION	S (Suitable), PS (Provisionally Suitable), or U (Unsuitable)

Evaluation of saprolite shall be by pits.

Long-term Acceptance Rate (LTAR): gal/day/ft^2

Show profile locations and other site features (dimensions, reference or benchmark, and North).

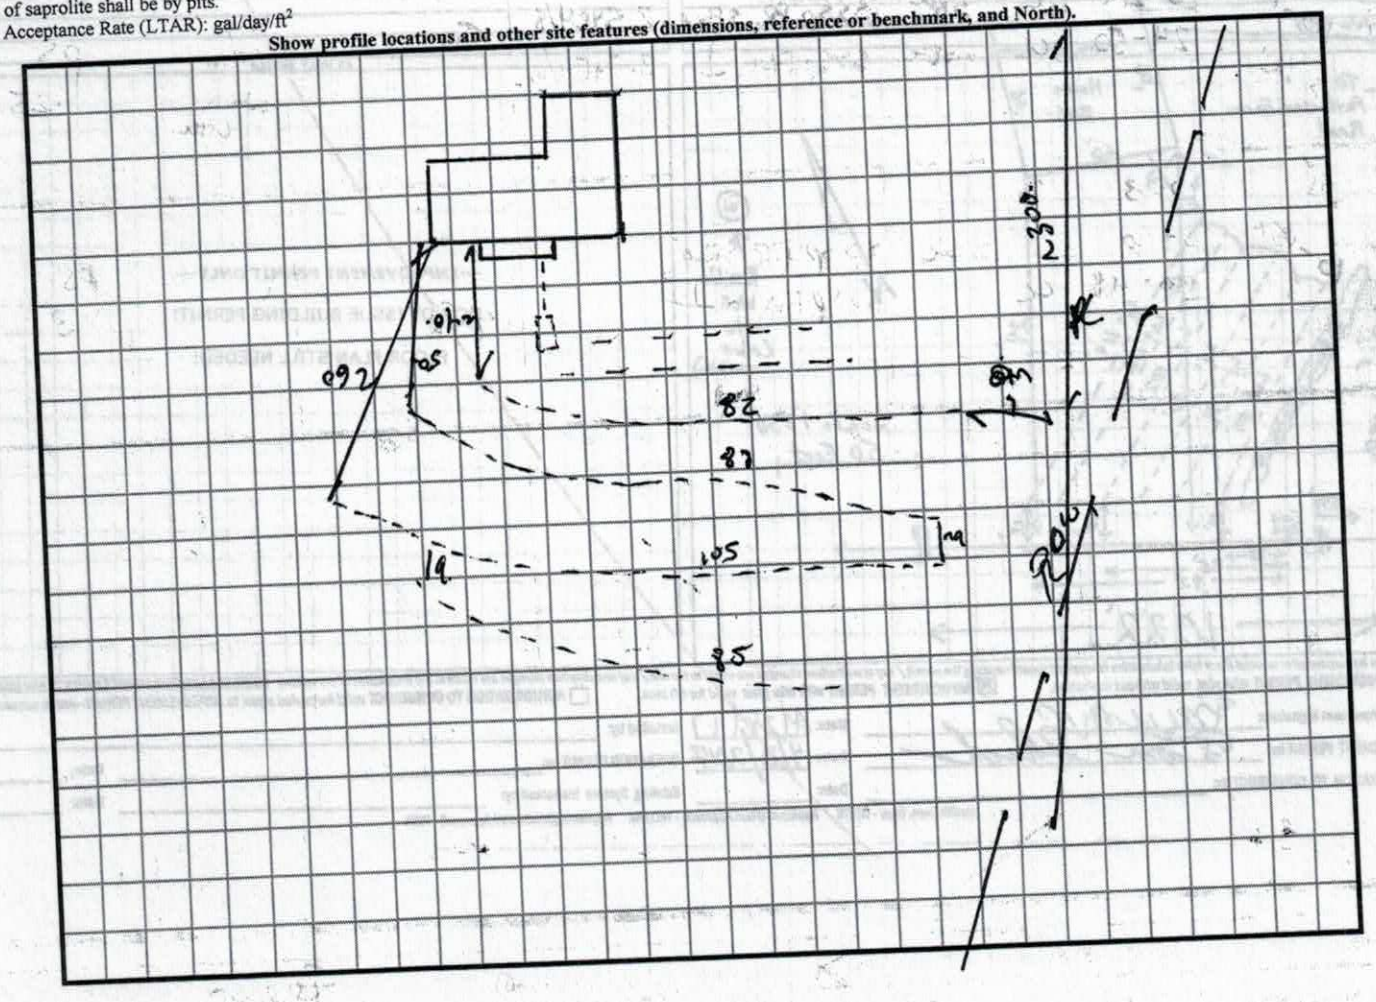

IREDELL COUNTY HEALTH DEPARTMENT *ENVIRONMENTAL HEALTH DIVISION*

(THE ABOVE PERMIT DOCUMENTS WILL BECOME INVALID IF INFORMATION PROVIDED ON THIS APPLICATION IS FALSIFIED OR CHANGED, OR IF THE SITE IS ALTERED. THE IMPROVEMENT PERMIT IS VALID FOR EITHER 60 MONTHS OR WITHOUT EXPIRATION DEPENDING UPON DOCUMENTATION SUBMITTED - APPLICATION WITH SITE PLAN 60 MONTHS, APPLICATION WITH COMPLETE, SCALED PLAT WITHOUT EXPIRATION. SEE 15A NCAC 18A .1937(f) FOR DETAILS)

1. APPLICATION FOR: ___Improvement Permit ✓Authorization To Construct ___ Existing System Inspection

2. Page 2: *Site Plan Worksheet* Form MUST Accompany This Application
The following optional attachments may also be submitted: ___Survey Plat, Scaled no more than 1 Inch = 60 Feet
Place check ( ) beside whichever is submitted if applicable ___Custom Site Plan, Scaled no more than 1 Inch = 60 Feet

3. Applicant Information:

Applicant Name	Mailing Address	Home Phone #	Alternate Phone #
Raymond MeLiKian	242 Fulbright, Stonypoint	704-928-7461	Call before going out Thx
Owner Name	Mailing Address	Home Phone #	Alternate Phone #
			Cops

4. Property Information:

Street Address	Subdivision Name	Section/Phase and Lot Number
242 Fulbright Rd, Stonypoint		

Driving Directions: 40 TO SHARON School EXIT, LEFT ON STWART Rd, LEFT ON Fulbright

5. RESIDENTIAL Site Development Information: *(Check or Complete ALL that apply)*

( ) New, Single Family Residence
( ) New, Multi-Family Residence
( ) Expansion of Existing Septic System
(X) Repair To Failing Septic System due to Old Age
( ) Other

Maximum Number of Bedrooms 3
Maximum Number of Occupants 2
If Expansion, Current Number of Bedrooms ___

(✓) Crawl Space Foundation?
( ) Concrete Slab Foundation?
( ) Basement w/Plumbing?
( ) Basement w/out Plumbing?

IF Non- Residential Site Development:
Type of Business
Square Footage of Building
Maximum Number of Employees
Maximum Number of Seats

6. Proposed Water Supply:

( ) New Well (✓) Existing Well ( ) Community Well ( ) City Water ( ) Other Public Water

7. Desired Septic System Type: *(You may rank in order of preference, if any)* ( ) EXISTING SYSTEM installed ? Year

( ) Alternative (✓) Conventional ( ) Innovative ( ) Modified Conventional ( ) Other_____

8. Please Answer The Following To The Best of Your Ability:
( ) Yes (✓) No Does the site contain any jurisdictional wetlands?
( ) Yes (✓) No Is any non-domestic sewage (i.e. industry) to be generated?
( ) Yes (✓) No Is the site subject to approval by any other public agency?

I have read this application and certify that the information provided herein is true, complete, and correct. Authorized county and state officials are granted right of entry to conduct necessary inspections to determine compliance with applicable laws and rules. I understand that I am solely responsible for the proper identification and labeling of all property lines and corners and making the site accessible so that a complete site evaluation can be performed.

9. Signature: _____ 6-17-2017
Property owner or owner's legal representative signature (SIGNATURE REQUIRED) DATE

IREDELL COUNTY HEALTH DEPARTMENT
JANE MURRAY, RN BSN MS
HEALTH DIRECTOR

Public Health
Prevent. Promote. Protect.
Iredell County Health Department

Notice of Intent to SUSPEND/REVOKE Improvement Permit/Construction Authorization
____1/4/18_____**(Date)**

Owner: _Raymond Melikian
Address:242 Fulbright Rd Stony Point NC 28678
_____
_____

Subject: Notice of Intent to Revoke/Suspend 242 Fulbright Rd Stony Point NC 28678 Permit # 228005_____ **(specify name/location)** Improvement Permit/Construction Authorization

Dear ____Raymond Melikian :
(Owner's Name)

The Iredell County Health Department (ICHD) inspected the site for the on-site wastewater system located at _242 Fulbright Rd Stoney Point NC 28678 _____ (physical address) for compliance with the Laws (Article 11 of Chapter 130A of the North Carolina General Statutes), Rules (15A NCAC 18A .1900 et seq.), and Improvement Permit/Construction Authorization ___228005 Type III_____ (specify type and number) conditions. As a result of this inspection, the Department has determined the following violations:

Violation	Law or Rule Citation
Change of repair permit guidelines going from tank replacement to entire drainfield replacement.	

_____
_____
_____
_____

[Example #1 - 18 inches of soil removed from site in violation of NCGS 130A-335(f), Rule .1937(g), Rule .1943, Rule .1947(c), and IP Condition No. 2.]
[Example #2 - Nitrification trenches installed at a depth of 30 inches in violation of Rule .1955 (m) and CA Condition No. 2.]

This is to notify you that based on these violations, the Department intends to suspend/revoke (specify) your Improvement Permit/Construction Authorization (specify) 30 days from the date of this notice.

If the ICHD determines that all of the violations have been corrected before thirty (30) days expire, the suspension/revocation (specify) will not go into effect. *[Insert for suspension]* If the permit is suspended, the health department must determine that the violations have been corrected before the suspension will be lifted. *[Insert for revocation]* If the permit is revoked, you must apply for a new Improvement Permit/Construction Authorization and meet the requirements of the current laws and rules necessary to obtain a new IP/CA.

You have a right to an informal review of this decision. You may request an informal review by the environmental health supervisor at the local health department. You may also request an informal review by the NC Department of Health and Human Services Regional Soil Scientist. A request for informal review must be made in writing to the local health department.

You also have a right to a formal appeal of this decision. To pursue a formal appeal, you must file a petition for a contested case hearing with the Office of Administrative Hearings, 6714 Mail Service Center, Raleigh, NC 27699-6714. You may write the Office of Administrative Hearings, call the office at (919) 431-3000 or get a copy of the petition form from the OAH web site at http://www.ncoah.com/forms.html . The petition for a contested case hearing must be filed in accordance with the provision of North Carolina General Statutes 130A-24 and 150B-23 and all other applicable provisions of Chapter 150B. North Carolina General Statute 130A-335 (g) provides that your hearing would be held in the county where your property is located.

If you wish to pursue a formal appeal, you must file the petition form with the Office of Administrative Hearings **WITHIN 30 DAYS OF THE DATE OF THIS LETTER.** The date of this letter is __1/4/18_____. Meeting the 30 day deadline is critical to your formal appeal.

If you file a petition for a contested case hearing with the Office of Administrative Hearings, you are required by law (NC General Statute 150B-23) to serve a copy of your petition on the Office of General Counsel, NC Department of Health and Human Services, 2001 Mail Service Center, Raleigh, NC 27699-2001.

Do not serve the petition on your local health department. Sending a copy of your petition to the local health department will not satisfy the legal requirement in NC General Statute 150B-23 that you send a copy to the Office of General Counsel, 2001 Mail Service Center, NC Department of Health and Human Services.

You may contact our office at 704-878-5305 x3456 or by fax at 704-871-3483.

Sincerely,

Benjamin A Barber 1/4/2018

Signature of DHHS Authorized Agent

IREDELL COUNTY HEALTH DEPARTMENT

Statesville Office (704) 878-5305 Mooresville Office (704) 660-3625 PERMIT # 228005

SEPTIC IMPROVEMENT PERMIT / AUTHORIZATION TO CONSTRUCT / OPERATION PERMIT / EXISTING SYSTEM

PIN # 3774-86-8663

APPLICANT/OWNER: Raymond Melikian APPLICANT ADDRESS: 242 Fulbright Rd Stony Point, NC

SITE ADDRESS: 242 Fulbright Rd. Stony Point, NC PHONE: 704-928-7461 ALT. PHONE

SITE DIRECTIONS: 40 to Sharon School Rd → L on Stuart Rock Rd → L on Fullbright → @end SAP CONTROLLED: ☐ YES ☒ NO

SUBDIVISION: — SECTION: — LOT # — LOT AREA: 2.43 DESIGN FLOW: 360 GPD L.T.A.R.: —

Septic Tank	1000	(gal)	STB		Date				
Pump Tank	—	(gal)	PT	—	Date	—			
Pump Make	—		Model	—	Serial #	—			
# Nitrification Fields	1 Ex	# Lines	2 - Ex		Linear Ft	Ex			
Trench Width	Ex	Trench Bottom Depth(Low side)		Ex	Gravel Depth	Ex			

☐ New System ☒ Repair ☐ Expansion System Type: I (II) III IV V VI

System Description: Replace septic tank as requested

Repair System Description: + re-connect top lateral to system

Maintenance Agreement Required: ☐ YES ☒ NO

☒ GRAVITY ☐ PRESSURE


☒ Residence ☐ Business ☐ Other ☐ Slab ☒ Crawl Space ☐ Basement w/plumbing ☐ Basement w/o plumbing

No. Bedrooms 3 No. Persons 6 No. Employees


Water Supply: ☒ Private ☐ Public ☐ Community

Comments / Conditions: Top drainfield lateral dry on 6/22/17 while lower lateral saturated. Recommend new septic tank be pumped every 3-5 years. Existing septic tank shall be pumped + crushed in place. Should the system malfunction again in the future, another permit for drainfield replacement may be needed.

INITIAL SITE SKETCH

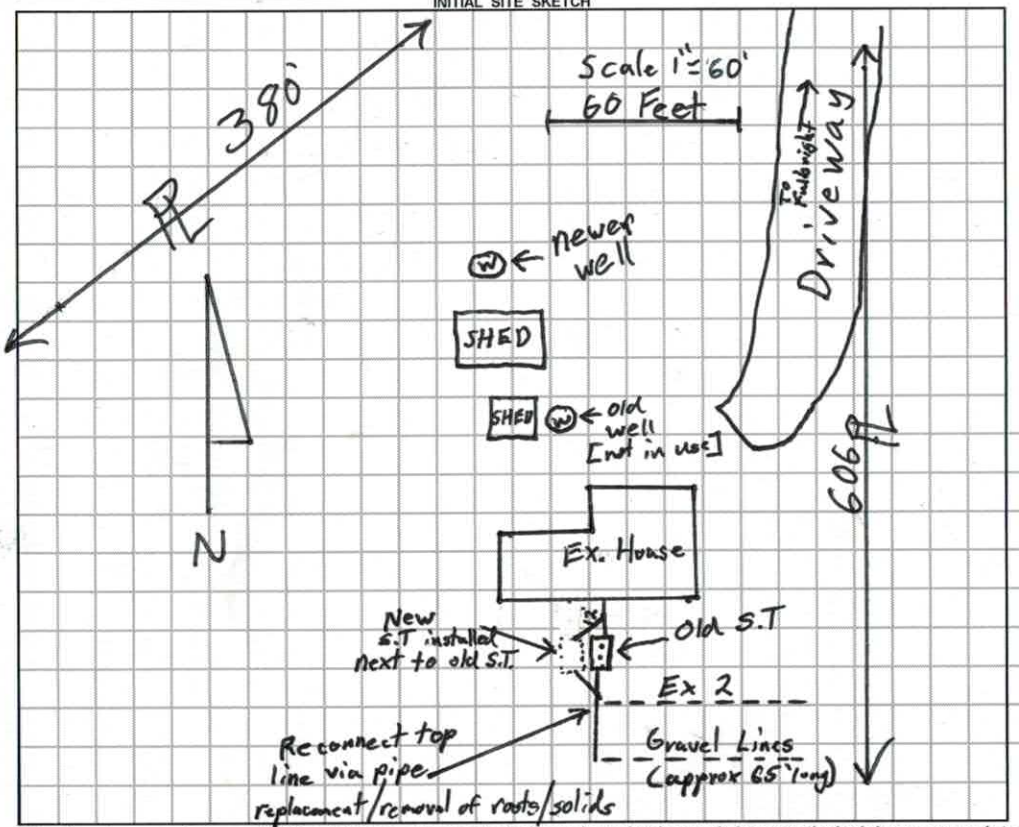

AS BUILT SKETCH

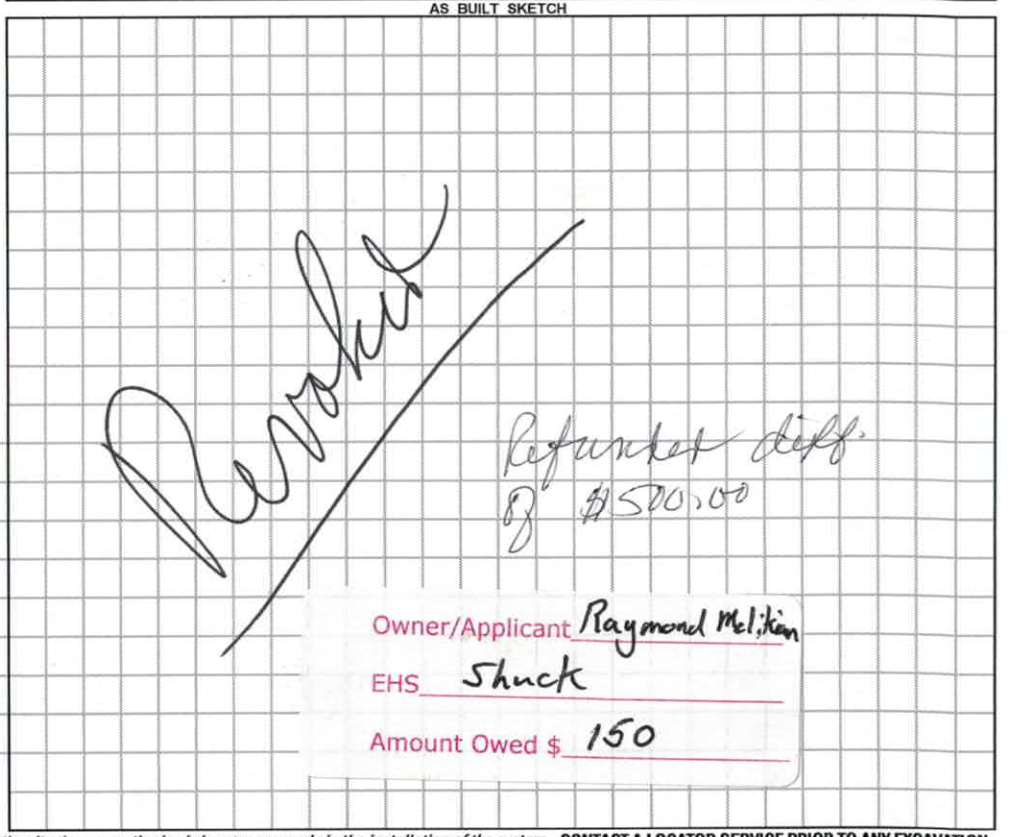

Permit can be suspended or revoked if any false information is supplied toward securing the permit / any unauthorized changes are made to the site / any unauthorized changes are made in the installation of the system. **CONTACT A LOCATOR SERVICE PRIOR TO ANY EXCAVATION**

☐ **IMPROVEMENT PERMIT** *with plat valid without expiration.* ☒ **IMPROVEMENT PERMIT** *with site plan valid for 60 mos.* ☒ **AUTHORIZATION TO CONSTRUCT** *valid for period equal to IMPROVEMENT PERMIT--not to exceed 60 mo.*

Owner / Applicant Signature: Date: Installed by:

IMPROVEMENT PERMIT by: Tom Shuck Date: 6/30/2017 OPERATION PERMIT by: Date:

AUTHORIZATION TO CONSTRUCT by: Tom Shuck Date: 6/30/2017 Existing System Inspected by: Date:

IREDELL COUNTY HEALTH DEPARTMENT *ENVIRONMENTAL HEALTH DIVISION:*

SITE PLAN WORKSHEET

SEE THE "SAMPLE SITE PLAN" BELOW. ***INCOMPLETE SITE PLANS WILL BE RETURNED TO YOU FOR COMPLETION AND MAY RESULT IN A DELAY IN THE ISSUANCE OF YOUR SEPTIC SYSTEM PERMIT!!!***

Place an (X) beside each item as you complete the site plan:

__X__ Property Line measurements are clearly identified... **__X__ All proposed structures are indicated...**

SHOW: proposed house or business footprint, wells, water lines, patios, pools and decks, and any other item that will occupy space on the site


_____ Front and side setbacks from property line... **_____ Preferred driveway location and configuration, preferred well location...**

_____ Area you prefer your septic system to be placed... **_____ North arrow, or other sufficient indicator of direction...**


Circle N/A on the following if appropriate:

_____ Location of septic systems and wells within 100' of your property... N/A

_____ Location of easements and rights of ways on your property... N/A **_____ Location of any designated wetlands on the property... N/A**

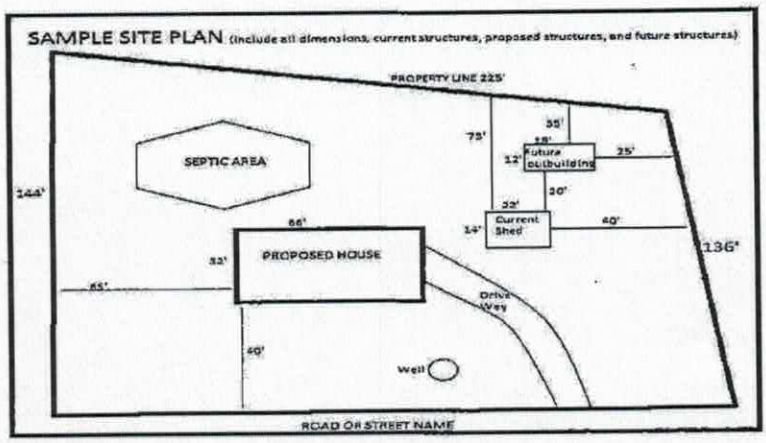

USE THIS SPACE TO DRAW YOUR SITE PLAN

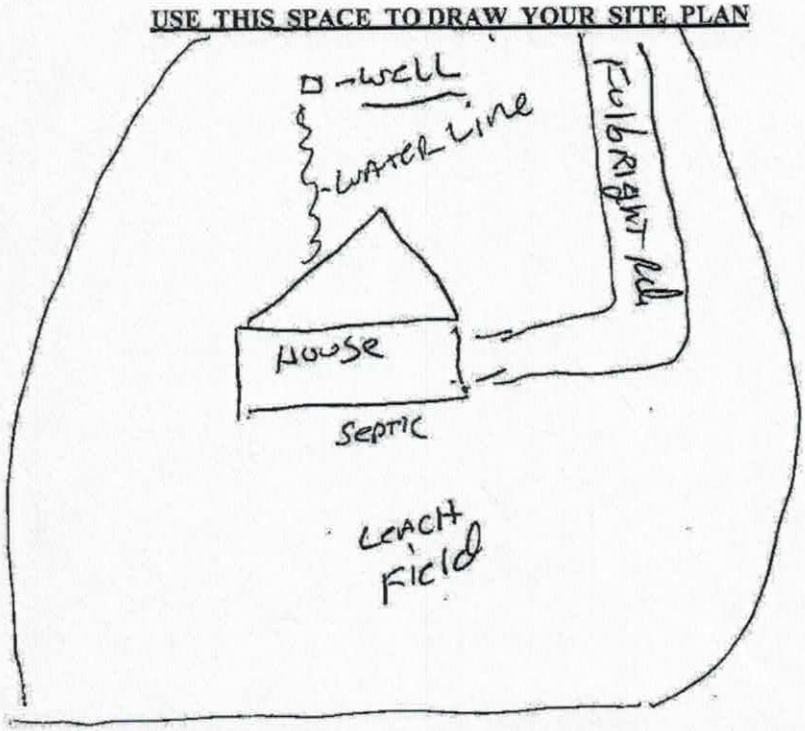

Signature: Heath

REQUIRED **property owner or owner's legal representative signature.**

6-17-2017

DATE