IREDELL COUNTY HEALTH DEPARTMENT

THIS PERMIT VOIDS PREVIOUS ISSUED 9/23/97

STATESVILLE 704-878-5305 MOORESVILLE 704-664-5281

IMPROVEMENT PERMIT / AUTHORIZATION TO CONSTRUCT / OPERATION PERMIT / EXISTING SYSTEM INSPECTION

PERMIT# 073611 PIN# 3774 92 2623 DATE 5-9-98

OWNER OR CONTRACTOR KENT SHAW / SCOTT BRIDGEMAN PHONE: Business _____ Home KENT SHAW 528-4494

ADDRESS 305 CHESTNUT LANE, STATESVILLE, NC 28677

LOCATION I-40W, TR SHARON SCHOOL RD, TL STEWART ROCK, TR FULBRIGHT, TR GARDNER POINT, 3RD LOT ON RIGHT

SUBDIVISION RIVERWALK BLOCK / SECTION 6 LOT 16 LOT AREA 3.10 ACRES SITE CLASS. PS DESIGN FLOW 360 L.T.A.R. 0.30 GPD/FT²

Septic Tank: 1000 Gallons; STB 794 Date 9-9-98

Pump Tank: _____ Gallons; PT _____ Date _____

Pump Make: _____ Model _____ Serial No. _____

Nitrification Field: No Fields 1 Square Feet 1200 Linear Feet 400

No Lines THREE Trench Width 36" Max Trench Bottom Depth 36" Gravel Depth 12"

☑ New System ☐ Repair System Type: I (II) III, IV, V, VI

System Description: CONVENTIONAL GRAVITY

Repair System Description: CONV. GRAVITY

Maintenance Agreement Required: ☐ Yes ☑ No

☑ House/Mod. Home No. Bedrooms 3

☐ Mobile Home No. Bathrooms 2½

☐ Business No. Employees _____

☐ Other _____

☐ Slab ☑ Crawl Space ☐ Basement w/plumbing ☐ Basement wo/plumbing

Water Supply: ☑ Individual ☐ Public ☐ Community


WELL

Comments:/Conditions:

Comments:/Conditions:

SCALE: 1" = 50'

INITIAL SITE SKETCH

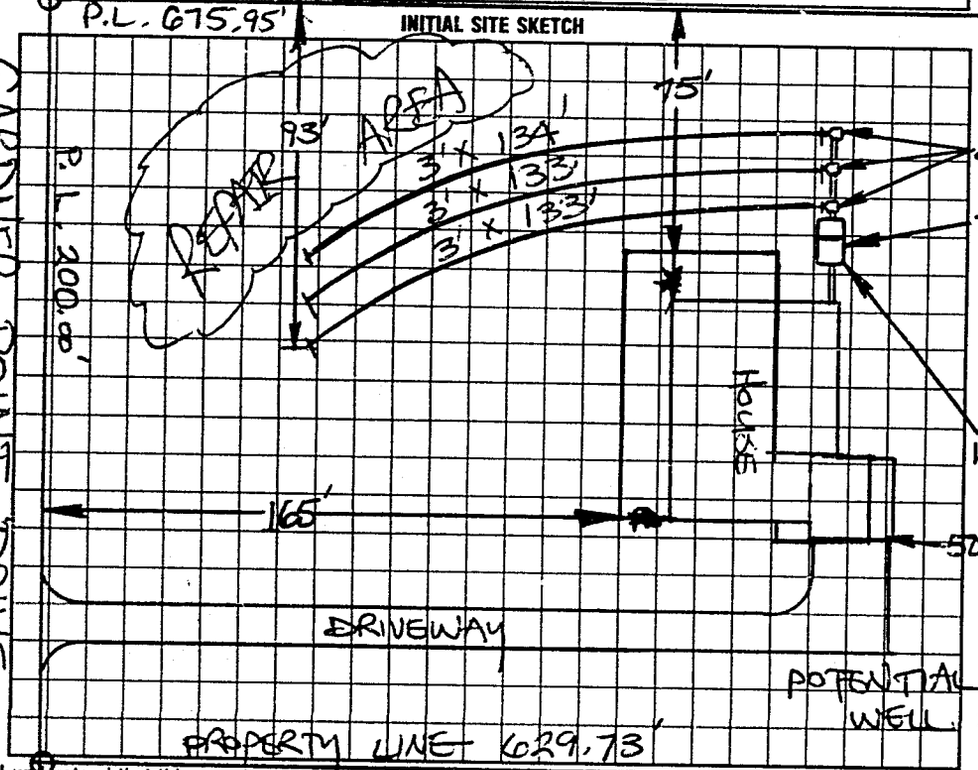

AS BUILT SKETCH

SYSTEM INSTALLED ACCORDING TO INITIAL SITE SKETCH

I understand that this permit can be suspended or revoked if any false information is supplied toward securing the permit/any unauthorized changes are made to the site/any unauthorized changes are made in the installation of the system. Improvement Permit with plat valid without expiration. Improvement Permit with site plan valid for sixty months. Authorization to Construct is valid for a period equal to that of Improvement Permit – not to exceed sixty months.

Signed: _____ date 5-13-98 Installed by: JAMES HUDLER

Improvement Permit by: STEVE HEDRICK date 5-9-98 Operation Permit by: STEVE HEDRICK date 11-16-98

Authorization to Construct by: STEVE HEDRICK date 5-9-98 Existing System Inspection by: _____ date _____

HEALTH DEPT. COPY: WHITE INSPECTION COPY (FINAL): GREEN OWNER COPY (FINAL): YELLOW INSPECTION COPY (INITIAL): PINK OWNER COPY (INITIAL): GOLD