IREDELL COUNTY HEALTH DEPARTMENT

STATESVILLE 704-878-5305 MOORESVILLE 704-664-5281

IMPROVEMENT PERMIT / AUTHORIZATION TO CONSTRUCT / OPERATION PERMIT / EXISTING SYSTEM INSPECTION

PERMIT# 132103 PIN# 3774877573 DATE 10/27/05

OWNER OR CONTRACTOR Jamie Workman PHONE: Business 704 655 9543 Home 704 622 3996

ADDRESS 198 Fulbright Rd

LOCATION I-40 West to Sharon School Rd (R) to Stewart Rock Rd (L) to Fulbright Lot on (R)

SUBDIVISION Patriots Point BLOCK / SECTION ____ LOT #1 LOT AREA .644 Acre SITE CLASS PS DESIGN FLOW 360 L.T.A.R. .3

Septic Tank: 1000 Gallons; STB 1012 Date ~~10/27/05~~ 4-25-05

Pump Tank: ____ Gallons; PT ____ Date ____

Pump Make: ____ Model ____ Serial No. ____

Nitrification Field: No Fields 1 Square Feet 1200 Linear Feet 300

No Lines 4 Trench Width 3 Max Trench Bottom Depth 36 Gravel Depth N/A

☒ New System ☐ Repair System Type: I, (II), III, IV, V, VI

System Description: 25% Reduction - Gravity

Repair System Description: 25% Reduction - Gravity

Maintenance Agreement Required: ☐ Yes ☐ No

☒ House/Mod. Home No. Bedrooms 3

☐ Mobile Home No. Bathrooms 3

☐ Business No. Employees ____


☐ Other ____

☐ Slab ☒ Crawl Space ☐ Basement w/plumbing ☐ Basement wo/plumbing

Water Supply: ☒ Individual ☐ Public ☐ Community

Comments:/Conditions:

INITIAL SITE SKETCH

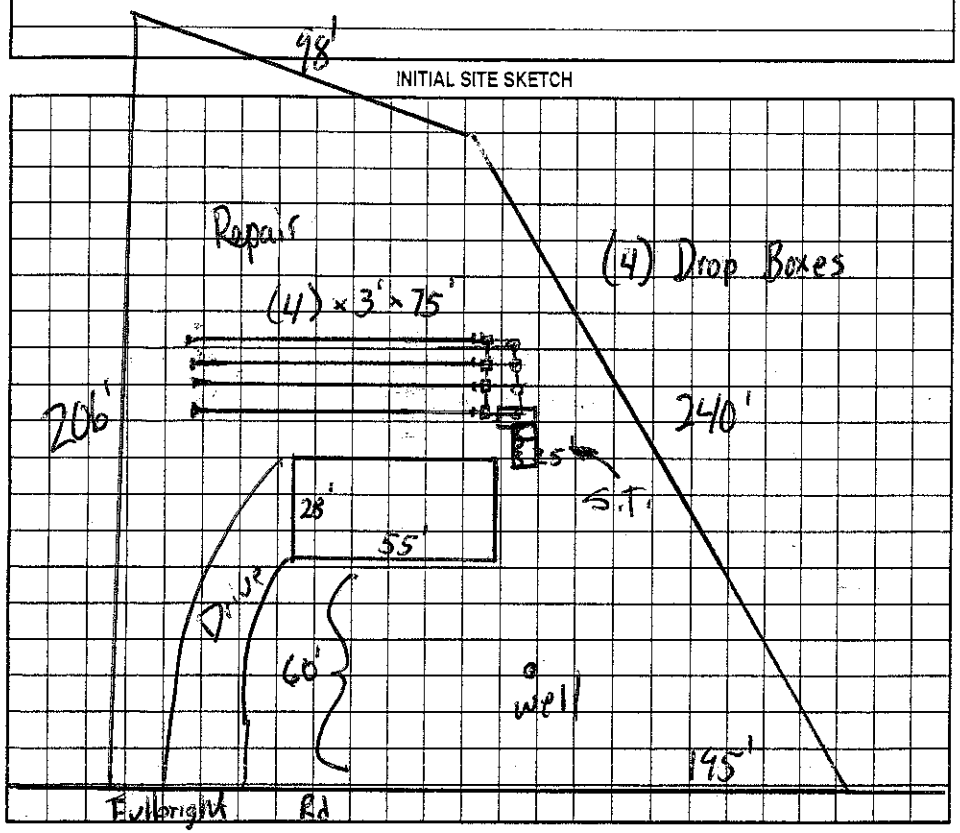

Comments:/Conditions: © SYSTEM INSTALLED ACCORDING TO INITIAL SITE SKETCH USING 75 "QUICK 4" CHAMBERS, © SEPTIC TANK WITH MARKER INSTALLED USING "INFITE" FILTER

AS BUILT SKETCH

AS SHOWN

Permit can be suspended or revoked if any false information is supplied toward securing the permit/any unauthorized changes are made to the site/any unauthorized changes are made in the installation of the system. Improvement Permit with plat valid without expiration. Improvement Permit with site plan valid for sixty months. Authorization to Construct is valid for a period equal to that of Improvement Permit – not to exceed sixty months.

Signed: ____ date 10/31/5 Installed by: A-1 BACKHOE

Improvement Permit by: James Allen date 10-27-05 Operation Permit by: STEVE HEDRICK date 11-4-05

Authorization to Construct by: James Allen date 10-27-05 Existing System Inspection by: ____ date ____

HEALTH DEPT. COPY: WHITE OWNER COPY (FINAL): YELLOW OWNER COPY (INITIAL): PINK