IREDELL COUNTY HEALTH DEPARTMENT Cust. Auth. STATESVILLE 704-878-5305 MOORESVILLE 704-664-5281

IMPROVEMENT PERMIT / ~~CERTIFICATE OF COMPLETION~~ / OPERATION PERMIT / EXISTING SYSTEM INSPECTION

PROPERTY DESCRIPTION NO. 067701 DATE Sept. 25, '97 TAX MAP NO. 3774749738 Watershed: ☑ Yes ☐ No

OWNER OR CONTRACTOR K.E.I. Marketing PHONE: Business _____ Home _____

ADDRESS PO Box 1627, Matthews 28106

LOCATION I-40 Simpson Sch Rd N. TL Stewart Rock TL Fulbright 2nd lot on Right

SUBDIVISION Riverwalk BLOCK / SECTION 9 LOT 7 LOT AREA 4.03Ac SITE CLASS. RS DESIGN FLOW 360gpd L.T.A.R. ~.3

Septic Tank: 1000 Gallons; STB 750 Date 9/2/99
Pump Tank: _____ Gallons; PT _____ Date _____
Pump Make: _____ Model _____ Serial No. _____
Nitrification Field: No Fields 1 Square Feet 1200 Linear Feet 400
No Lines 3@133' Trench Width 36" Max Trench Bottom Depth 36"

☑ New System ☐ Repair System Type: I, II, III, IV, V, VI
System Description: gravity conventional
Repair System Description: same
Maintenance Agreement Required: ☐ Yes ☑ No
Gravel Depth 12" ☐ Slab ☑ Crawl Space ☐ Basement w/plumbing ☐ Basement wo/plumbing


☑ House/Mod. Home No. Bedrooms 3
☐ Mobile Home No. Bathrooms 2
☐ Business No. Employees _____
☐ Other _____

Water Supply: ☑ Individual ☐ Community ☐ Public

Comments:

Comments:

INITIAL SITE SKETCH

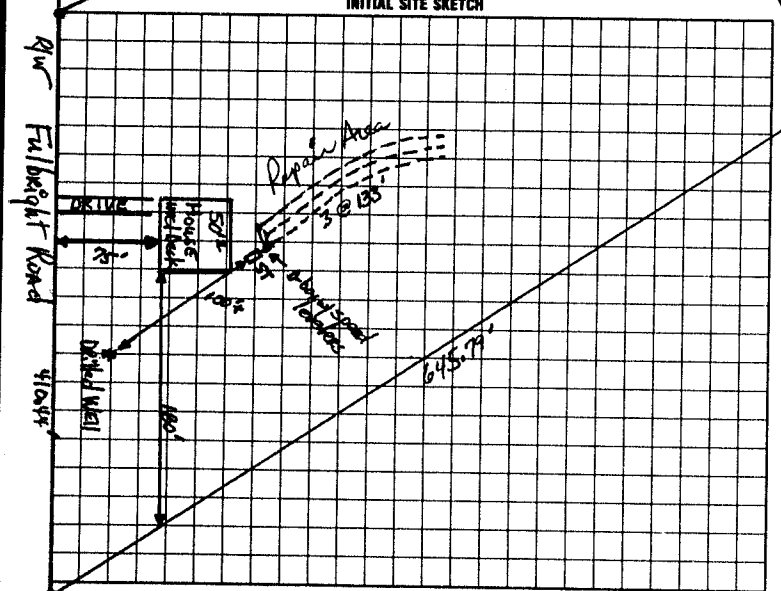

1" = 100'

AS BUILT SKETCH

I understand that this permit can be suspended or revoked if any false information is supplied toward securing the permit/any unauthorized changes are made to the site/any unauthorized changes are made in the installation of the system. Improvement Permit is valid for 60 months from date of issuance.

Signed: Owner/Agent

Improvement Permit by: [signature] date 9-25-97

Construction ~~System Inspection~~ Authorization by: [signature] date 9-14-99

Installed by: Larry Keep

Certificate of Completion by: [signature] date 2-25-00

Operation Permit by: _____ date _____

HEALTH DEPT. COPY: WHITE INSPECTION COPY (FINAL): GREEN OWNER COPY (FINAL): YELLOW INSPECTION COPY (INITIAL): PINK OWNER COPY (INITIAL): GOLD