IREDELL COUNTY HEALTH DEPARTMENT

STATESVILLE 704-878-5305 MOORESVILLE 704-664-5281

IMPROVEMENT PERMIT / ~~CERTIFICATE OF COMPLETION~~ / OPERATION PERMIT / EXISTING SYSTEM INSPECTION

Const Auth

PROPERTY DESCRIPTION NO. 960526 DATE Oct 3, 97 TAX MAP NO. 3774889494 Watershed: ☒ Yes ☐ No

OWNER OR CONTRACTOR Shaw Southerman PHONE Business _____ Home _____

ADDRESS PO Box 1981 Hickory

LOCATION I40 Statesville Blvd W. TL Stewart Rockdale TL Fulbright on left #163 Fulbright Road

SUBDIVISION Riverwalk BLOCK / SECTION 9 LOT 2 LOT AREA 5Ac SITE CLASS. B5 DESIGN FLOW 360gpd L.T.A.R. 3

Septic Tank: 1500 Gallons; STB 821 Date 2-7-98

Pump Tank: _____ Gallons; PT _____ Date _____

Pump Make: _____ Model _____ Serial No. _____

Nitrification Field: No Fields 1 Square Feet 700 Linear Feet 400

No Lines 3@133' Trench Width 36" Max Trench Bottom Depth 24" Gravel Depth 12"

☒ New System ☐ Repair System Type: I, ☒ II, III, IV, V, VI

System Description: Gravity Conventional

Repair System Description: None

Maintenance Agreement Required: ☐ Yes ☒ No

☐ House/Mod. Home No. Bedrooms 3

☐ Mobile Home No. Bathrooms 3

☐ Business No. Employees _____

☐ Other _____


☐ Slab ☐ Crawl Space ☒ Basement w/plumbing ☐ Basement wo/plumbing

Water Supply: ☒ Individual ☐ Community ☐ Public


Comments:

Comments:
*Note Tank sits 40ft from House

INITIAL SITE SKETCH 1" x 100'

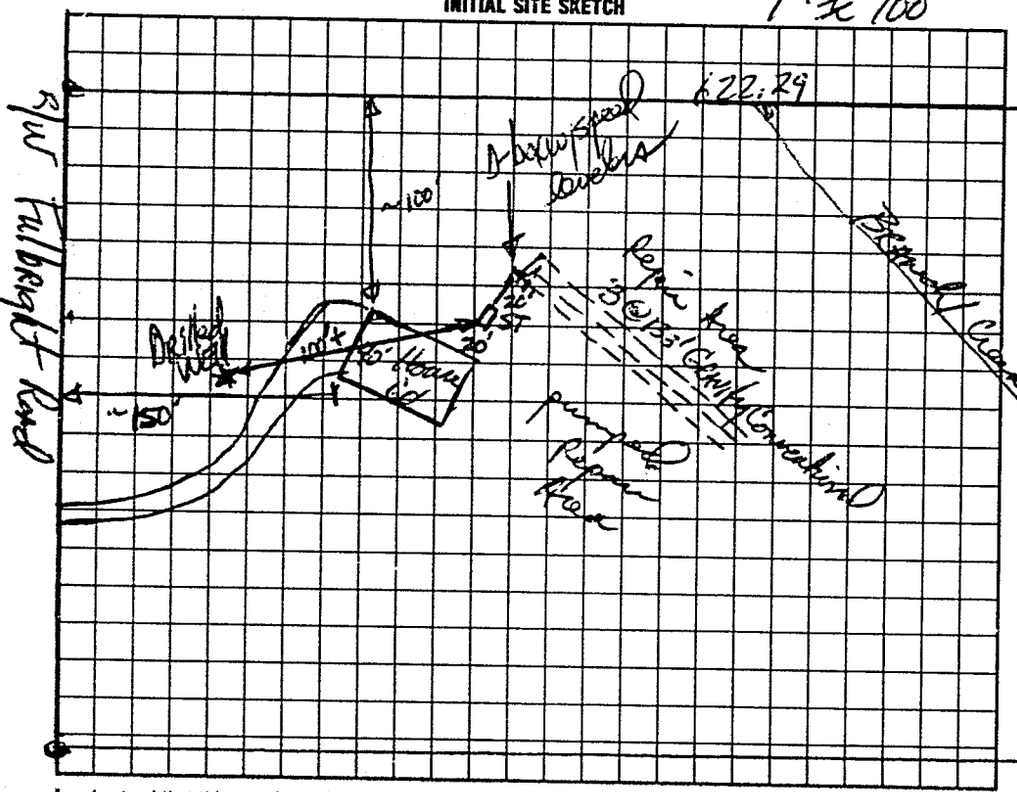

AS BUILT SKETCH

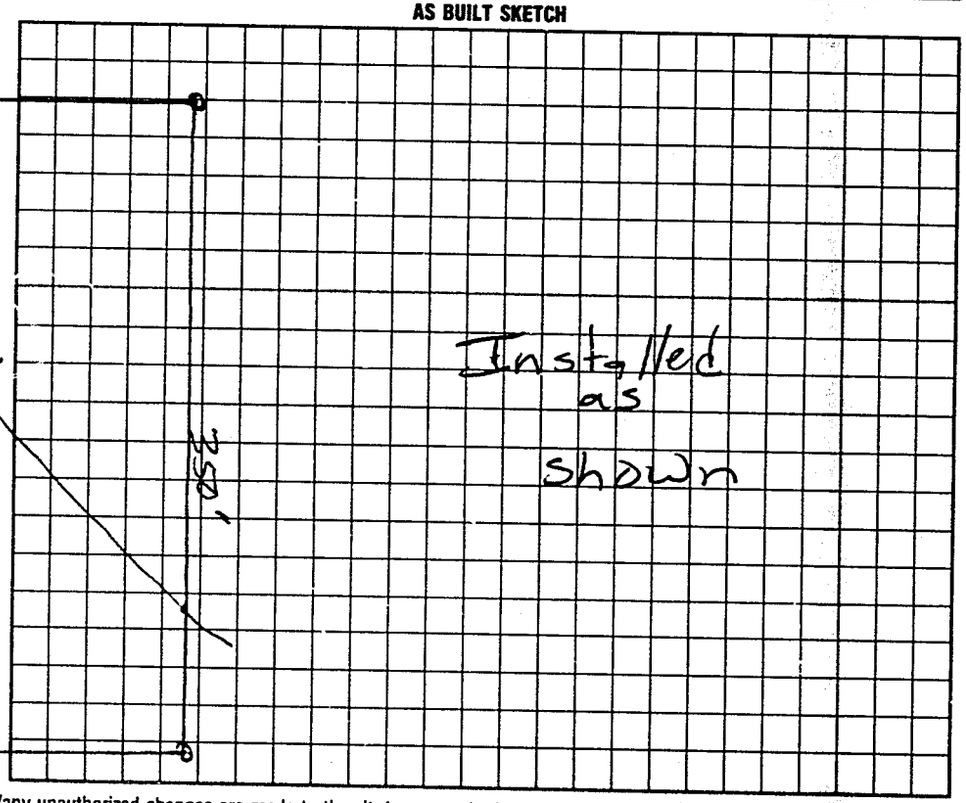

I understand that this permit can be suspended or revoked if any false information is supplied toward securing the permit/any unauthorized changes are made to the site/any unauthorized changes are made in the installation of the system. Improvement Permit is valid for 60 months from date of issuance.

Signed: _____

Improvement Permit by: _____ date 10-3-97

Existing System Inspection by: _____ date 10-3-97

Installed by: D+D Grading

Certificate of Completion by: _____ date _____

Operation Permit by: Mat C O, A HS date 3-26-98

HEALTH DEPT. COPY: WHITE INSPECTION COPY (FINAL): GREEN OWNER COPY (FINAL): YELLOW INSPECTION COPY (INITIAL): PINK OWNER COPY (INITIAL): GOLD

8 8 2 0 0