IREDELL COUNTY HEALTH DEPARTMENT

STATESVILLE 704-878-5305 MOORESVILLE 704-664-5281

IMPROVEMENT PERMIT / CERTIFICATE OF COMPLETION / OPERATION PERMIT / EXISTING SYSTEM INSPECTION

PROPERTY DESCRIPTION NO. 067707 DATE 10/1/97 TAX MAP NO. 3774749738 Watershed: ☒ Yes ☐ No

OWNER OR CONTRACTOR Johnny Mullinax PHONE: Business ______ Home (704) 882-2589

ADDRESS 7309 Quarter House Ln Matthews, NC 28105

LOCATION Sharon School Rd TR Stewart Rock TL Fulbright at corner

SUBDIVISION Riverwalk BLOCK / SECTION 9 LOT 8 LOT AREA 5 Acre SITE CLASS. PS DESIGN FLOW 360gpd L.T.A.R. .3+

Septic Tank: 1000 Gallons; STB 1012 Date 3-6-98

Pump Tank: ______ Gallons; PT ______ Date ______

Pump Make: ______ Model ______ Serial No. ______

Nitrification Field: No Fields 1 Square Feet 1200' Linear Feet 400'

No Lines 4 at 100' Trench Width 36" Max Trench Bottom Depth 30" Gravel Depth 12"

☒ New System ☐ Repair System Type: I (II) III, IV, V, VI

System Description: Grav. Conventional

Repair System Description: Grav Conventional

Maintenance Agreement Required: ☐ Yes ☒ No

☒ House/Mod. Home No. Bedrooms 3

☐ Mobile Home No. Bathrooms 2

☐ Business No. Employees ______

☐ Other ______


☐ Slab ☒ Crawl Space ☐ Basement w/plumbing ☐ Basement wo/plumbing

Water Supply: ☒ Individual ☐ Community ☐ Public


Comments: Well Should be Drilled well.

Comments:

Scale 1:100 **INITIAL SITE SKETCH**

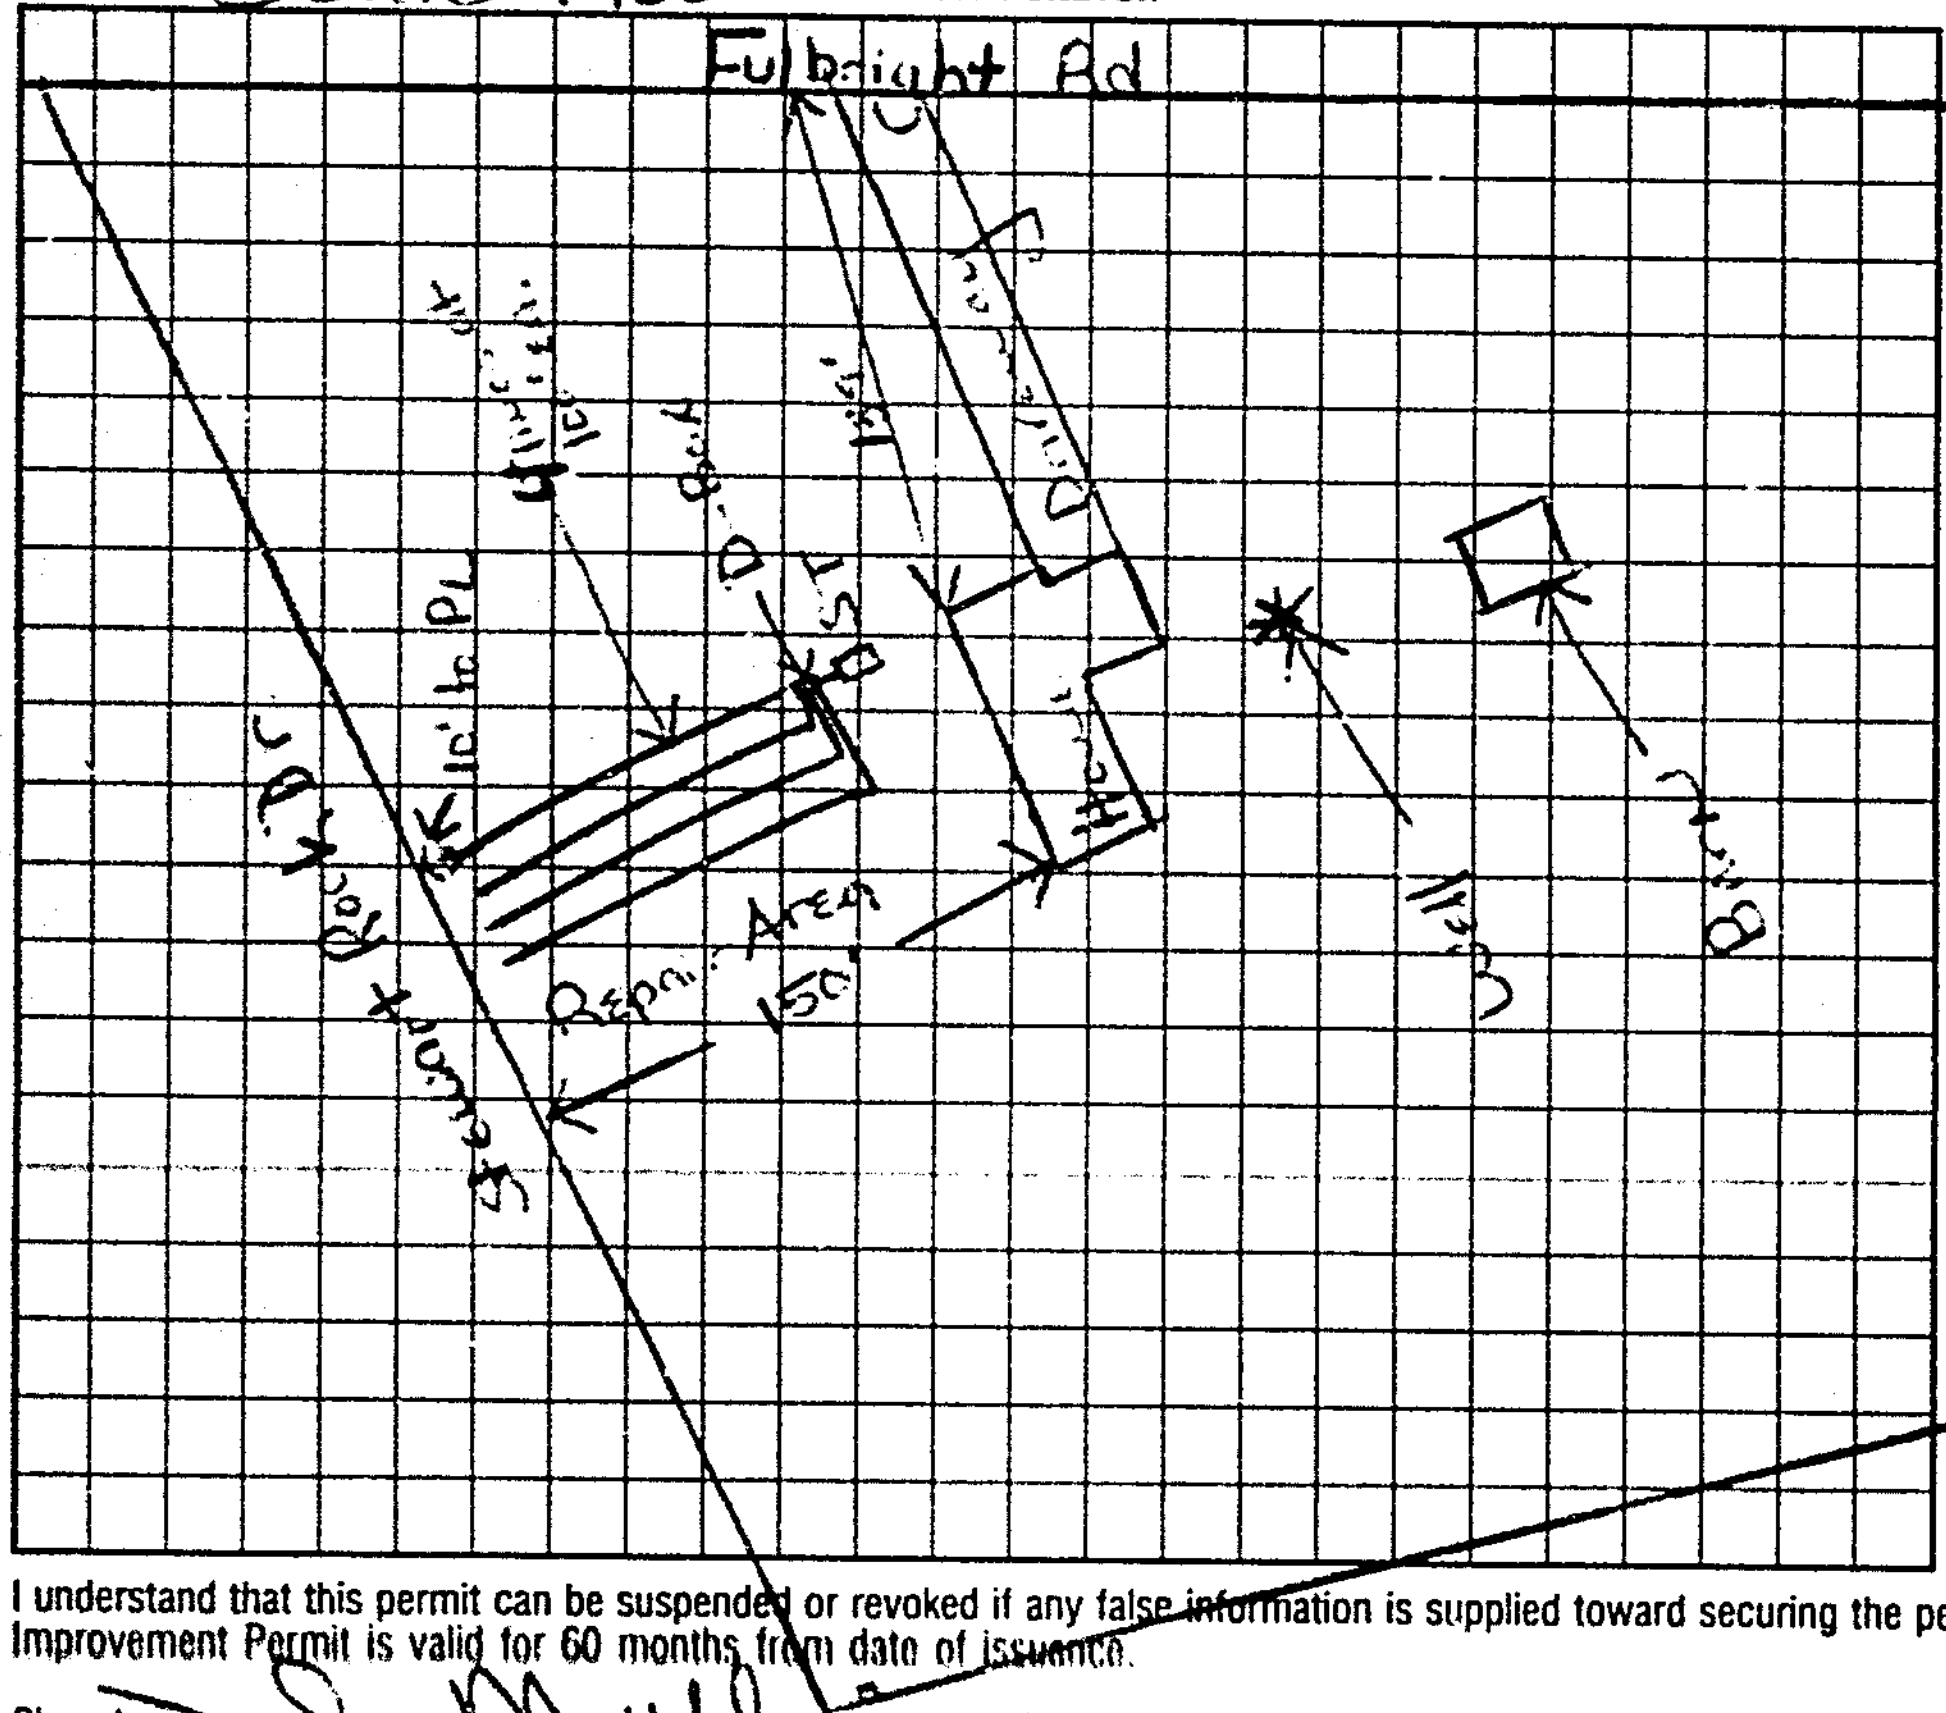

AS BUILT SKETCH

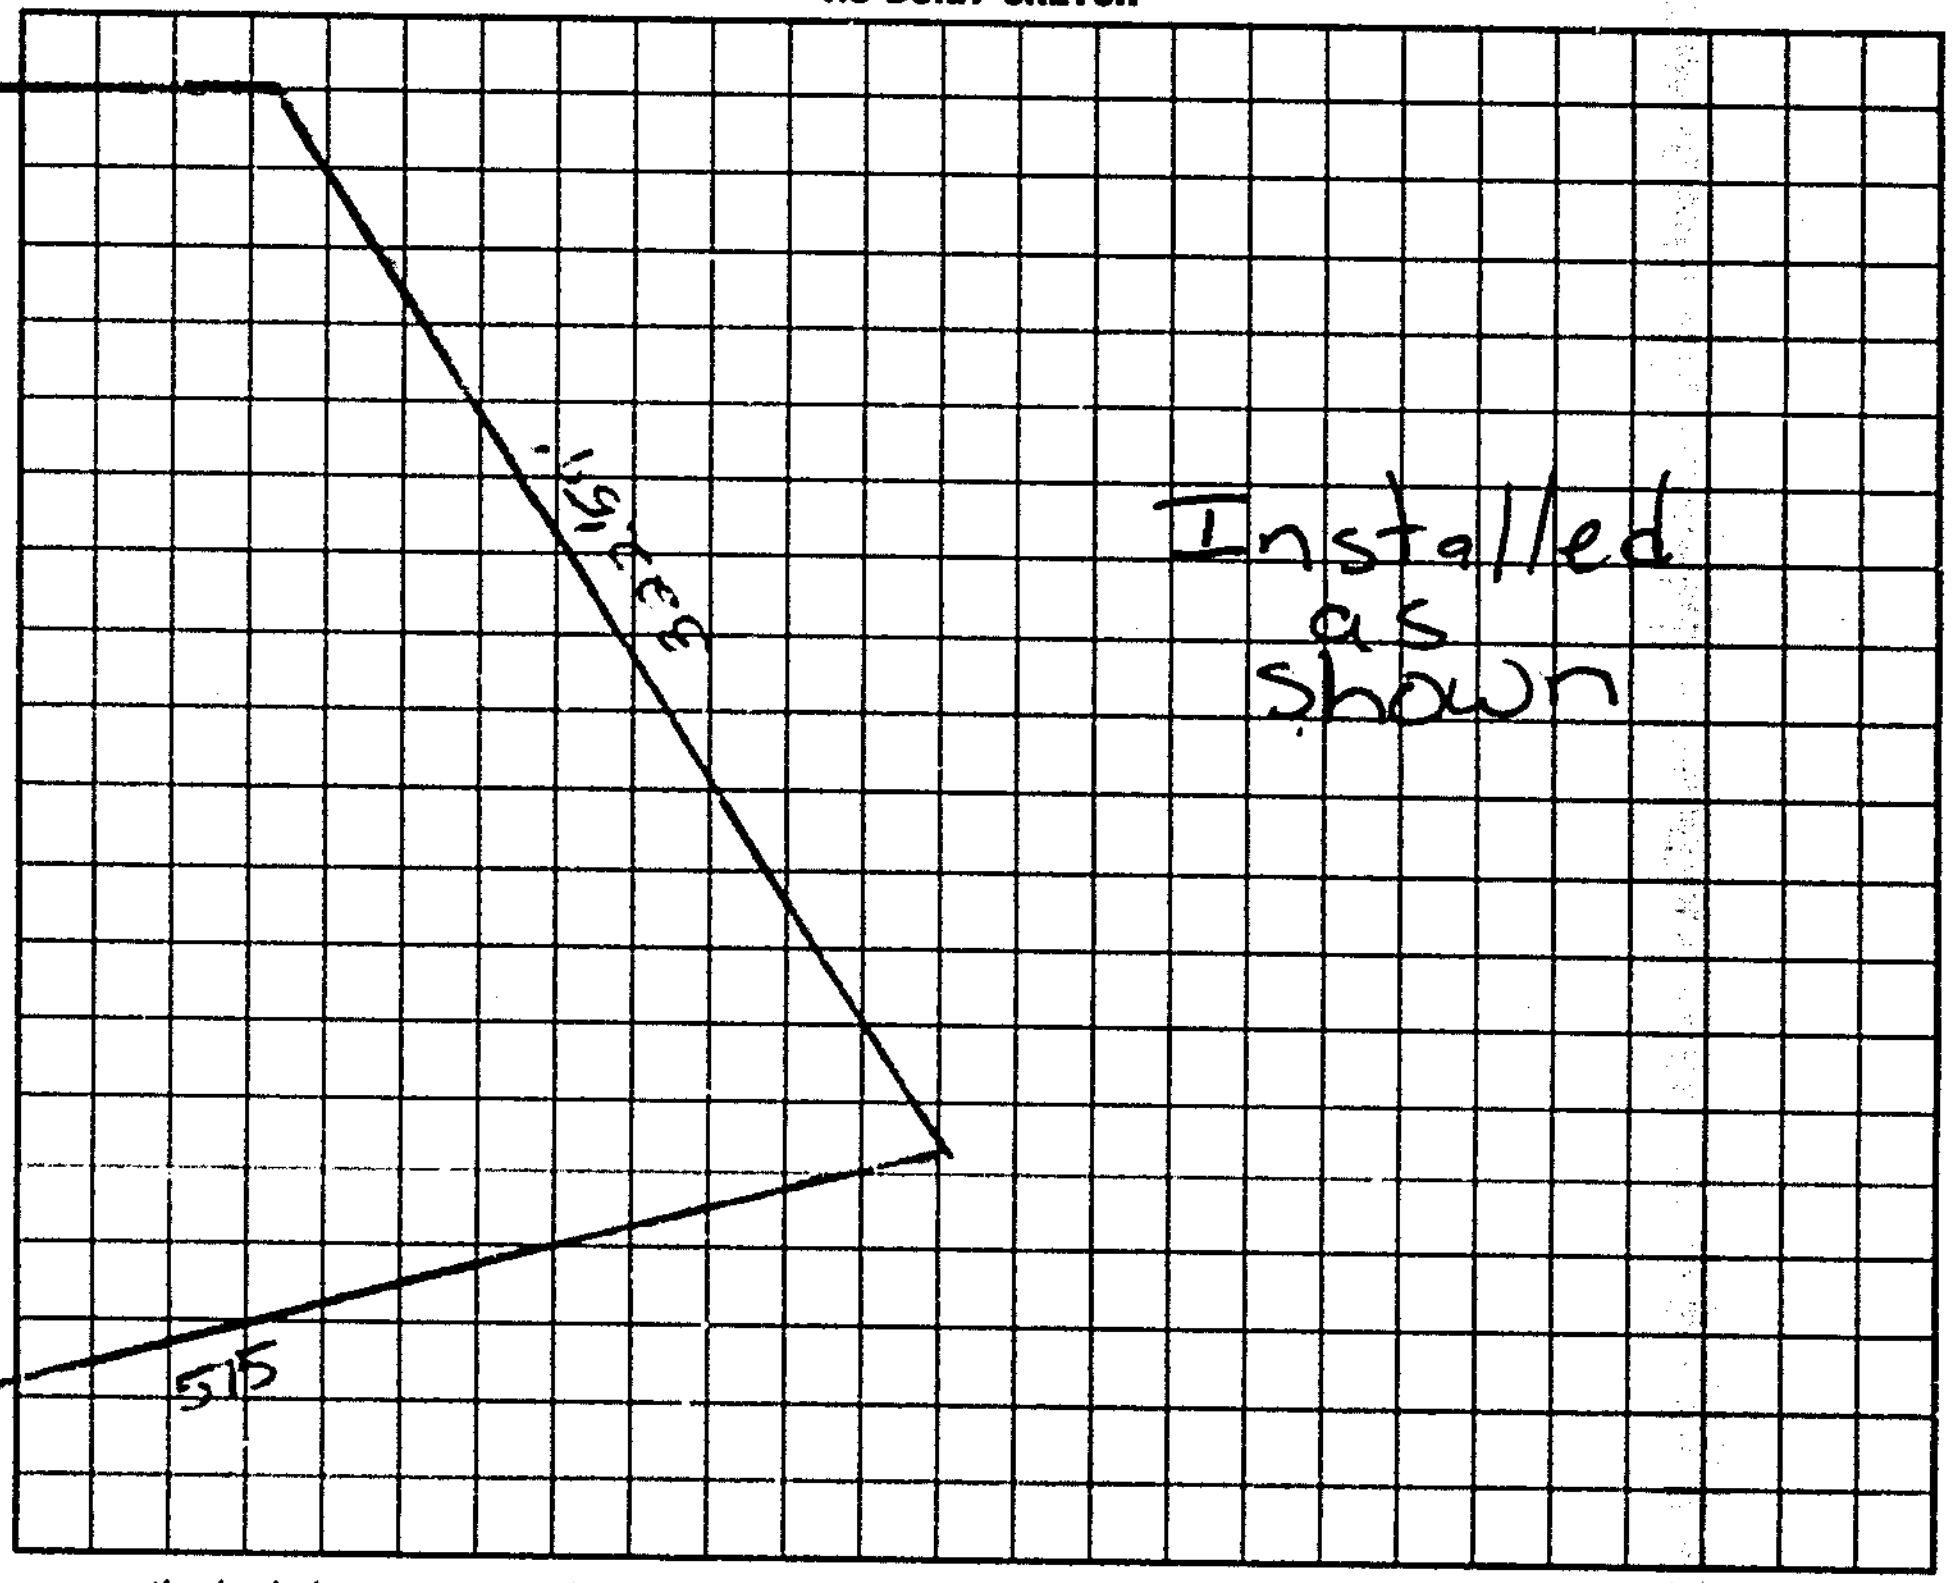

I understand that this permit can be suspended or revoked if any false information is supplied toward securing the permit/any unauthorized changes are made to the site/any unauthorized changes are made in the installation of the system. Improvement Permit is valid for 60 months from date of issuance.

Signed: J. Mullinax

Improvement Permit by: [signature] date 10/1/97

~~Existing System Inspection by:~~ [signature] date 10/1/97

Auth. to Construct

Installed by: Esker Elder

Certificate of Completion by: ______ date ______

Operation Permit by: [signature] RS date 5-11-98

HEALTH DEPT. COPY: WHITE INSPECTION COPY (FINAL): GREEN OWNER COPY (FINAL): YELLOW INSPECTION COPY (INITIAL): PINK OWNER COPY (INITIAL): GOLD

078700