IREDELL COUNTY HEALTH DEPARTMENT

THIS PERMIT VOIDS PREVIOUS ISSUED 3-20-200

STATESVILLE 704-878-5305 MOORESVILLE 704-664-5281

IMPROVEMENT PERMIT / AUTHORIZATION TO CONSTRUCT / OPERATION PERMIT / EXISTING SYSTEM INSPECTION

PERMIT# 88828 PIN# 3R-A-1 (P1) 3774-92-1004 DATE 11-8-00

OWNER OR CONTRACTOR RANDAL & SUE HINSON PHONE: Business 566-5007 Home 643-0065

ADDRESS 4602 E COLONY ROAD, CHARLOTTE, NC 28226

LOCATION SHARON SCH. RD, TL STEWART ROCK, TL FULBRIGHT, TR GARDNER POINT, TL AT END, 1ST LOT ON RIGHT

SUBDIVISION RIVERWALK BLOCK / SECTION VII LOT 5 LOT AREA 1.144 ACRE SITE CLASS. PS DESIGN FLOW 600 L.T.A.R. 0.30 GPD/FT²

Septic Tank: 1500 Gallons; STB 1011 Date 6-11-00

Pump Tank: 1500 Gallons; PT 99 Date 9-27-00

Pump Make: GOULDS Model EP0911A Serial No. 1000 5483

Nitrification Field: No Fields 1 Square Feet 60 to 2000 Linear Feet 340

No Lines FIVE Trench Width 24" Max Trench Bottom Depth 36" ~~Gravel~~ Depth SAND 6½

☑ New System ☐ Repair System Type: I, II, III, IV, V, VI

System Description: LOW-PRESSURE PPBPS PANELS

Repair System Description: LOW-PRESS. PPBPS PANELS

Maintenance Agreement Required: ☑ Yes ☐ No

☑ House/Mod. Home No. Bedrooms 5

☐ Mobile Home No. Bathrooms 3½

☐ Business No. Employees

☐ Other


☐ Slab ☐ Crawl Space ☑ Basement w/plumbing ☐ Basement wo/plumbing

Water Supply: ☑ Individual ☐ Public ☐ Community


Comments:/Conditions: ① INSTALL 50% REDUCTION SYSTEM USING EIGHTY (80) PPBPS PANELS USING LOW-PRESSURE DISTRIBUTION ② SEE ATTACHED SHEETS FOR PUMP & LOW-PRESSURE DIST. REQUIREMENTS (.1956 (3)(a)(ii)(D)

Comments:/Conditions: SEPTIC TANK W/ RISERS INSTALLED USING "PolyLok" FILTER - SYSTEM CHANGED TO SIX DRAINLINES AS SHOWN DUE TO FILL DIRT AT END

INITIAL SITE SKETCH

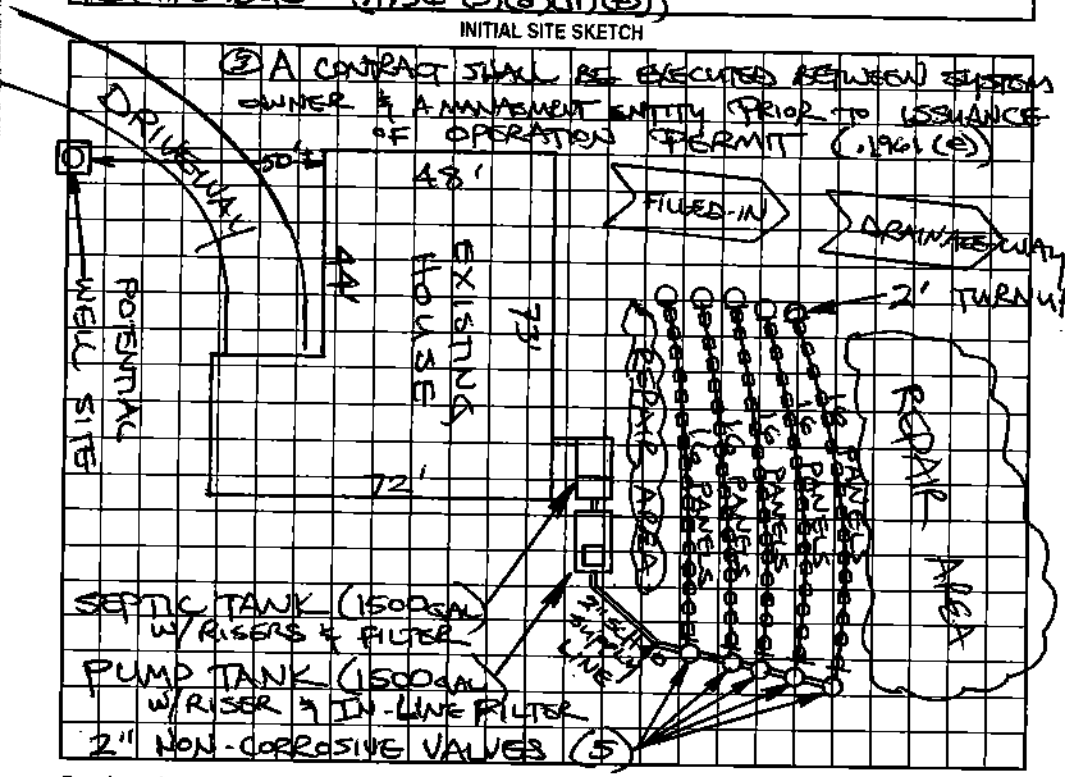

AS BUILT SKETCH

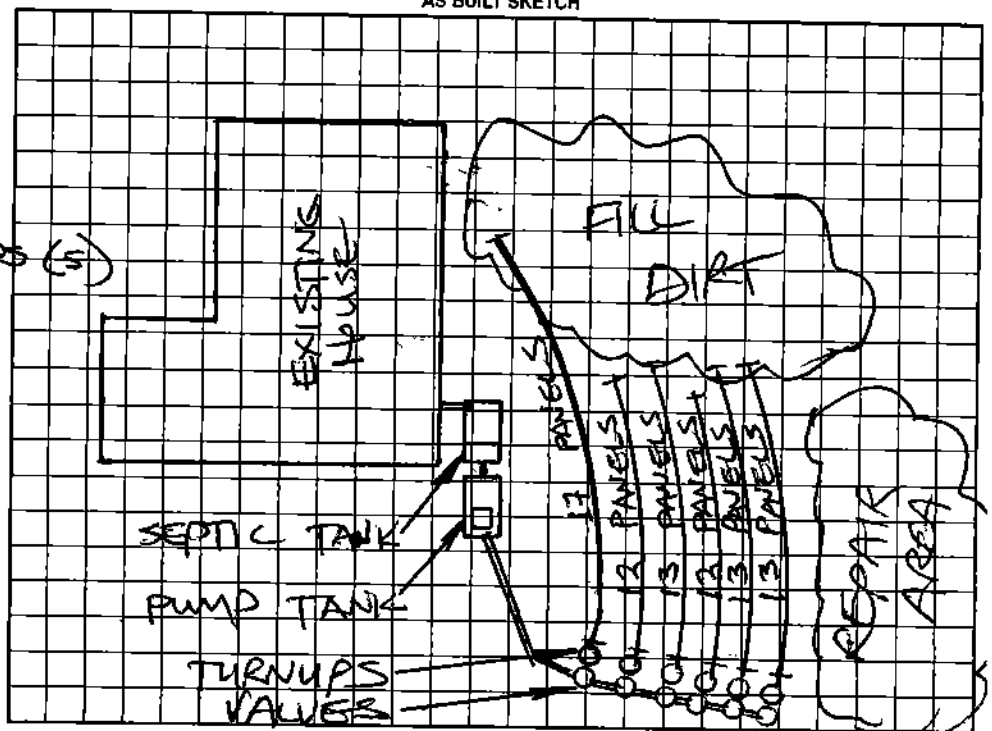

Permit can be suspended or revoked if any false information is supplied toward securing the permit/any unauthorized changes are made to the site/any unauthorized changes are made in the installation of the system. Improvement Permit with plat valid without expiration. Improvement Permit with site plan valid for sixty months. Authorization to Construct is valid for a period equal to that of Improvement Permit – not to exceed sixty months.

Signed: Randal J Hinson date 11-9-00

Improvement Permit by: STEVE HEDRICK date 11-8-00

Authorization to Construct by: STEVE HEDRICK date 11-8-00

Installed by: TOMMY COTHREN

Operation Permit by: STEVE HEDRICK date 2-14-01

Existing System Inspection by: date

HEALTH DEPT. COPY: WHITE OWNER COPY (FINAL): YELLOW OWNER COPY (INITIAL): PINK