THIS PERMIT VOIDS PREVIOUS ISSUED 12-14-96

IREDELL COUNTY HEALTH DEPARTMENT

STATESVILLE 704-878-5305 MOORESVILLE 704-664-5281

IMPROVEMENT PERMIT / AUTHORIZATION TO CONSTRUCT / OPERATION PERMIT / EXISTING SYSTEM INSPECTION

PERMIT# 25602 95708 PIN# 3774 92 5257 DATE 12-14-96

OWNER OR CONTRACTOR JAMES MICKEY LEIGH PHONE: Business (828) 874-4168 Home

ADDRESS C/O SUNBELT HOMES, 230 SIGNAL HILL DR STATESVILLE NC 28625

LOCATION GARDNER POINT DR, FD LOT ON LEFT PAST RIDGE POINT DRIVE

SUBDIVISION RIVERWALK BLOCK / SECTION VII LOT 9 LOT AREA 1.095 ACRES SITE CLASS PS DESIGN FLOW 360 L.T.A.R. 0.30 GPD/FT²

Septic Tank: 1000 Gallons: STB 1012 Date 7-3-01
Pump Tank: Gallons: PT Date
Pump Make: Model: Serial No
Nitrification Field: No Fields 1 Square Feet EQ. IN 1200 Linear Feet 200+
No Lines SIX Trench Width 24" Max Trench Bottom Depth 36"

✓ New System Repair System Type: I II (III) IV V VI
System Description: 50% REDUCTION GRAVITY
Repair System Description: 50% REDUCTION
Maintenance Agreement Required: Yes ✓ No
~~Gravel~~ Depth STAND 6" Slab ✓ Crawl Space Basement w/plumbing Basement wo/plumbing


✓ House/Mod. Home No. Bedrooms 3
Mobile Home No. Bathrooms 2
Business No. Employees
Other

Water Supply: ✓ Individual Public Community
WELL


Comments/Conditions: INSTALL 50% REDUCTION SYSTEM USING 48 PPBPS PANELS IN SIX EQUAL LENGTH LINES ON CONTOUR & KEEP SYSTEM MINIMUM 100 FEET FROM WELL

Comments/Conditions: SEPTIC TANK WITH RISERS INSTALLED USING "POLYLOK" FILTER

INITIAL SITE SKETCH

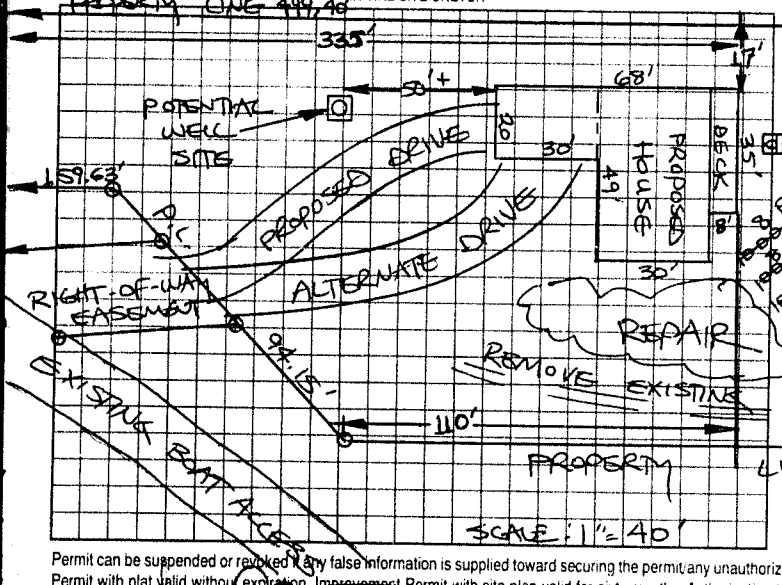

AS BUILT SKETCH

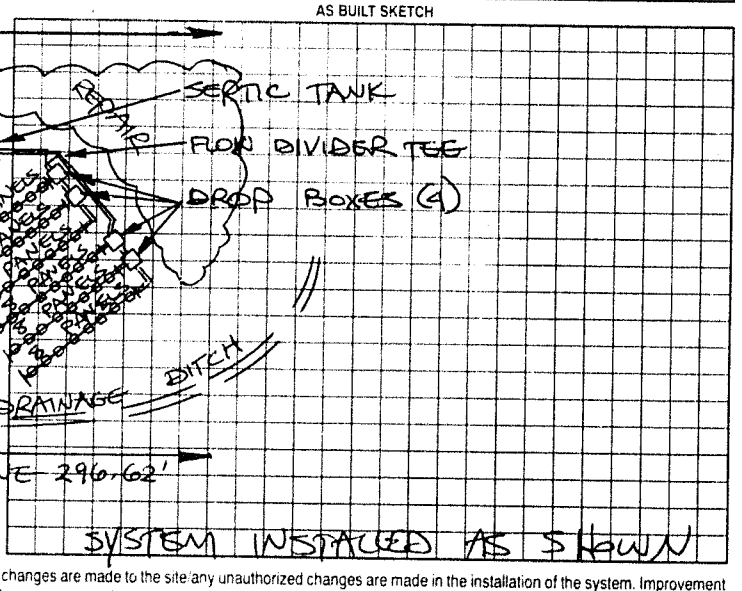

Permit can be suspended or revoked if any false information is supplied toward securing the permit, any unauthorized changes are made to the site, any unauthorized changes are made in the installation of the system. Improvement Permit with plat valid without expiration. Improvement Permit with site plan valid for sixty months. Authorization to Construct is valid for a period equal to that of Improvement Permit – not to exceed sixty months.

Signed: date

Improvement Permit by: STEVE HEDRICK date 2-20-01

Authorization to Construct by: STEVE HEDRICK date 2-20-01

Installed by: DAVID YOUNTZ

Operation Permit by: STEVE HEDRICK date 10-4-01

Existing System Inspection by: date

HEALTH DEPT COPY WHITE OWNER COPY (FINAL) YELLOW OWNER COPY (INITIAL) PINK