Voids All Previous Permits Issued 12-96 to 10-97

IREDELL COUNTY HEALTH DEPARTMENT

STATESVILLE 704-878-5305 MOORESVILLE 704-664-5281

IMPROVEMENT PERMIT / AUTHORIZATION TO CONSTRUCT / OPERATION PERMIT / EXISTING SYSTEM INSPECTION

PERMIT# 25603/87/79 PIN# 8R-A-1 DATE Dec 23 99

OWNER OR CONTRACTOR David SAKALUK PHONE: Business _____ Home 947-0929

ADDRESS 5631 HARTfield Downs Dr Charlotte NC

LOCATION I40W (R) Sharon Schl Rd (L) Stoney Rock (L) Fulbright (R) Gardner Point on left beside Boat ~~Dock~~ Ramp entrance

SUBDIVISION Riverwalk BLOCK / SECTION VII LOT 10 LOT AREA 1.35Ac SITE CLASS P5 DESIGN FLOW 360 L.T.A.R. .3

Septic Tank: 1000 Gallons; STB 160 Date _____

Pump Tank: 1000 Gallons; PT 179 Date 4.21 00

Pump Make: Goulds Model WE0511H Serial No C000651114

Nitrification Field: No Fields 1 Square Feet 1200 Linear Feet 300

No Lines 4 Trench Width 36" Max Trench Bottom Depth 36" Gravel Depth N/A

☒ New System ☐ Repair System Type: I. II. (III) IV. V. VI

System Description: Pump 25% Reduct.

Repair System Description: Same 50% reduct.

Maintenance Agreement Required: ☐ Yes ☒ No

☒ House/Mod. Home ☐ Mobile Home ☐ Business ☐ Other

No. Bedrooms 3 No. Bathrooms 2 No. Employees ____


☐ Slab ☐ Crawl Space ☒ Basement w/plumbing ☐ Basement wo/plumbing

Water Supply: ☒ Individual ☐ Public ☐ Community Well


Comments/Conditions: Install on contour
Recommend HDS sections (30 sections) due to contour
Locate well 100ft from septic system
See Attached sheets for pump & pressure manifold

Comments/Conditions. Tuf Tite filter used -
HDS Section 300ft total - Pump & Septic tank installed 6/1.00

INITIAL SITE SKETCH

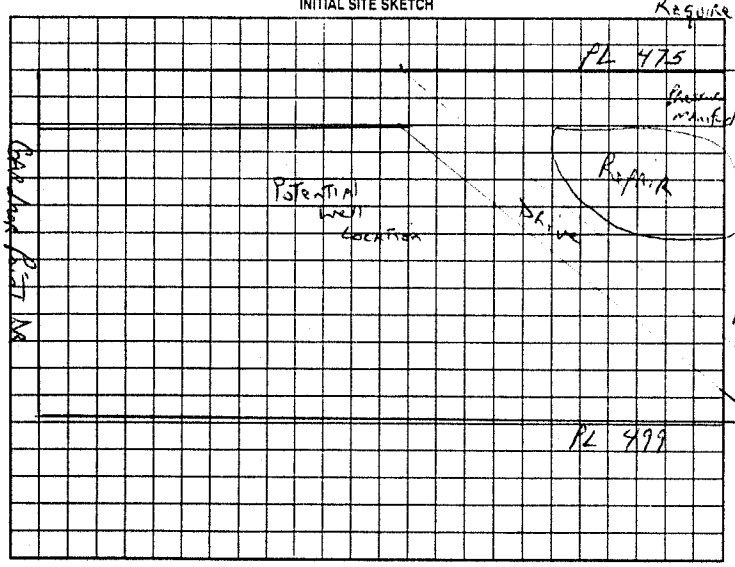

AS BUILT SKETCH

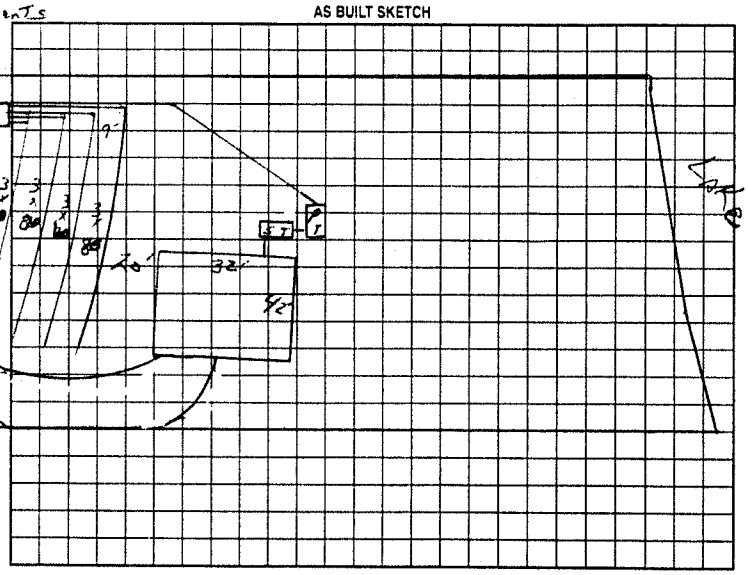

Permit can be suspended or revoked if any false information is supplied toward securing the permit/any unauthorized changes are made to the site/any unauthorized changes are made in the installation of the system. Improvement Permit with plat valid without expiration. Improvement Permit with site plan valid for sixty months. Authorization to Construct is valid for a period equal to that of Improvement Permit – not to exceed sixty months.

Signed: David Sakaluk date Dec 28 99

Improvement Permit by: Jc Potter date Dec 23 99

Authorization to Construct by: Jc Potter date Dec 23 99

Installed by: Shane Jarrett Grading

Operation Permit by: [signature] EST date 9/5/00

Existing System Inspection by: _____ date _____

HEALTH DEPT. COPY: WHITE OWNER COPY (FINAL): YELLOW OWNER COPY (INITIAL): PINK