Donald Johnson 202411

IREDELL COUNTY HEALTH DEPARTMENT

Statesville Office (704) 878-5305 Mooresville Office (704) 660-3625 PERMIT # 201961

IMPROVEMENT PERMIT / AUTHORIZATION TO CONSTRUCT / OPERATION PERMIT / EXISTING SYSTEM

PIN # 3774926327

APPLICANT: Donald Johnson APPLICANT ADDRESS: 2803 Herman Dr.

SITE ADDRESS: 403 Gardner Point Dr. Stoney Point NC 28678 PHONE: 704-896-6551 ALT. PHONE: N/A


SITE DIRECTIONS: I 40 to Sharon School Rd T/R the T/L on Stewart Rock T/L Fulbright T/R Gardner Point.

SUBDIVISION: Riverwalk SECTION: VII LOT # 10 LOT AREA: 1.35 ac DESIGN FLOW: 480 L.T.A.R.: .3

Septic Tank	EX 1000 (gal)	STB	760	Date	EX	☐ New System	☐ Repair	☒ Expansion	System Type: I II (III) IV V VI	☐ Residence	No. Bedrooms	4	Water Supply		
Pump Tank	EX 1000 (gal)	PT	14	Date	EX	System Description:	25% Reduction - Pump			☐ Business	No. Persons	8	☒ Private		
Pump Make	EX	Model	EX	Serial #	EX	Repair System Description:	Drip			☐ Other	No. Employees		☐ Public		
# Nitrification Fields	1	# Lines	1	Linear Ft:	80	Maintenance Agreement Required:	☐ YES	☒ NO		☐ Slab	☐ Crawl Space		☐ Community		
Trench Width	36"	Max. Trench Bottom Depth	36"	Gravel Depth	N/A		☐ GRAVITY	☒ PRESSURE		☒ Basement w/plumbing			☐ Basement w/o plumbing		

Comments / Conditions: Install 25% Reduction on contour with pressure manifold. If full from existing pressure manifold can be achieved tap with 1" in sch 40 tap.

INITIAL SITE SKETCH

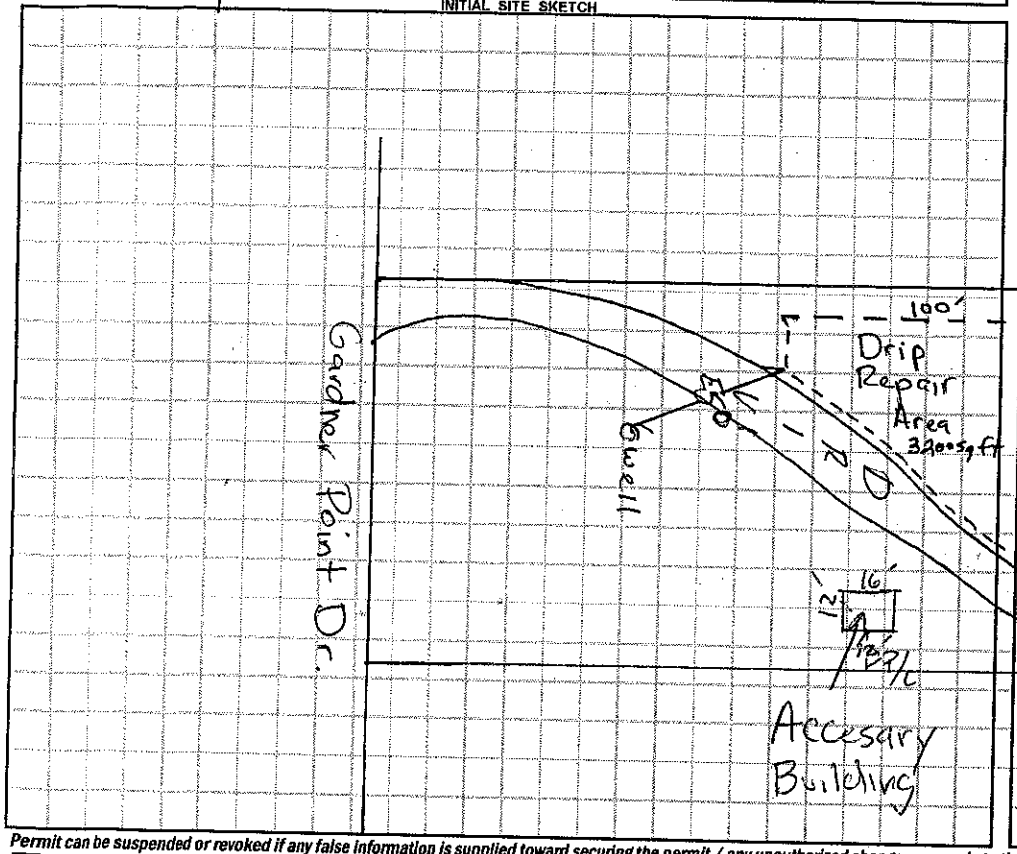


AS BUILT SKETCH

Location of the proposed 12'x16' addition does not appear to impact the existing on-site septic system or well.**NOTE:

David H Lee REHS Date: 04/16/14

ICHD-Environmental Health Division

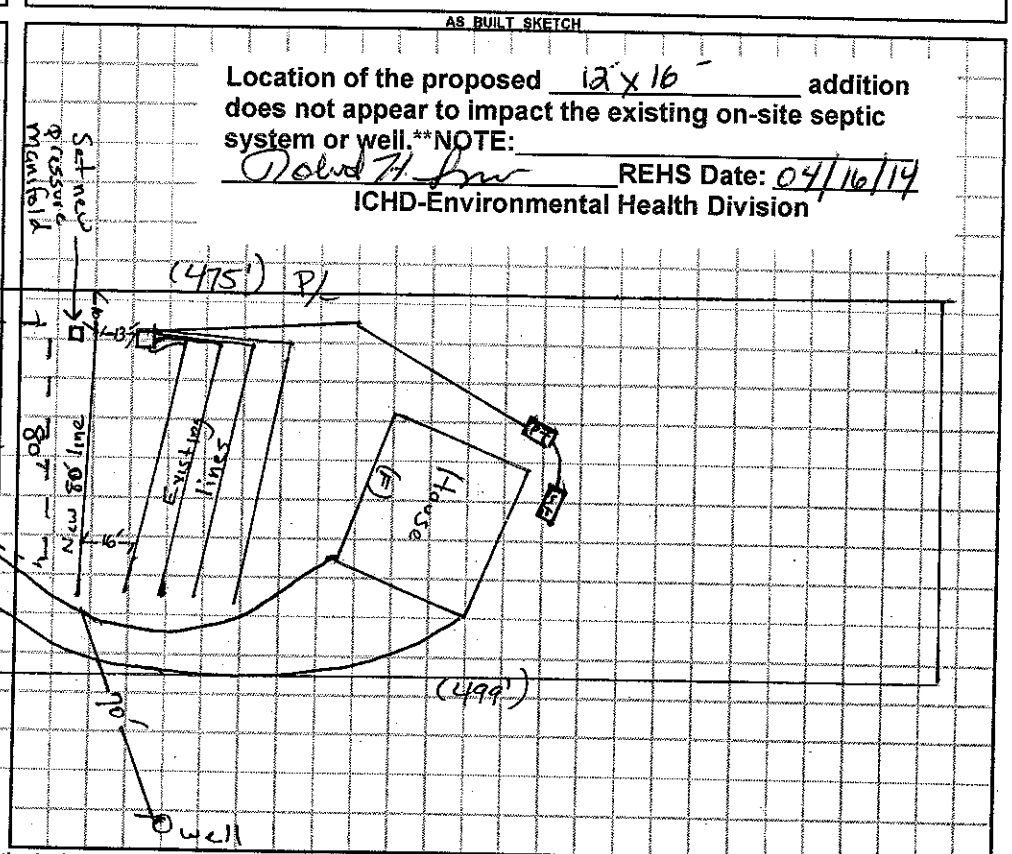

Permit can be suspended or revoked if any false information is supplied toward securing the permit / any unauthorized changes are made to the site / any unauthorized changes are made in the installation of the system. **CONTACT A LOCATOR SERVICE PRIOR TO ANY EXCAVATION**

☐ **IMPROVEMENT PERMIT** *with plat valid without expiration.* ☒ **IMPROVEMENT PERMIT** *with site plan valid for 60 mos.* ☒ **AUTHORIZATION TO CONSTRUCT** *valid for period equal to IMPROVEMENT PERMIT--not to exceed 60 mo.*

Owner / Applicant Signature: Donald Johnson Date: 3-20-14 Installed by:

IMPROVEMENT PERMIT by: David H Lee Date: 03/20/14 OPERATION PERMIT by: Date:

AUTHORIZATION TO CONSTRUCT by: David H Lee Date: 03/20/14 Existing System Inspected by: Date:

Health Dept. Copy - WHITE Applicant (Final Approval) - YELLOW Applicant (Conditional Approval) - PINK