IREDELL COUNTY HEALTH DEPARTMENT

STATESVILLE 704-878-5305 MOORESVILLE 704-664-5281

IMPROVEMENT PERMIT / CERTIFICATE OF COMPLETION / OPERATION PERMIT / EXISTING SYSTEM INSPECTION

PROPERTY DESCRIPTION NO. 25261 DATE 11-6-96 TAX MAP NO. 8R-A-1 (PART OF) Watershed: [ ] WS-IV [ ] No

OWNER OR CONTRACTOR KEJ MARKETING CO., INC PHONE: Business 847-6006 Home

ADDRESS P.O. BOX 1627 MATHEWS, NC 28106

LOCATION GARDNER POINT DRIVE, TR OAK POINT LANE, 1ST LOT ON LEFT

SUBDIVISION RIVERWALK BLOCK / SECTION V LOT 28 LOT AREA 1.058 ACRES SITE CLASS CS DESIGN FLOW 360 L.T.A.R. 0.30 GPD/FT²

Septic Tank: 1000 Gallons; SIB 1600 Date 7-19-00
Pump Tank: Gallons; PT Date
Pump Make: Model Serial No.
Nitrification Field: No Fields 1 Square Feet EQ. TO 1200 Linear Feet 300+
No Lines FOUR Trench Width 36" Max Trench Bottom Depth 36" Gravel Depth N/A

[✓] New System [ ] Repair System Type: I. II. III. IV. V. VI
System Description: CHAMBERED GRAVITY
Repair System Description: CHAMBERED GRAVITY
Maintenance Agreement Required: [ ] Yes [✓] No


[✓] House/Mod. Home No. Bedrooms 3
[ ] Mobile Home No. Bathrooms 2
[ ] Business No. Employees
[ ] Other
[ ] Slab [ ] Crawl Space [✓] Basement w/plumbing [ ] Basement wo/plumbing

Water Supply: [✓] Individual [ ] Community [ ] Public WELL

Comments: ① KEEP SYSTEM MINIMUM 100' FROM WELL SITE ② USE THREE FLOW DIVIDER TEES TO ACHIEVE EQUAL DISTRIBUTION INTO EACH OF FOUR LINES ③ INSTALL 52 CHAMBERS IN FOUR EQUAL LENGTH LINES.

Comments:

INITIAL SITE SKETCH SCALE: 1" = 50'

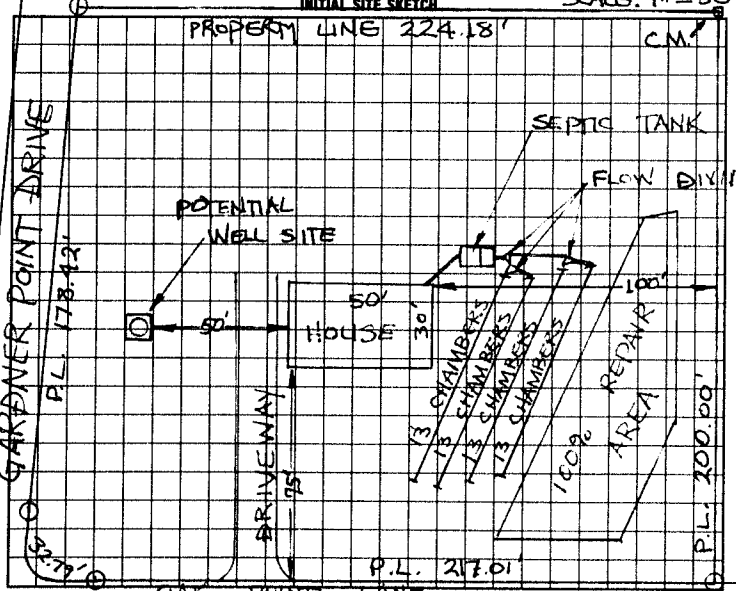

AS BUILT SKETCH

SYSTEM INSTALLED ACCORDING TO INITIAL SITE SKETCH

(HOUSE & WELL LOCATED DIFFERENTLY)

I understand that this permit can be suspended or revoked if any false information is supplied toward securing the permit/any unauthorized changes are made to the site/any unauthorized changes are made in the installation of the system.

Auth. to Const. is valid for a period equal to the validity of the IP not to exceed five years. IP w/site plan is valid five years.

Signed:

Improvement Permit by: STEVE HEDRICK date 11-6-96

Authorization to Construct by: STEVE HEDRICK date 11-6-96

Installed by: SHANE JARRETT

Certificate of Completion by: STEVE HEDRICK date 8-31-00

Operation Permit by: date

HEALTH DEPT. COPY: WHITE INSPECTION COPY (FINAL): GREEN OWNER COPY (FINAL): YELLOW INSPECTION COPY (INITIAL): PINK OWNER COPY (INITIAL): GOLD