IREDELL COUNTY HEALTH DEPARTMENT

Statesville Office (704) 878-5305 Mooresville Office (704) 660-3625 PERMIT # 218461 ~~217576~~

IMPROVEMENT PERMIT / AUTHORIZATION TO CONSTRUCT / OPERATION PERMIT / EXISTING SYSTEM

PIN # 3774939767

APPLICANT: Antul Ersek APPLICANT ADDRESS: 183 Edgington St Mooresville NC 28117

SITE ADDRESS: 343 Gardner Point Dr Stony Point NC PHONE: 315-380-8287 ALT. PHONE: 315-380-8287

SITE DIRECTIONS: 40W T/R Shaven School Rd T/L Stewart Rock Rd T/L Fulbright T/R Gardner Point Dr lot on left

SUBDIVISION: Riverwalk SECTION: 58 LOT # 2 LOT AREA: 1.6 Ac DESIGN FLOW: 240 L.T.A.R.: 0.3

Septic Tank 1000 (gal) STB 160 Date 4/20/16
Pump Tank (gal) PT Date
Pump Make Model Serial #
Nitrification Fields 1 # Lines 3 Linear Ft: 200
Trench Width 36" Trench Bottom Depth 36" Gravel Depth N/A


[X] New System [ ] Repair [ ] Expansion System Type: I II [III] IV V VI
System Description: 25% reduction
Repair System Description: 50% reduction
Maintenance Agreement Required: [ ] YES [X] NO
[X] GRAVITY [ ] PRESSURE

[X] Residence No. Bedrooms 2
[ ] Business No. Persons 4
[ ] Other No. Employees
[X] Slab [ ] Crawl Space
[ ] Basement w/plumbing [ ] Basement w/o plumbing


Water Supply: [X] Private [ ] Public [ ] Community

Comments / Conditions: Install 25% reduction on contour with Serial distribution ~~&~~ maintain 36" TD on high side~~x~~

INITIAL SITE SKETCH

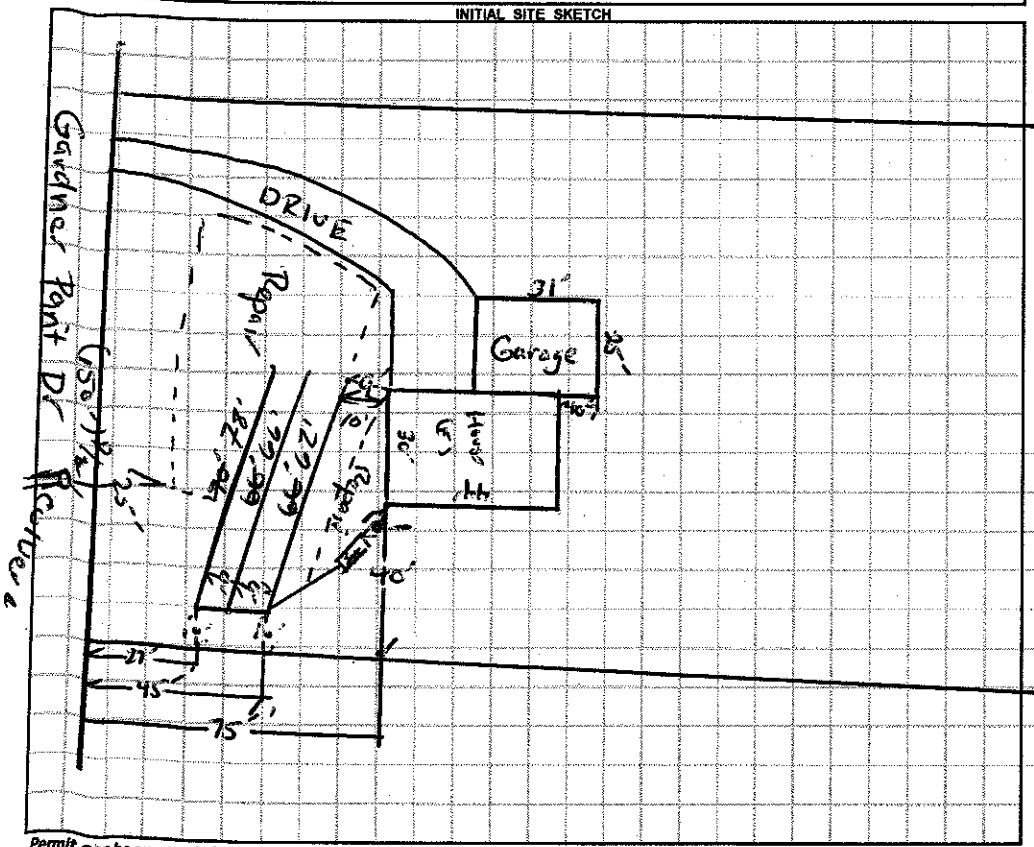

AS BUILT SKETCH

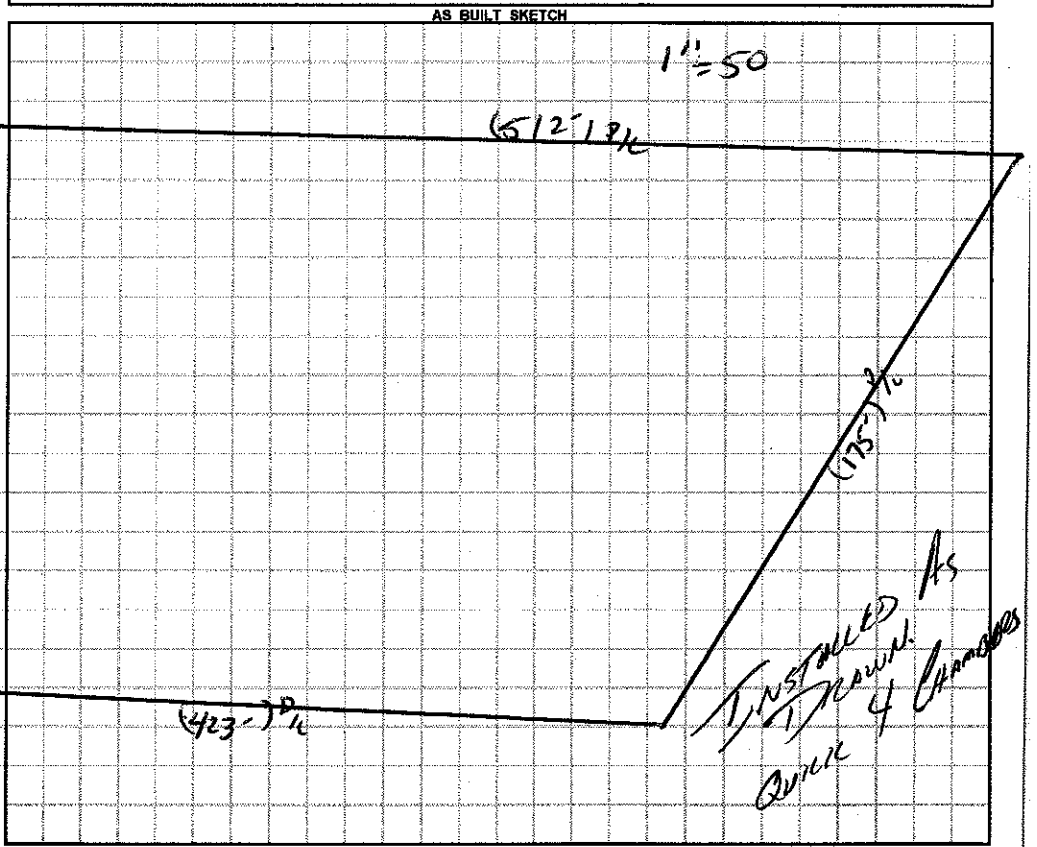

Permit can be suspended or revoked if any false information is supplied toward securing the permit / any unauthorized changes are made to the site / any unauthorized changes are made in the installation of the system. **CONTACT A LOCATOR SERVICE PRIOR TO ANY EXCAVATION**

[ ] **IMPROVEMENT PERMIT** *with plat* valid without expiration. [X] **IMPROVEMENT PERMIT** *with site plan* valid for 60 mos. [X] **AUTHORIZATION TO CONSTRUCT** valid for period equal to IMPROVEMENT PERMIT--not to exceed 60 mo.

Owner / Applicant Signature: Date: Installed by: K & B Grading

IMPROVEMENT PERMIT by: Date: 04/28/16 OPERATION PERMIT by: Date: 7/18/16

AUTHORIZATION TO CONSTRUCT by: Date: 04/28/16 Existing System Inspected by: Date:

Health Dept. Copy - WHITE Applicant (Final Approval) - YELLOW Applicant (Conditional Approval) - PINK