(EV) Replaces Permit issued 8-9-97

IREDELL COUNTY HEALTH DEPARTMENT

STATESVILLE 704-878-5305 MOORESVILLE 704-664-5281

IMPROVEMENT PERMIT / AUTHORIZATION TO CONSTRUCT / OPERATION PERMIT / EXISTING SYSTEM INSPECTION

PERMIT# 13952 | PIN# 3774-93-9973 Grews | DATE 2 February 07

OWNER OR APPLICANT County Road Builders / Howard Grews | PHONE: Business 704-857-6138 Home/Cell 704-791-4182

ADDRESS 1630 N. Main St. China Grove, N.C. 28023

LOCATION 335 Gardner Point Dr. / I40 - Turn Sharon School rd. TL Stewart Rd. Rt. TL Fulbright - TR Gardner Point - Lot on left.

SUBDIVISION Riverwalk | BLOCK / SECTION 8 | LOT 3 | LOT AREA 1.92 ac. | SITE CLASS. PS | DESIGN FLOW 360 gpd | L.T.A.R. 0.3 gpd/ft²/day

Septic Tank: 1000 Gallons; STB 791 Date 2-26-08
Pump Tank: ____ Gallons; PT ____ Date ____
Pump Make: ____ Model ____ Serial No. ____
Nitrification Field: No Fields 1 Square Feet 1200 Linear Feet 300
No Lines 3 Trench Width 36" Max Trench Bottom Depth 33" Gravel Depth NA

☑ New System ☐ Repair ☐ Expansion System Type: I II III IV V VI
System Description: 25% Reduction
Repair System Description: 25% Reduction
Maintenance Agreement Required: ☐ Yes ☑ No

☑ House/Mod. Home ☐ Mobile Home ☐ Business ☐ Other
No. Bedrooms 3 No. Persons ____ No. Employees ____


Water Supply: ☑ Individual ☐ Public ☐ Community

☑ Gravity ☐ Pressure ☐ Slab ☐ Crawl Space ☑ Basement w/plumbing ☐ Basement wo/plumbing


Comments:/Conditions: Follow contour - Max trench depth 33" / use 3 drop-boxes

Comments:/Conditions: Polylock filter
End Panel - To-end panel distribution.
Install as 4 Lines in trench
Quick-4

INITIAL SITE SKETCH Scale 1" = 100'

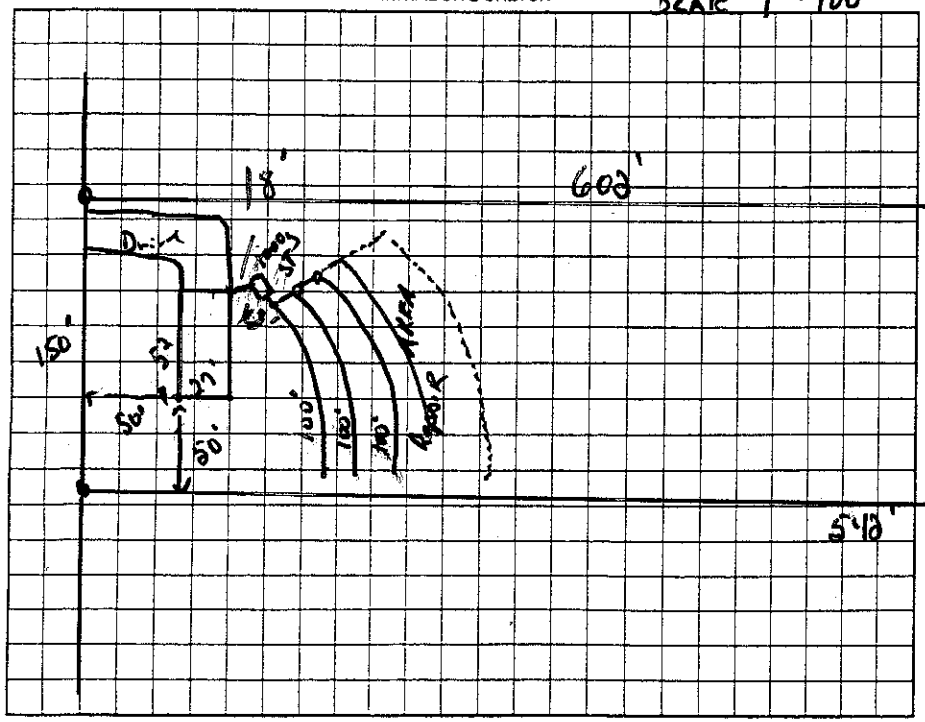

AS BUILT SKETCH

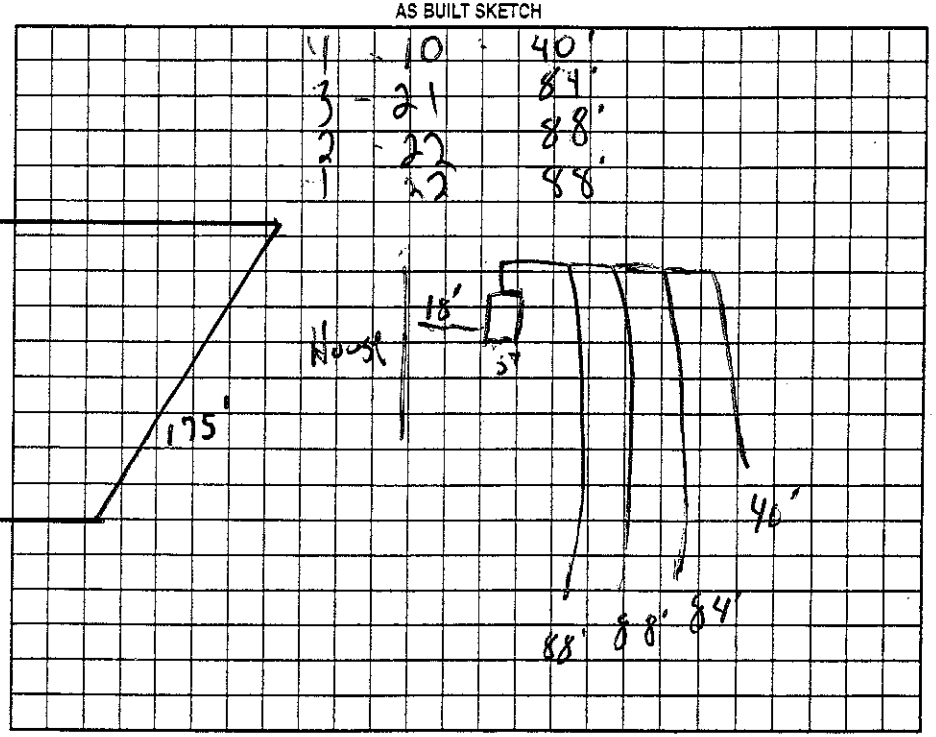

Permit can be suspended or revoked if any false information is supplied toward securing the permit/any unauthorized changes are made to the site/any unauthorized changes are made in the installation of the system. Improvement Permit with plat valid without expiration ☐ Improvement Permit with site plan valid for sixty months ☑ Authorization to Construct is valid for a period equal to that of Improvement Permit – not to exceed sixty months.

Signed: _____ date 2-26-07
Improvement Permit by: _____, R.S. date 2 Feb. 07
Authorization to Construct by: _____, R.S. date 2 Feb. 07

Installed by: Piedmont Septic Tank
Operation Permit by: _____, R.S. date 2 June 08
Existing System Inspection by: _____ date _____

HEALTH DEPT. COPY: WHITE OWNER COPY (FINAL): YELLOW OWNER COPY (INITIAL): PINK